




- Air Inlets
- Fans
- Exhaust Air
- Abandoned Area
- Working Area
- Roads
- 2 Escapeways
- 2 Entrys

● PROPOSED DRILL HOLES

REVISED NOV. 19, 1976

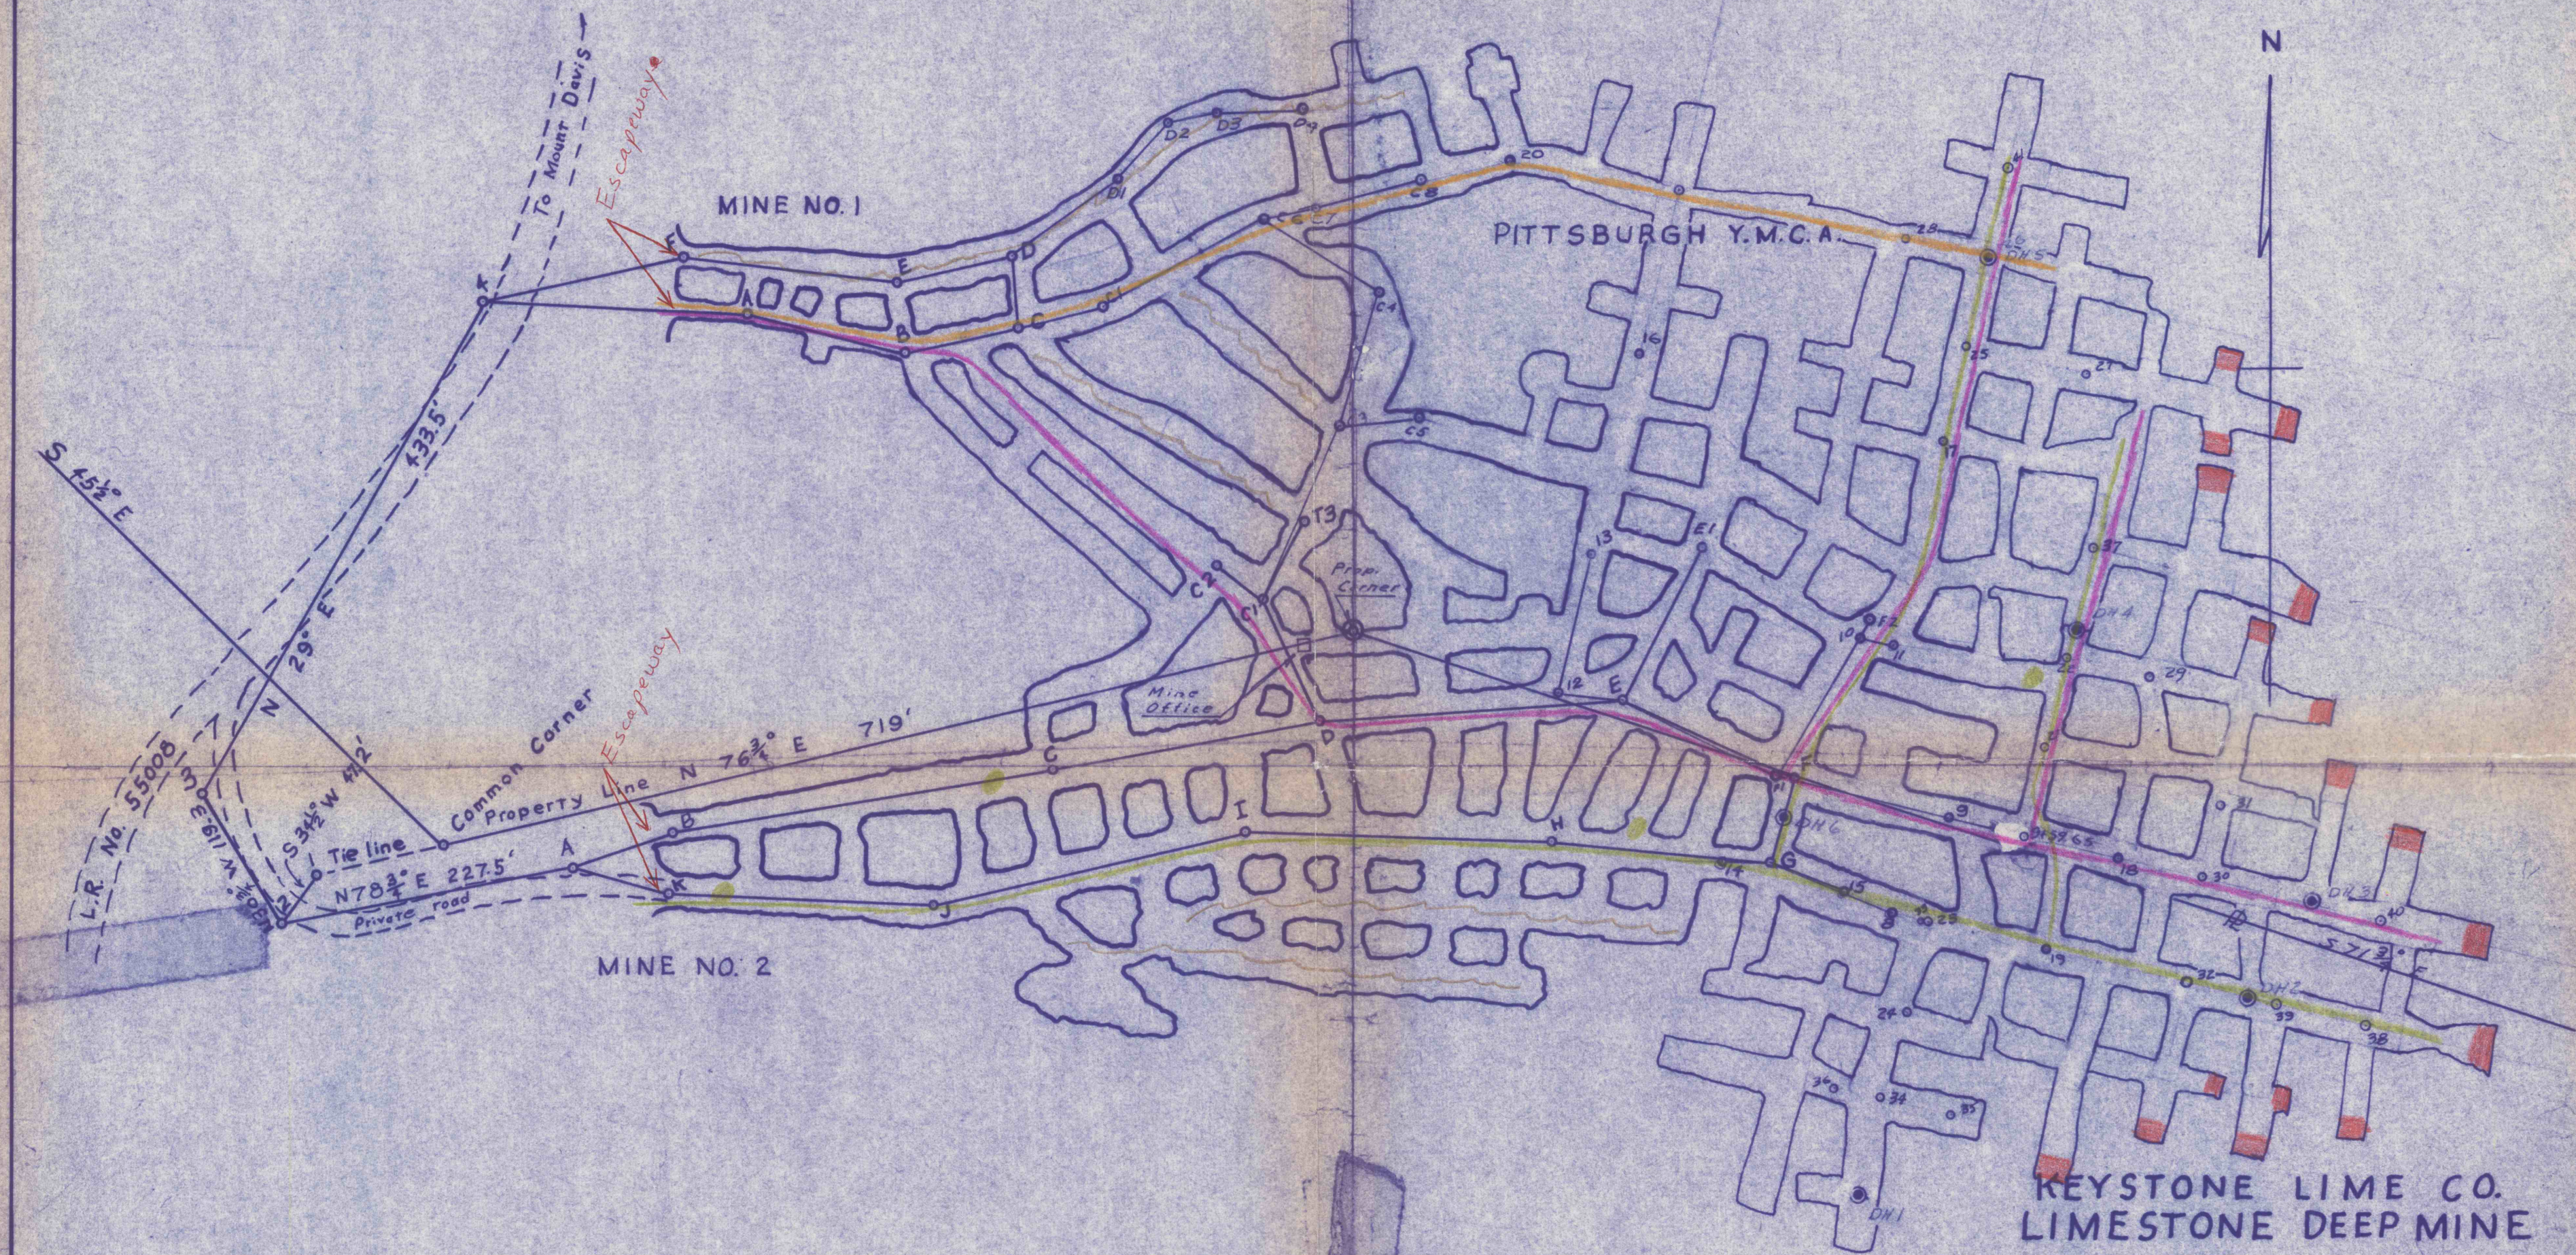

KEystone LIME CO.
LIMESTONE DEEP MINE

SITUATE IN EJK LICK TOWNSHIP
SOMERSET COUNTY, PENNA.

SURVEYED BY B. E. MILLER
JUNE 1964
REVISED NOVEMBER 1965
REVISED July 1967
SCALE 1" = 100'
REVISED FEB. 1968
REVISED MARCH 1969
" DEC. 24, 1970
" DEC. 24, 1971
" JUNE 22, 1973
" NOV. 14, 1974
" NOV. 21, 1975

rec'd cmh
5/10/77

9004