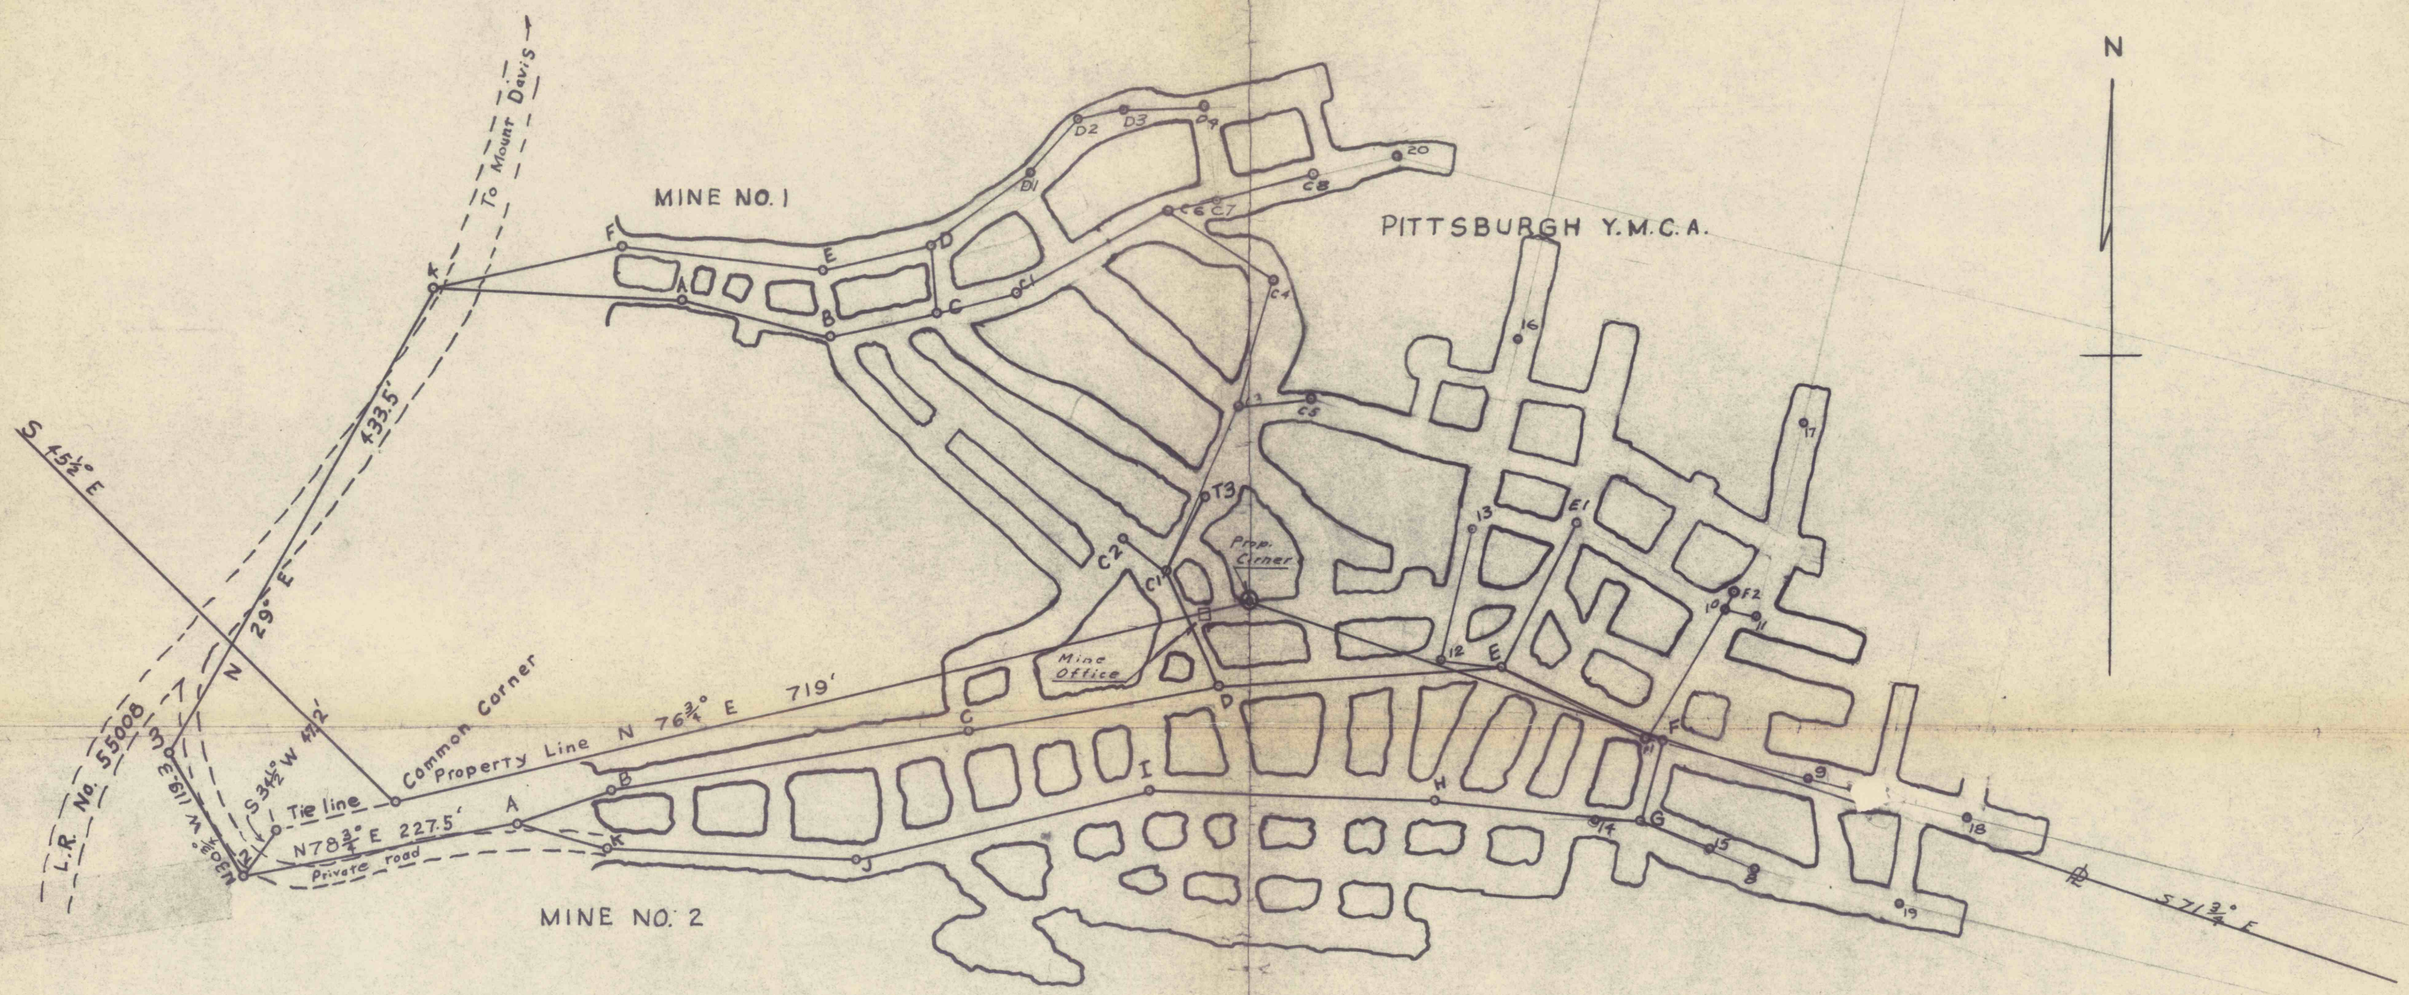

KEYSTONE LIME CO.
LIMESTONE DEEP MINE

SITUATE IN EJK LICK TOWNSHIP
SOMERSET COUNTY, PENNA.

SURVEYED BY B. E. MILLER
JUNE 1964
REVISED NOVEMBER 1965
REVISED July 1967
SCALE 1" = 100'
REVISED FEB. 1968
REVISED MARCH 1969
DEC. 24, 1970

COMMONWEALTH OF PENNSYLVANIA
REGISTERED
BLAINE E. MILLER
SURVEYOR
No. 13177-E

LABOR AND INDUSTRY
MINES QUARRIES
MAR 5 1971

2008