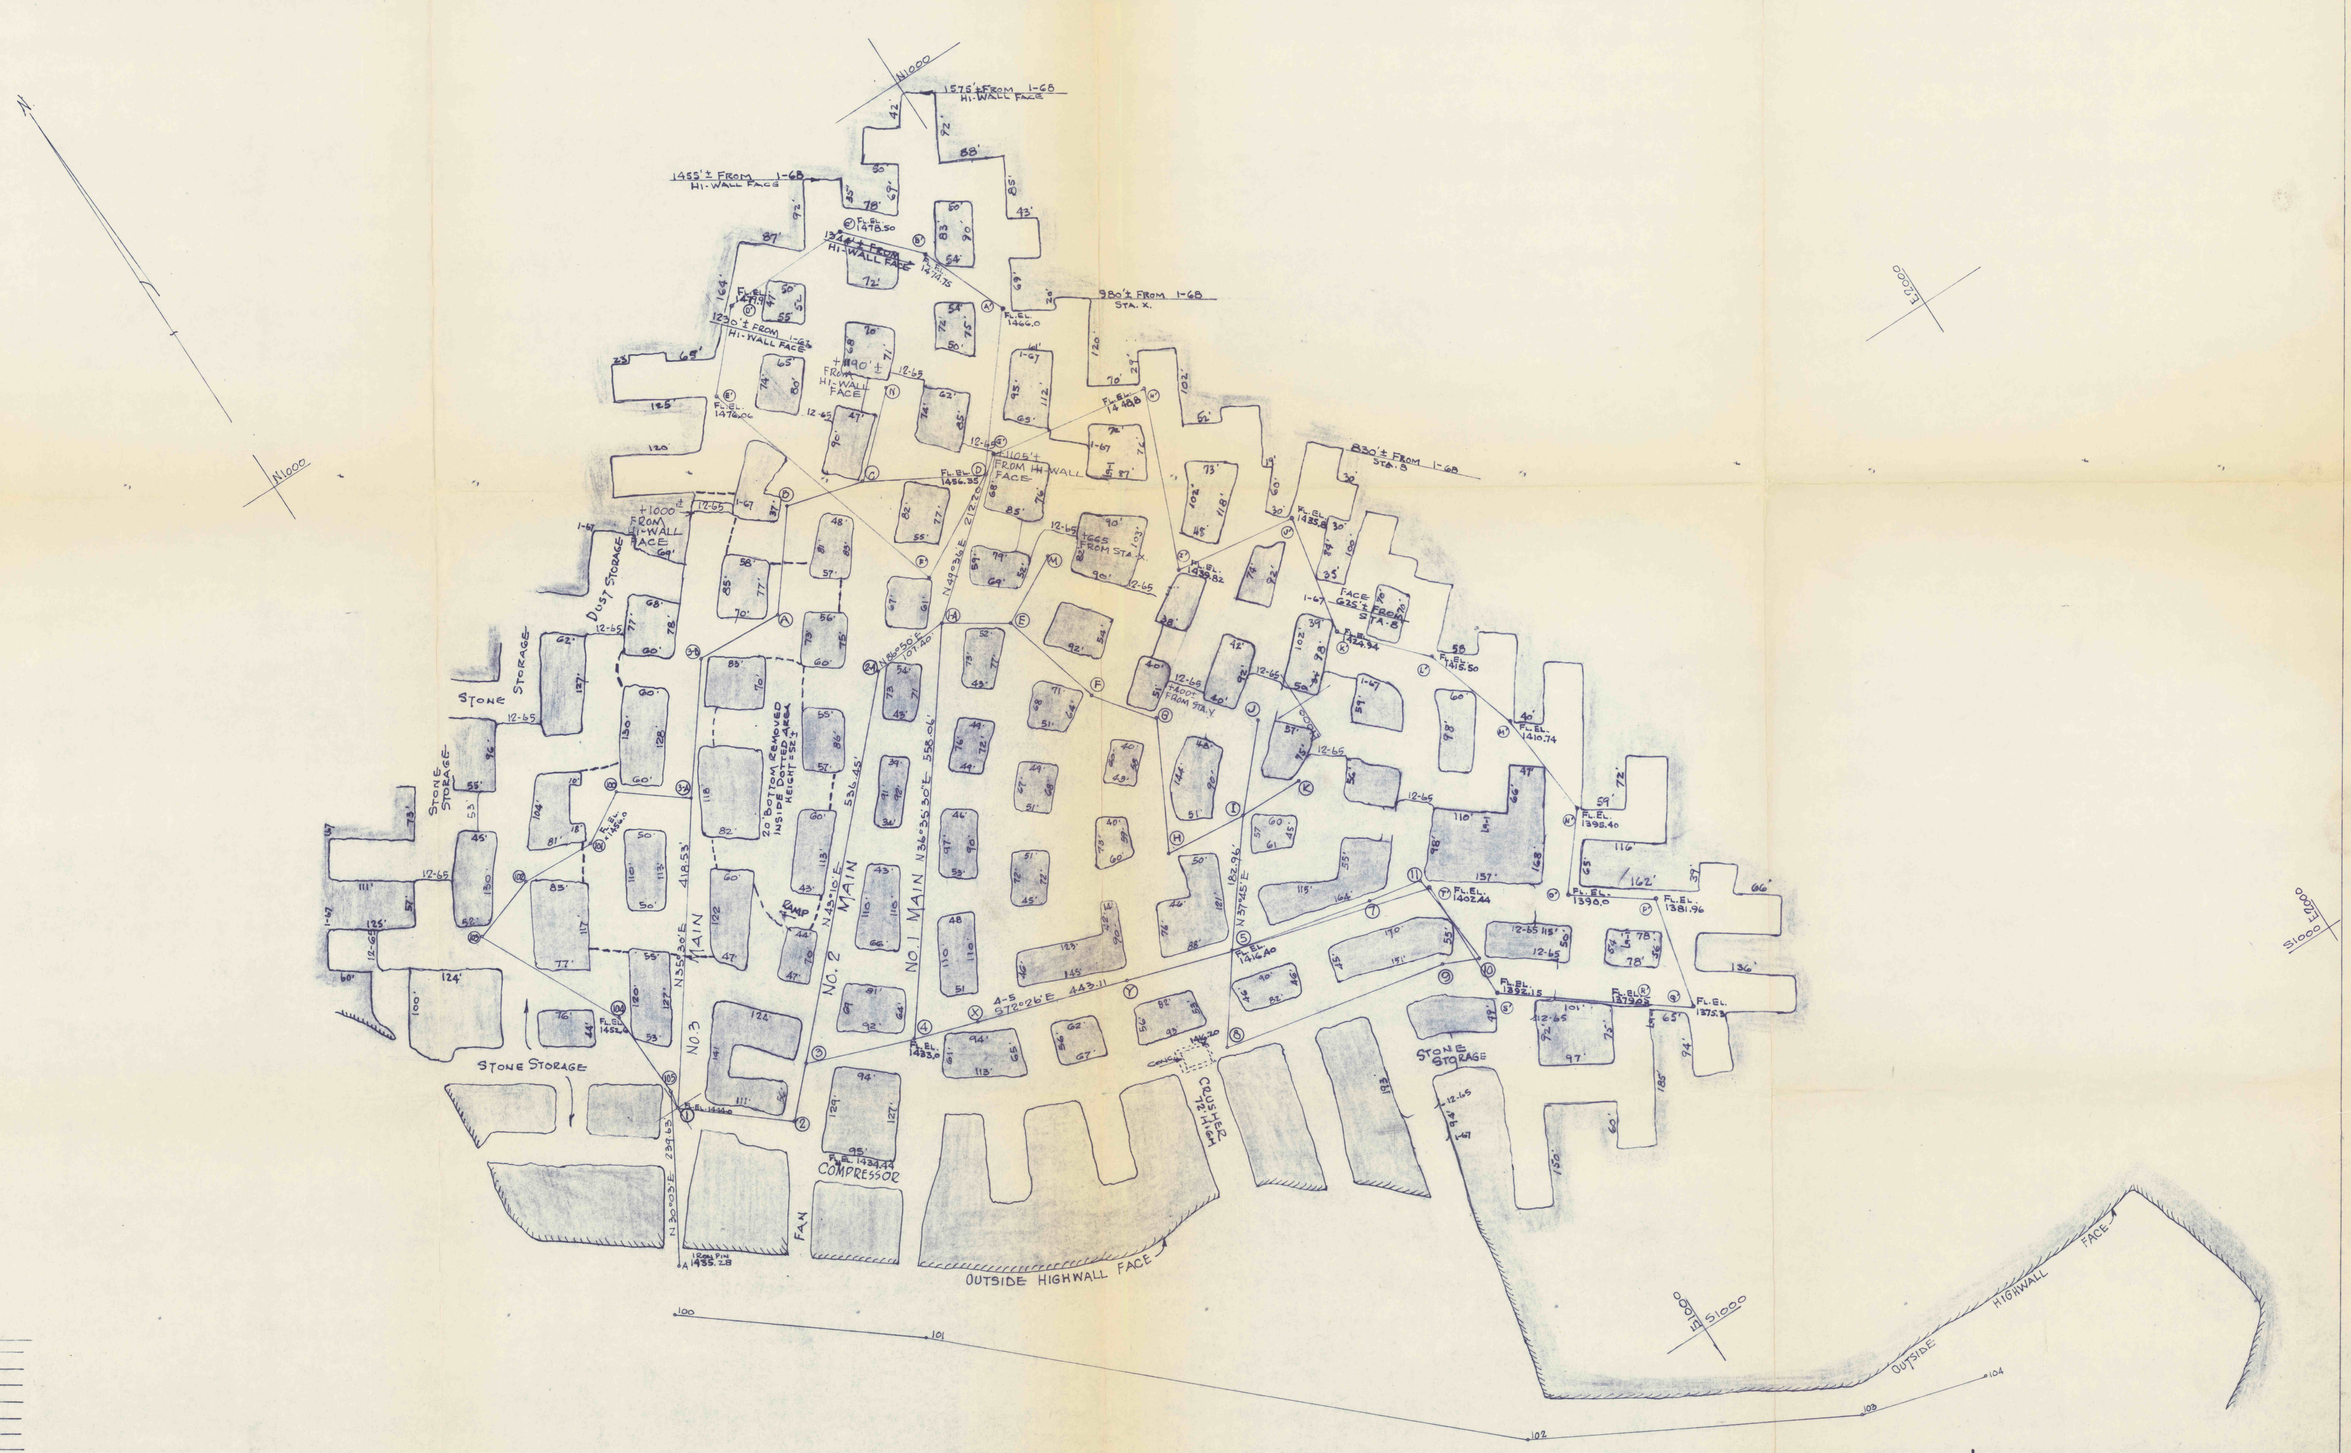

SURVEY DATES

MAY 1964
FEBRUARY 1965
DECEMBER 1965
JANUARY 1966
JANUARY 1967
JANUARY 1968

ROOM HEIGHTS 29'-31'

FL.EL. = FLOOR ELEVATION

AREA MINED 1966

COMMONWEALTH OF PENNSYLVANIA
REGISTERED PROFESSIONAL
GEORGE GERA
SURVEYOR
No. 671-E

LATROBE CONSTRUCTION CO.
LONGBRIDGE BLUE STONE
QUARRY & MINE
LIGONIER TWP.-WESTM'D. CO. PA.
SCALE: 1" = 100' FEB. 1965
GIBSON-THOMAS ENGINEERING CO.
LATROBE, PA

DWG GT 2813 DR-7-