



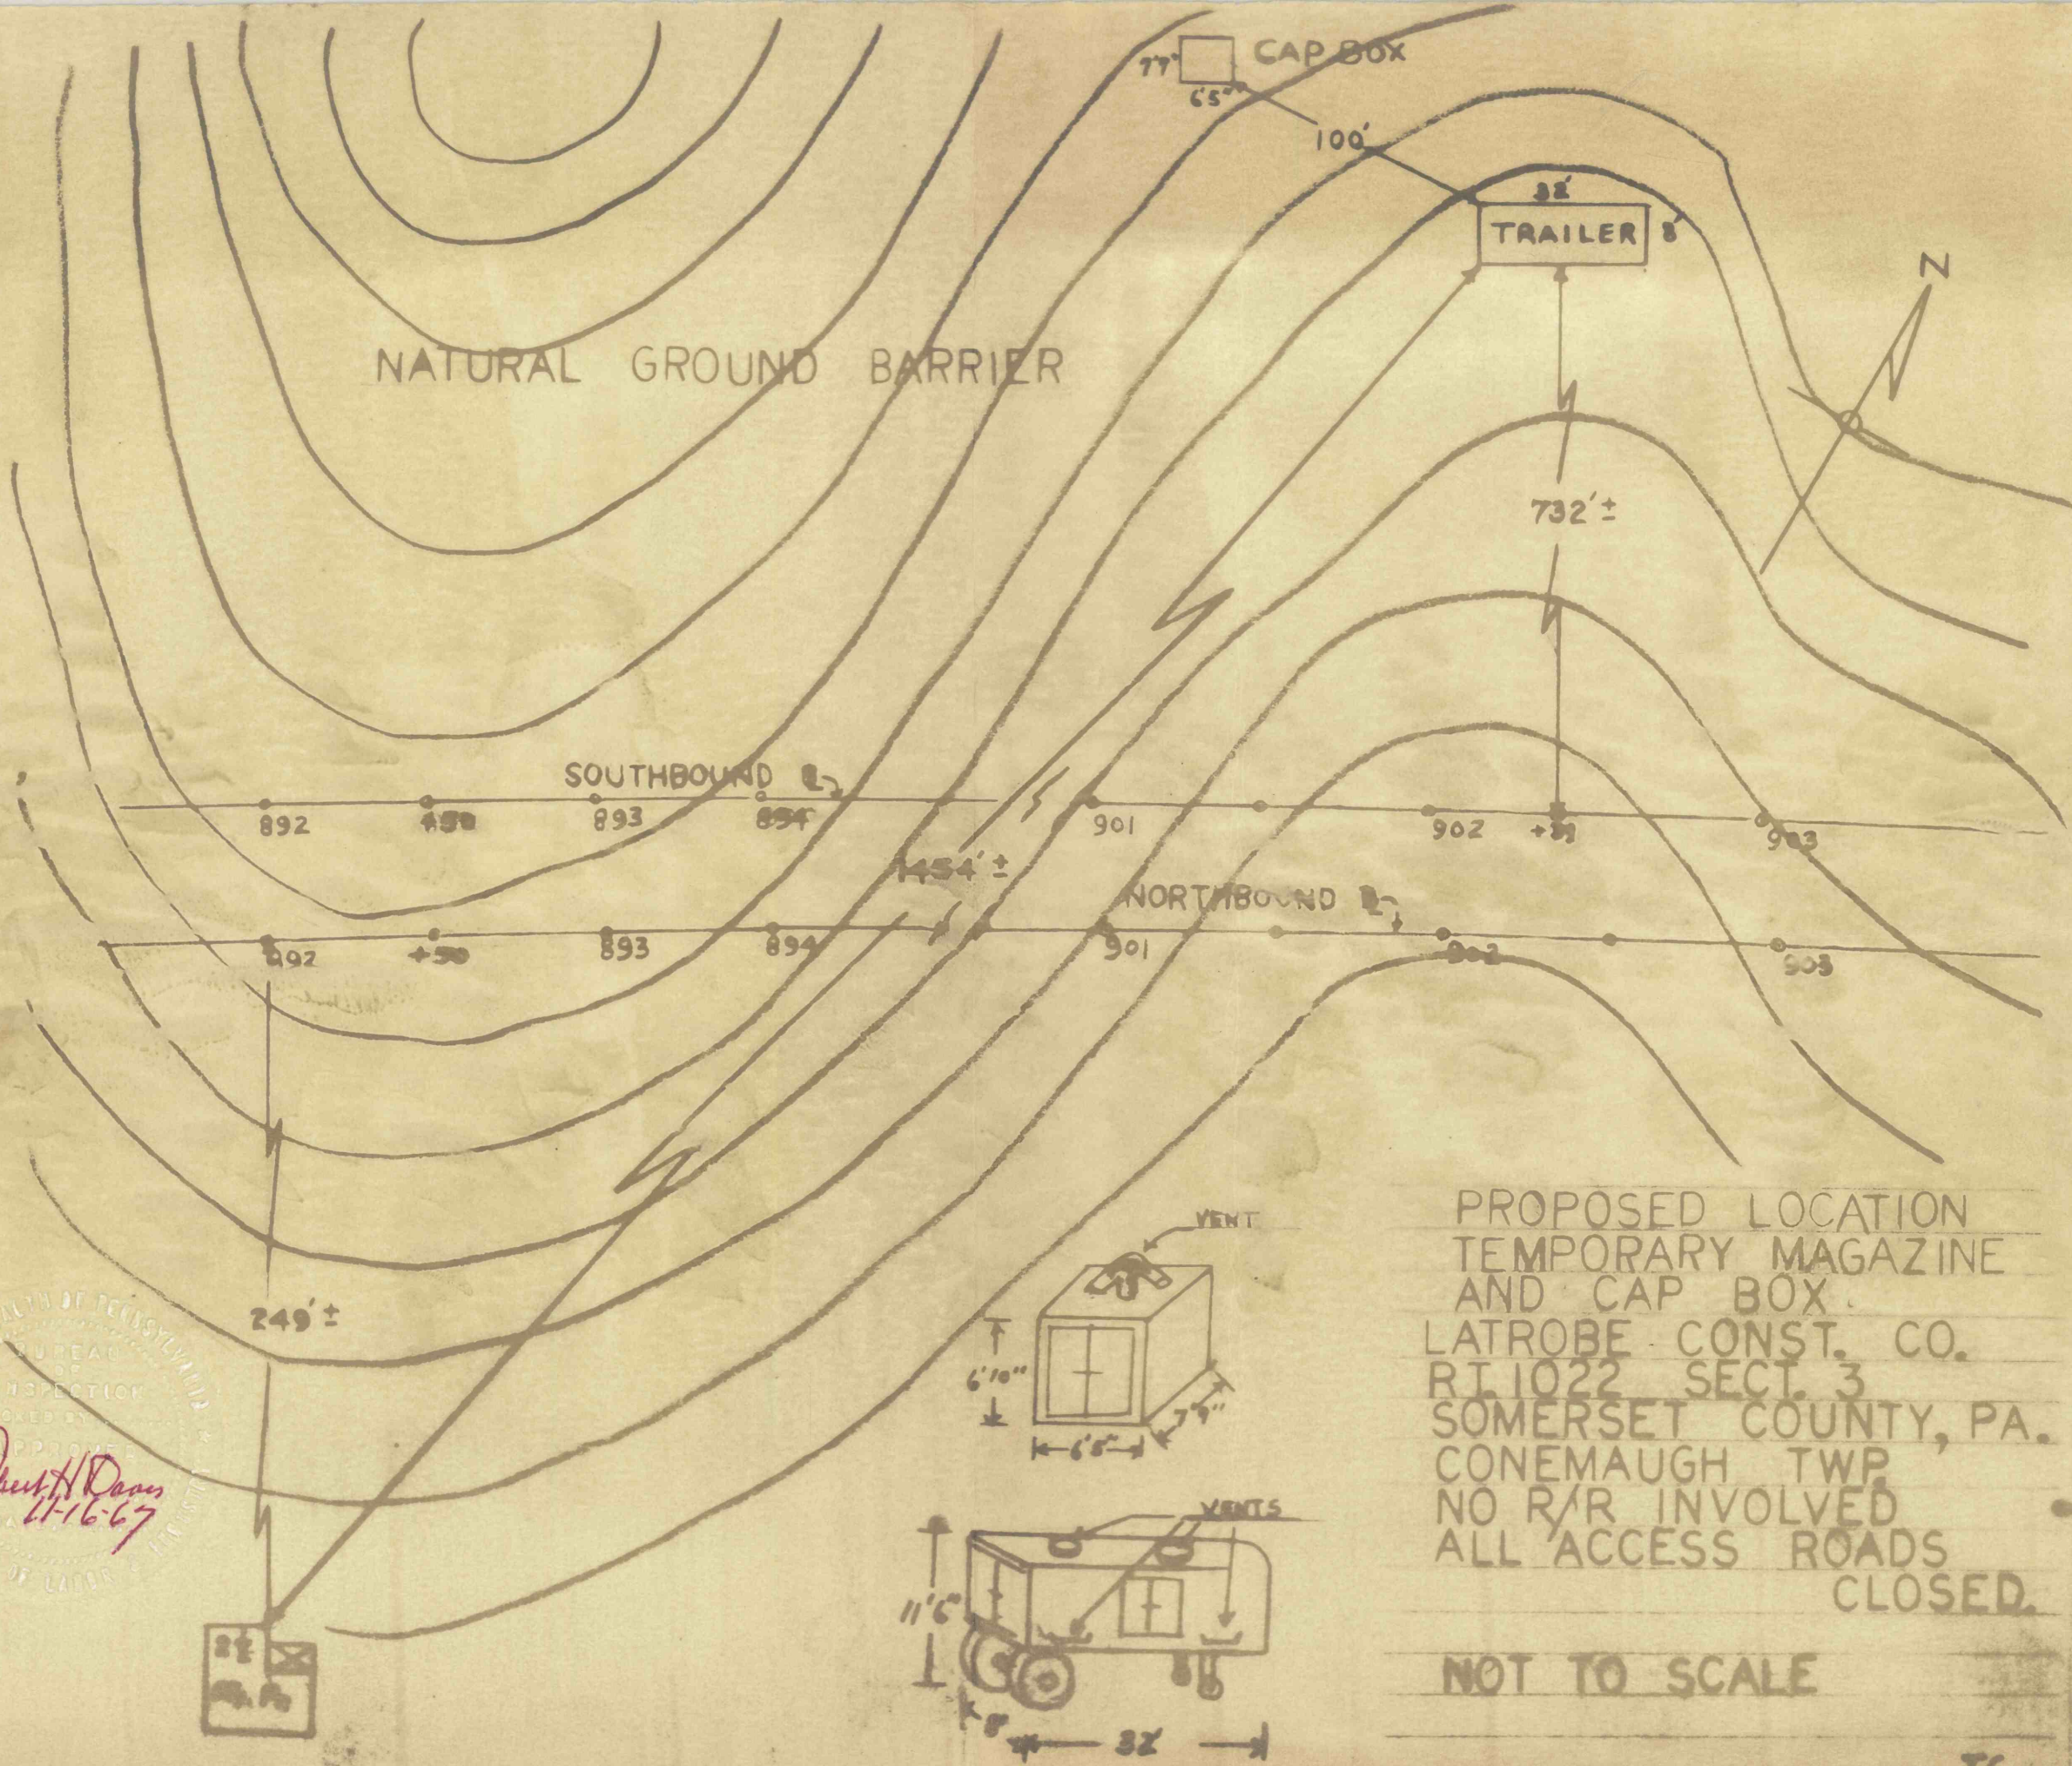

COMMONWEALTH OF PENNSYLVANIA
BUREAU OF INSPECTION
CHECKED BY
Robert H. Davis
2-16-67
DEPARTMENT OF LABOR

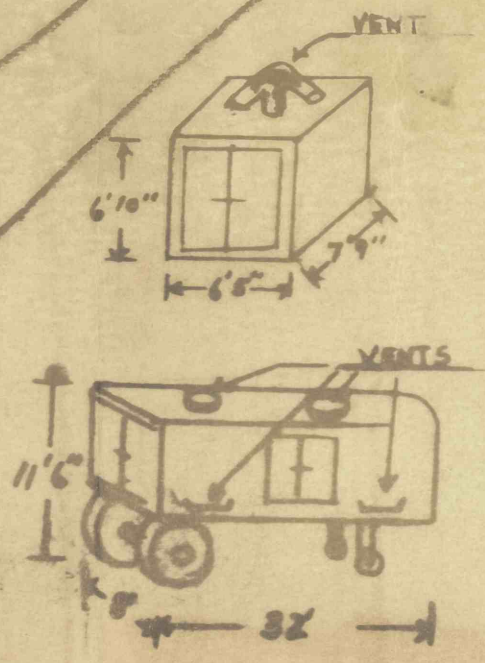

PROPOSED LOCATION
TEMPORARY MAGAZINE
AND CAP BOX.
LATROBE CONST. CO.
RT 1022 SECT. 3
SOMERSET COUNTY, PA.
CONEMAUGH TWP.
NO R/R INVOLVED
ALL ACCESS ROADS
CLOSED.

NOT TO SCALE

J.C.