


EEQC

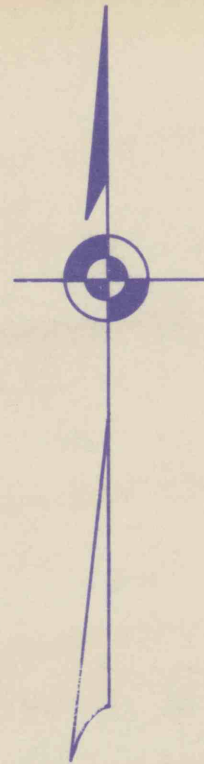

ORVILLE G. FLICK

M & M LIME CO.

FRANCIS BLANK

EDWARD C. LUTTON

ALPO


JOSEPH

LORENZETTI

COLOR SCHEME

	DIRECTION OF AIR CURRENTS
	EXTENT OF UNDERGROUND WORKINGS ON APR. 22, 1974
	" " " " MAY 5, 1975
	" " " " APR. 26, 1976

ELEVATIONS ARE SHOWN THUS (1162) BASED ON U.S.G.S. DATUM

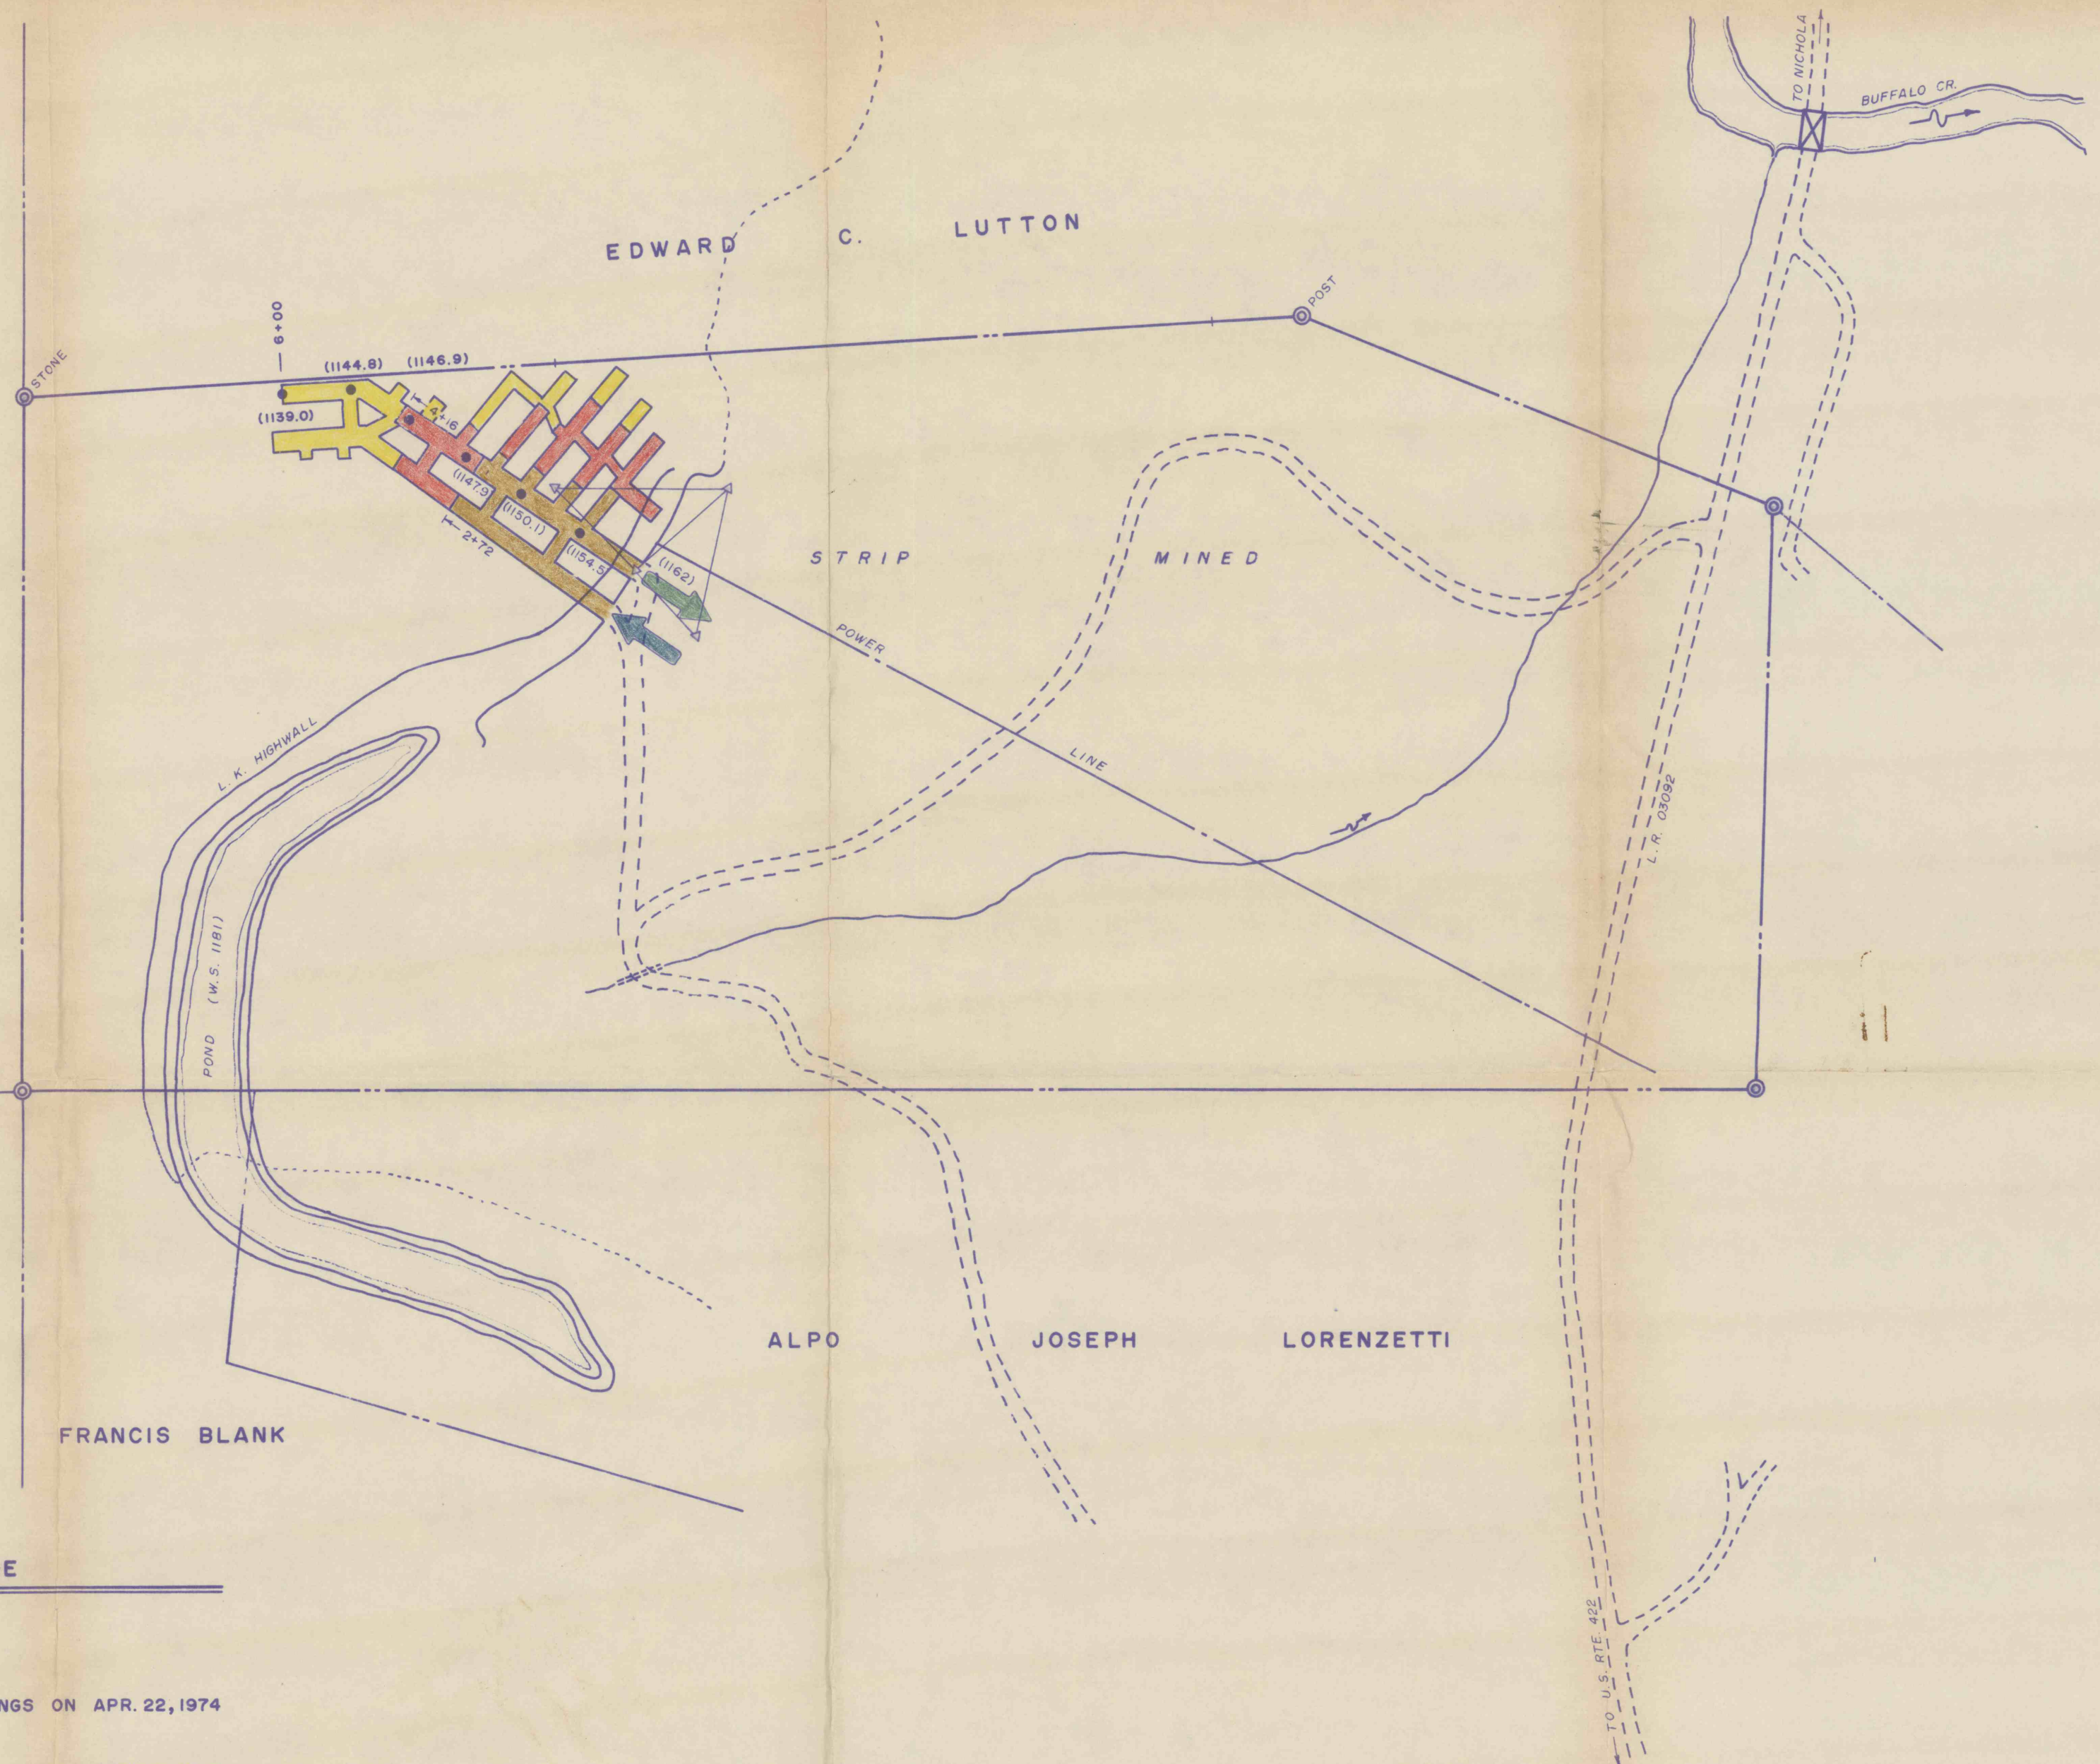

MAP OF
THE M & M LIME COMPANY MINE
WEST FRANKLIN TWP., ARMSTRONG CO.
PENNSYLVANIA

SURVEYED BY:
E. J. KUBATKO, JR. / CIVIL ENGINEERING ASSOCS.
KITTANNING PENNSYLVANIA
MAY, 1975

0 200 400 600 FT.