



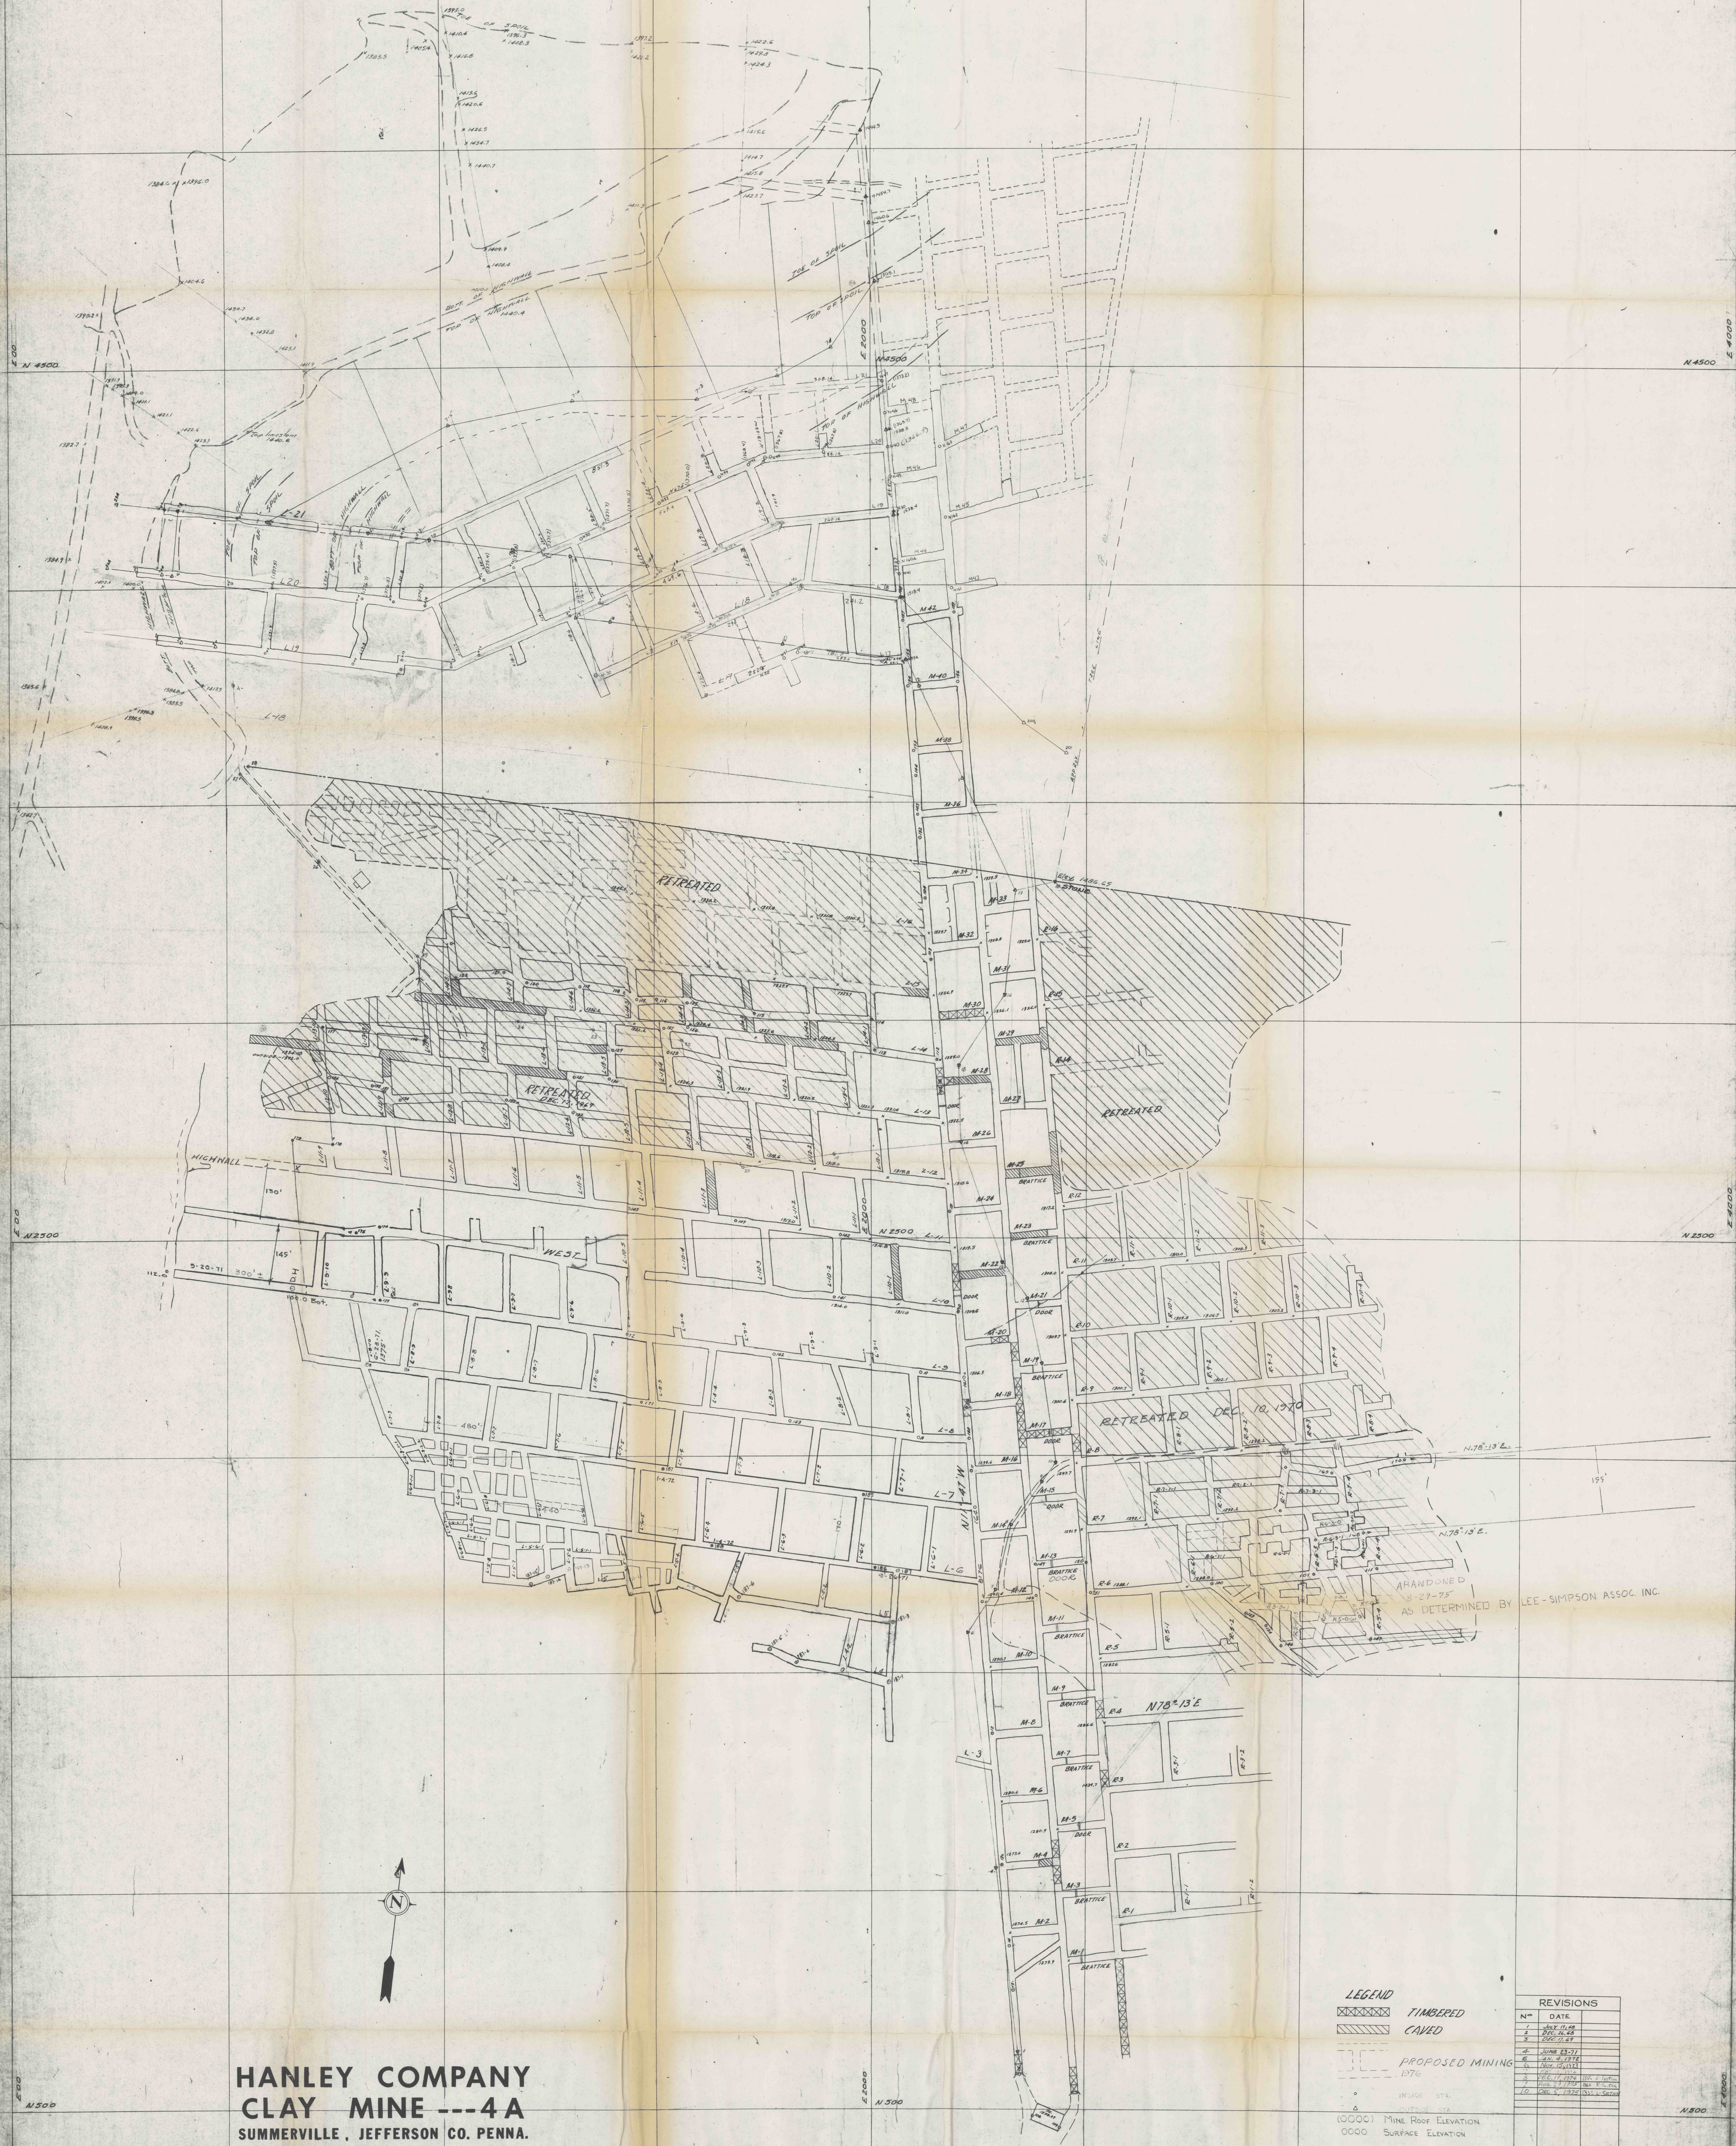

HANLEY COMPANY
CLAY MINE ---4A
SUMMERVILLE, JEFFERSON CO. PENNA.
SCALE 1"=100' JULY 17, 1968

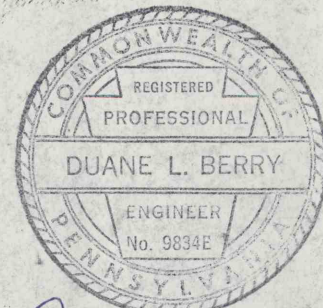

BY

[Signature]

YOST ASSOCIATES INC.
DUBOIS, PA.

LEGEND
TIMBERED
CAVED
PROPOSED MINING
1970
INJURY STA
OUTSIDE STA
0000 MINE ROOF ELEVATION
0000 SURFACE ELEVATION

REVSIONS	
N ^o	DATE
1	JULY 1968
2	AUG. 16. 68
3	DEC. 11. 68
4	JUNES 23. 71
5	AUG. 8. 1972
6	NOV. 12. 1973
7	MAR. 2. 1974
8	DEC. 17. 1974
9	JAN. 29. 1975
10	DEC. 5. 1975
	ISS. 2-1000
	ISS. 2-1000
	ISS. 2-1000