


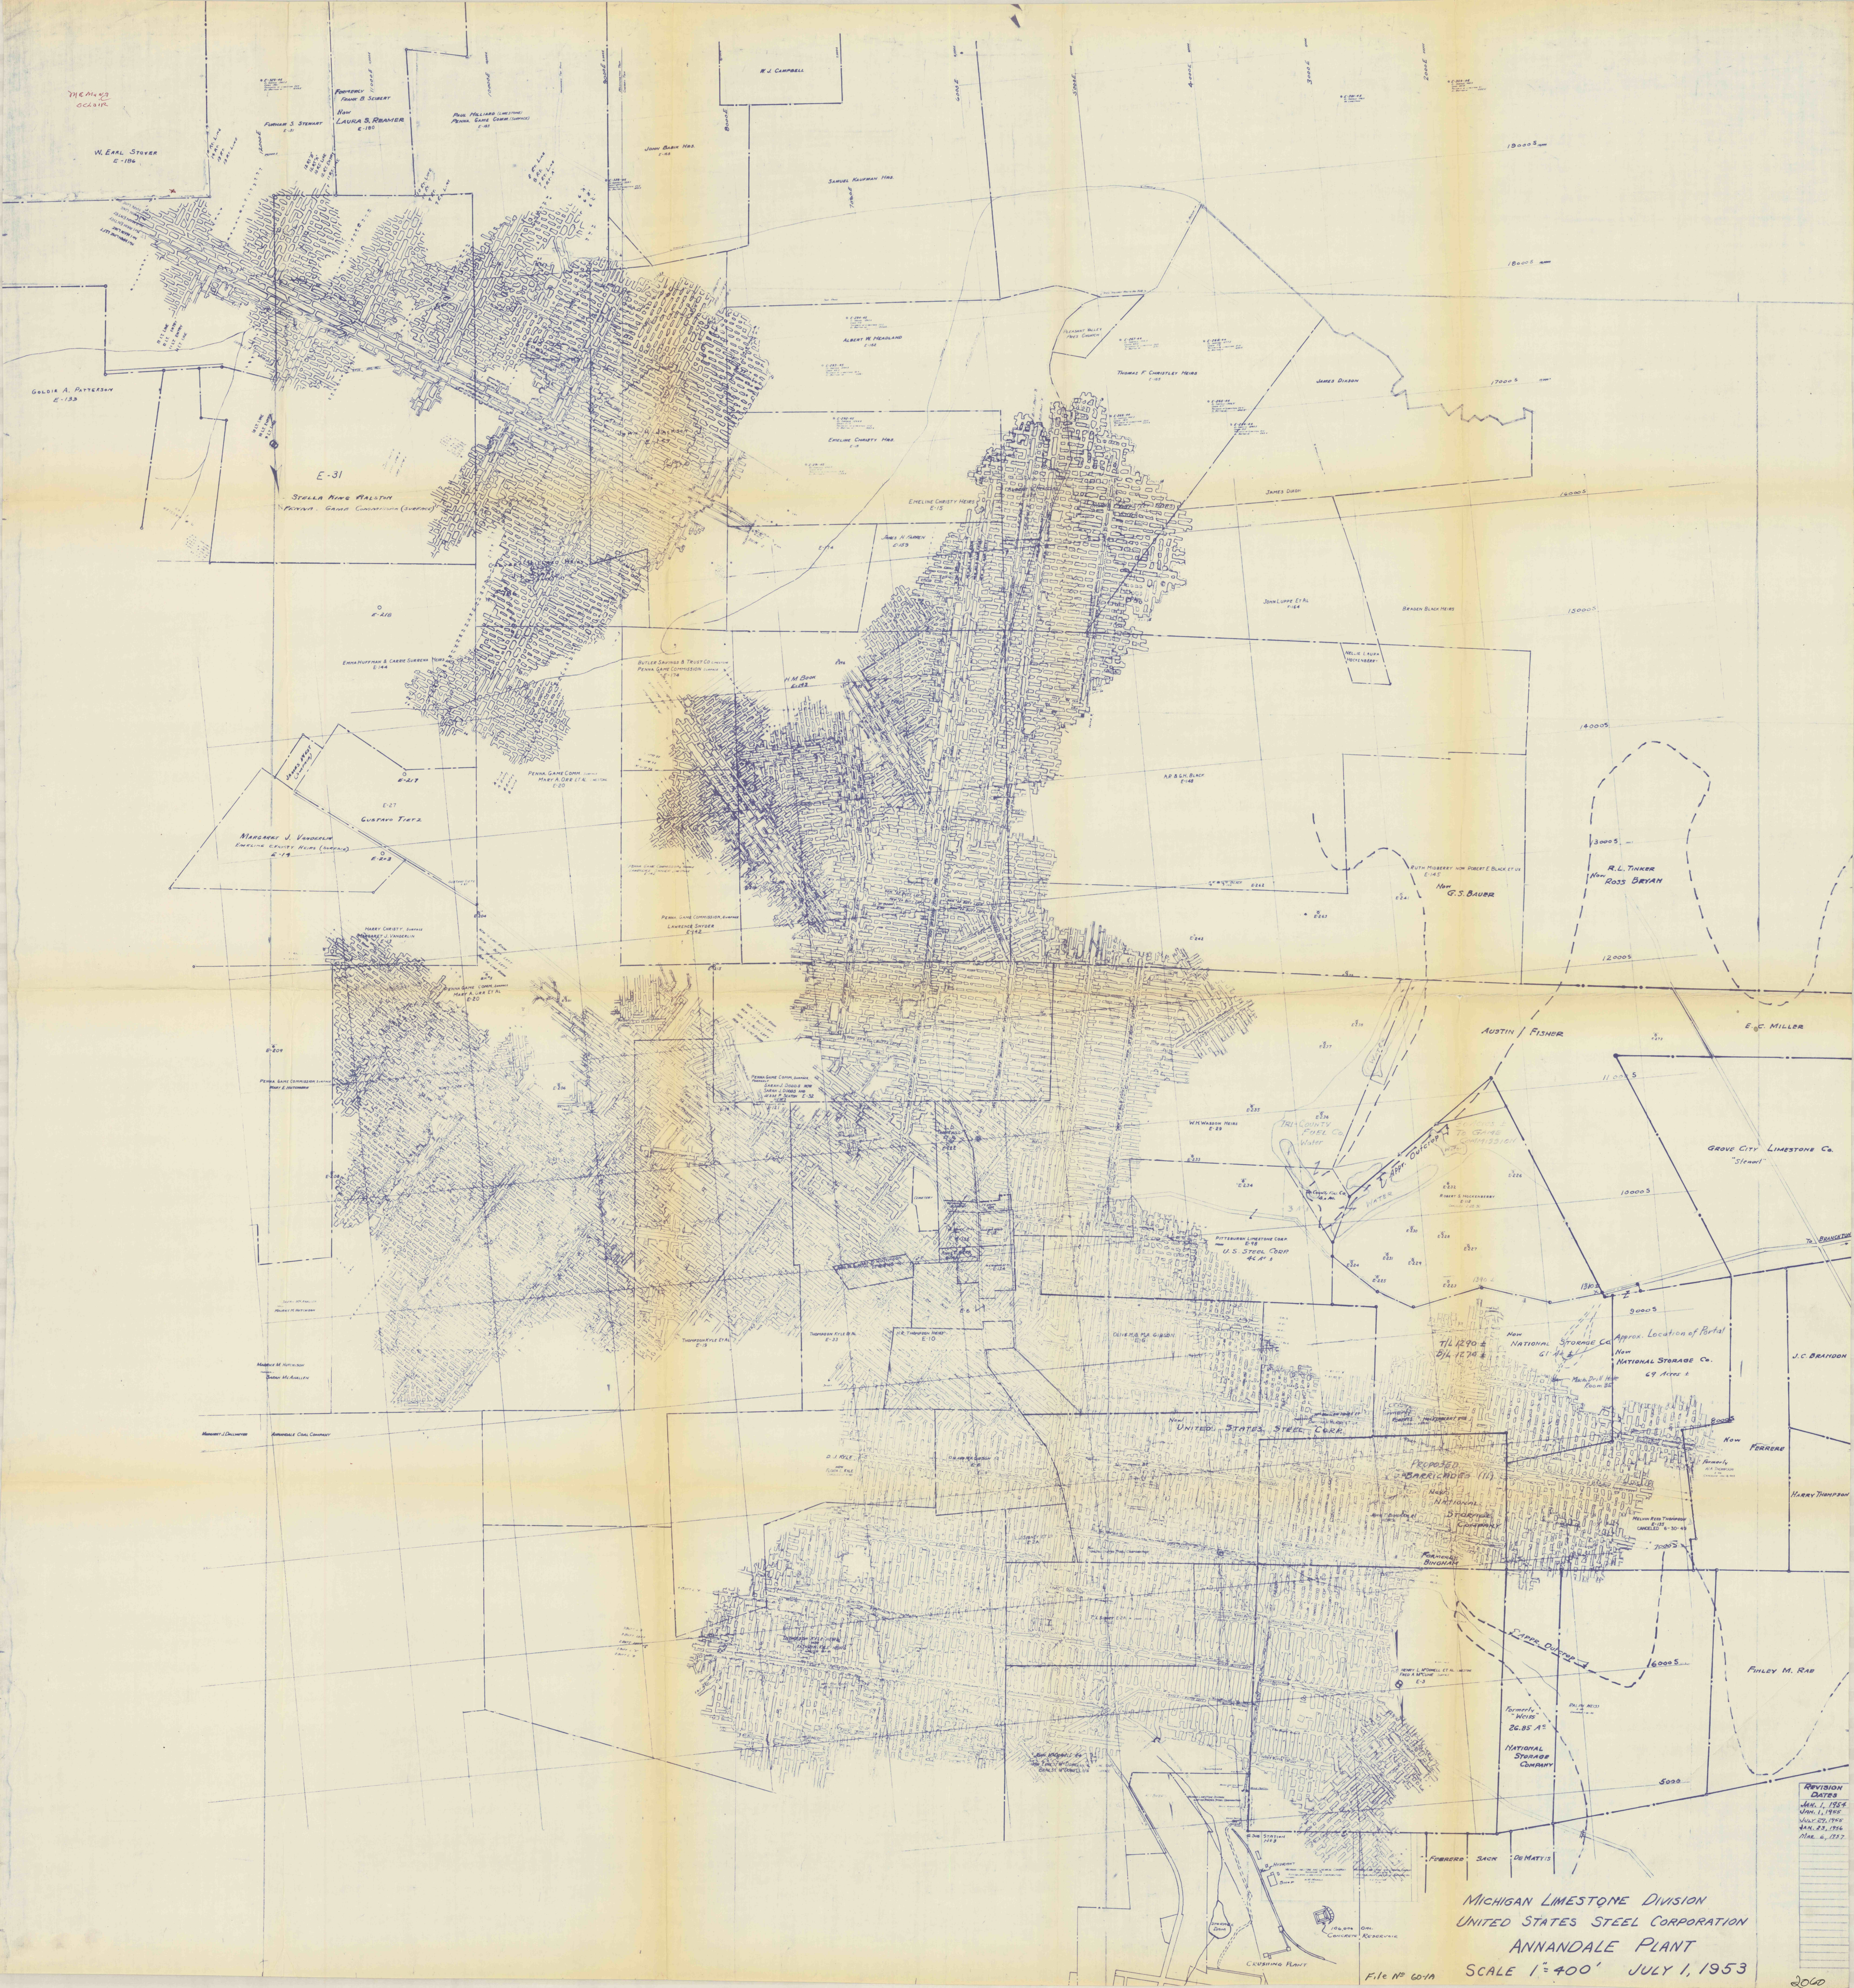

MICHIGAN LIMESTONE DIVISION
UNITED STATES STEEL CORPORATION
ANNANDALE PLANT

SCALE 1"=400' JULY 1, 1953
FILE NO 60-1A

REVISION	DATE
