


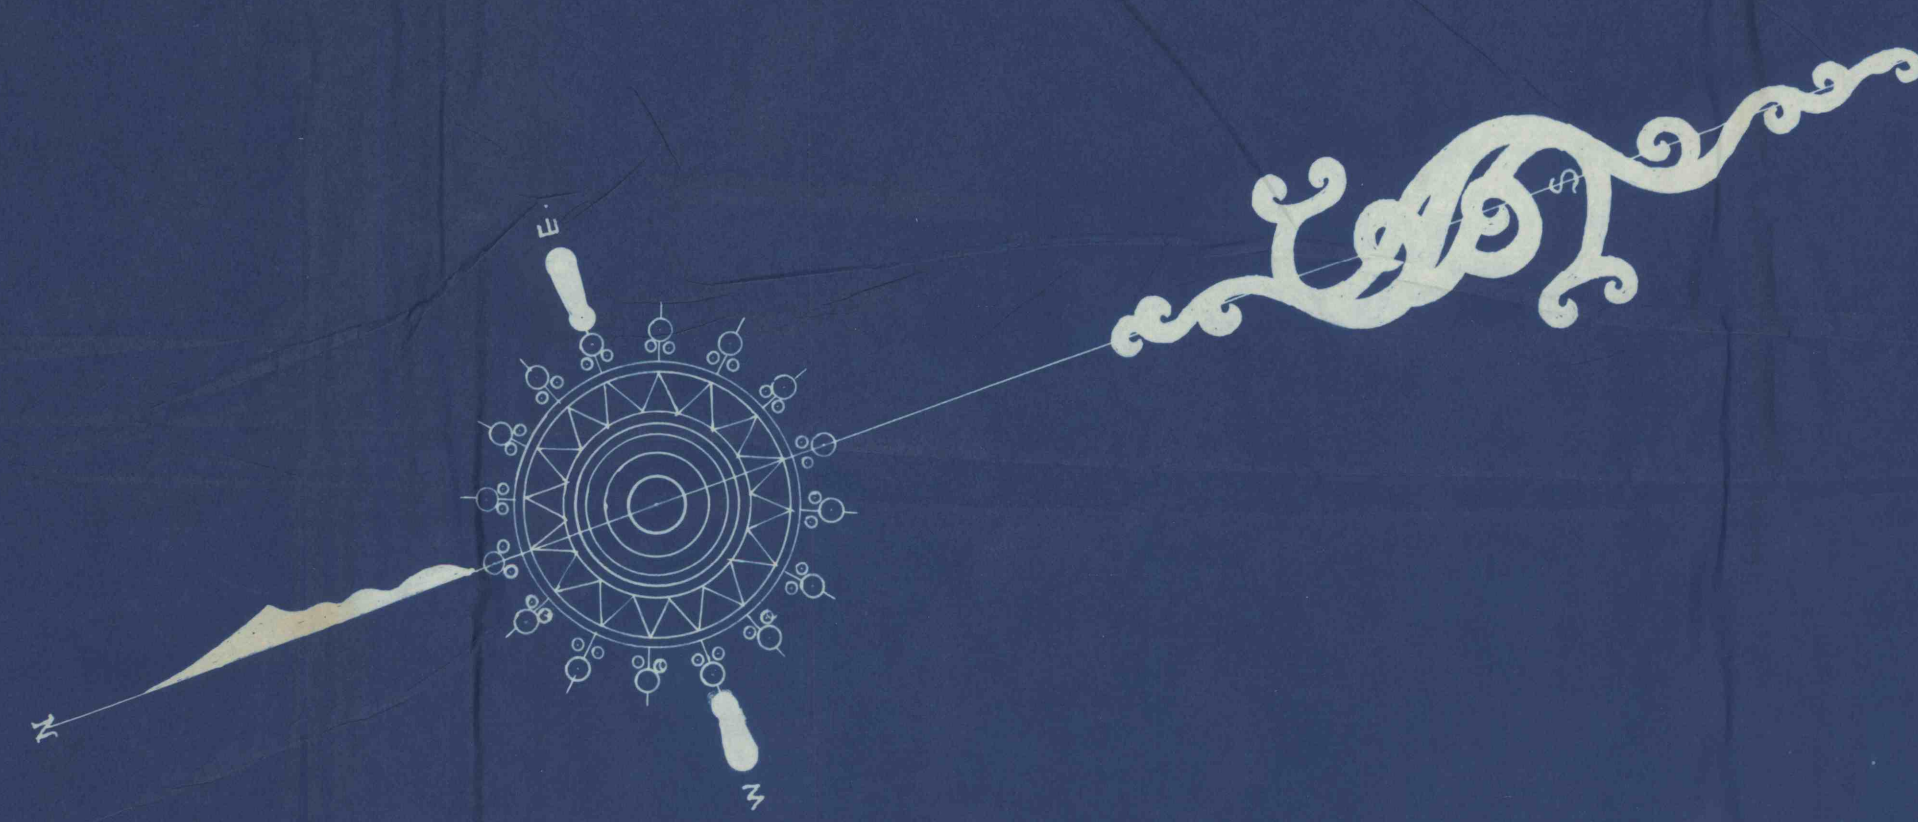

MINE MAP
OF THE
BEAVER CLAY COMPANY.
BIG BEAVER TWP. BEAVER CO. PA.
SCALE 1 IN = 100 FT
DEC. 1925
NEW CASTLE REFRACTORIES CO.-C.E. Revised: 5-14-27.
NEW CASTLE, PA. Revised: 7-22-40



FEE
REV. H.N. POTTER
TO
BEAVER CLAY MFG. CO.
10.05 AC.
VOL. 218 - 462

FEE
HENRY N. POTTER
TO
BEAVER CLAY MFG. CO.
5 AC.
VOL. 178 - 209

BEAVER CLAY CO.
LOT PLAN
VOL. 308 - 64.0

W.H. ANDERSON
48 AC. - 43 P

JAMES MCHATTIE HRS.
214 AC.

S. GREGG

GEORGE KEIL
37 AC.

ROCKY SPRINGS
GRAVE YARD

W.H. ANDERSON

WORKED OUT

WORKED OUT

POTTER LEASE

SHARP HRS. NOW FRANK FRYE

W.H. ANDERSON

