


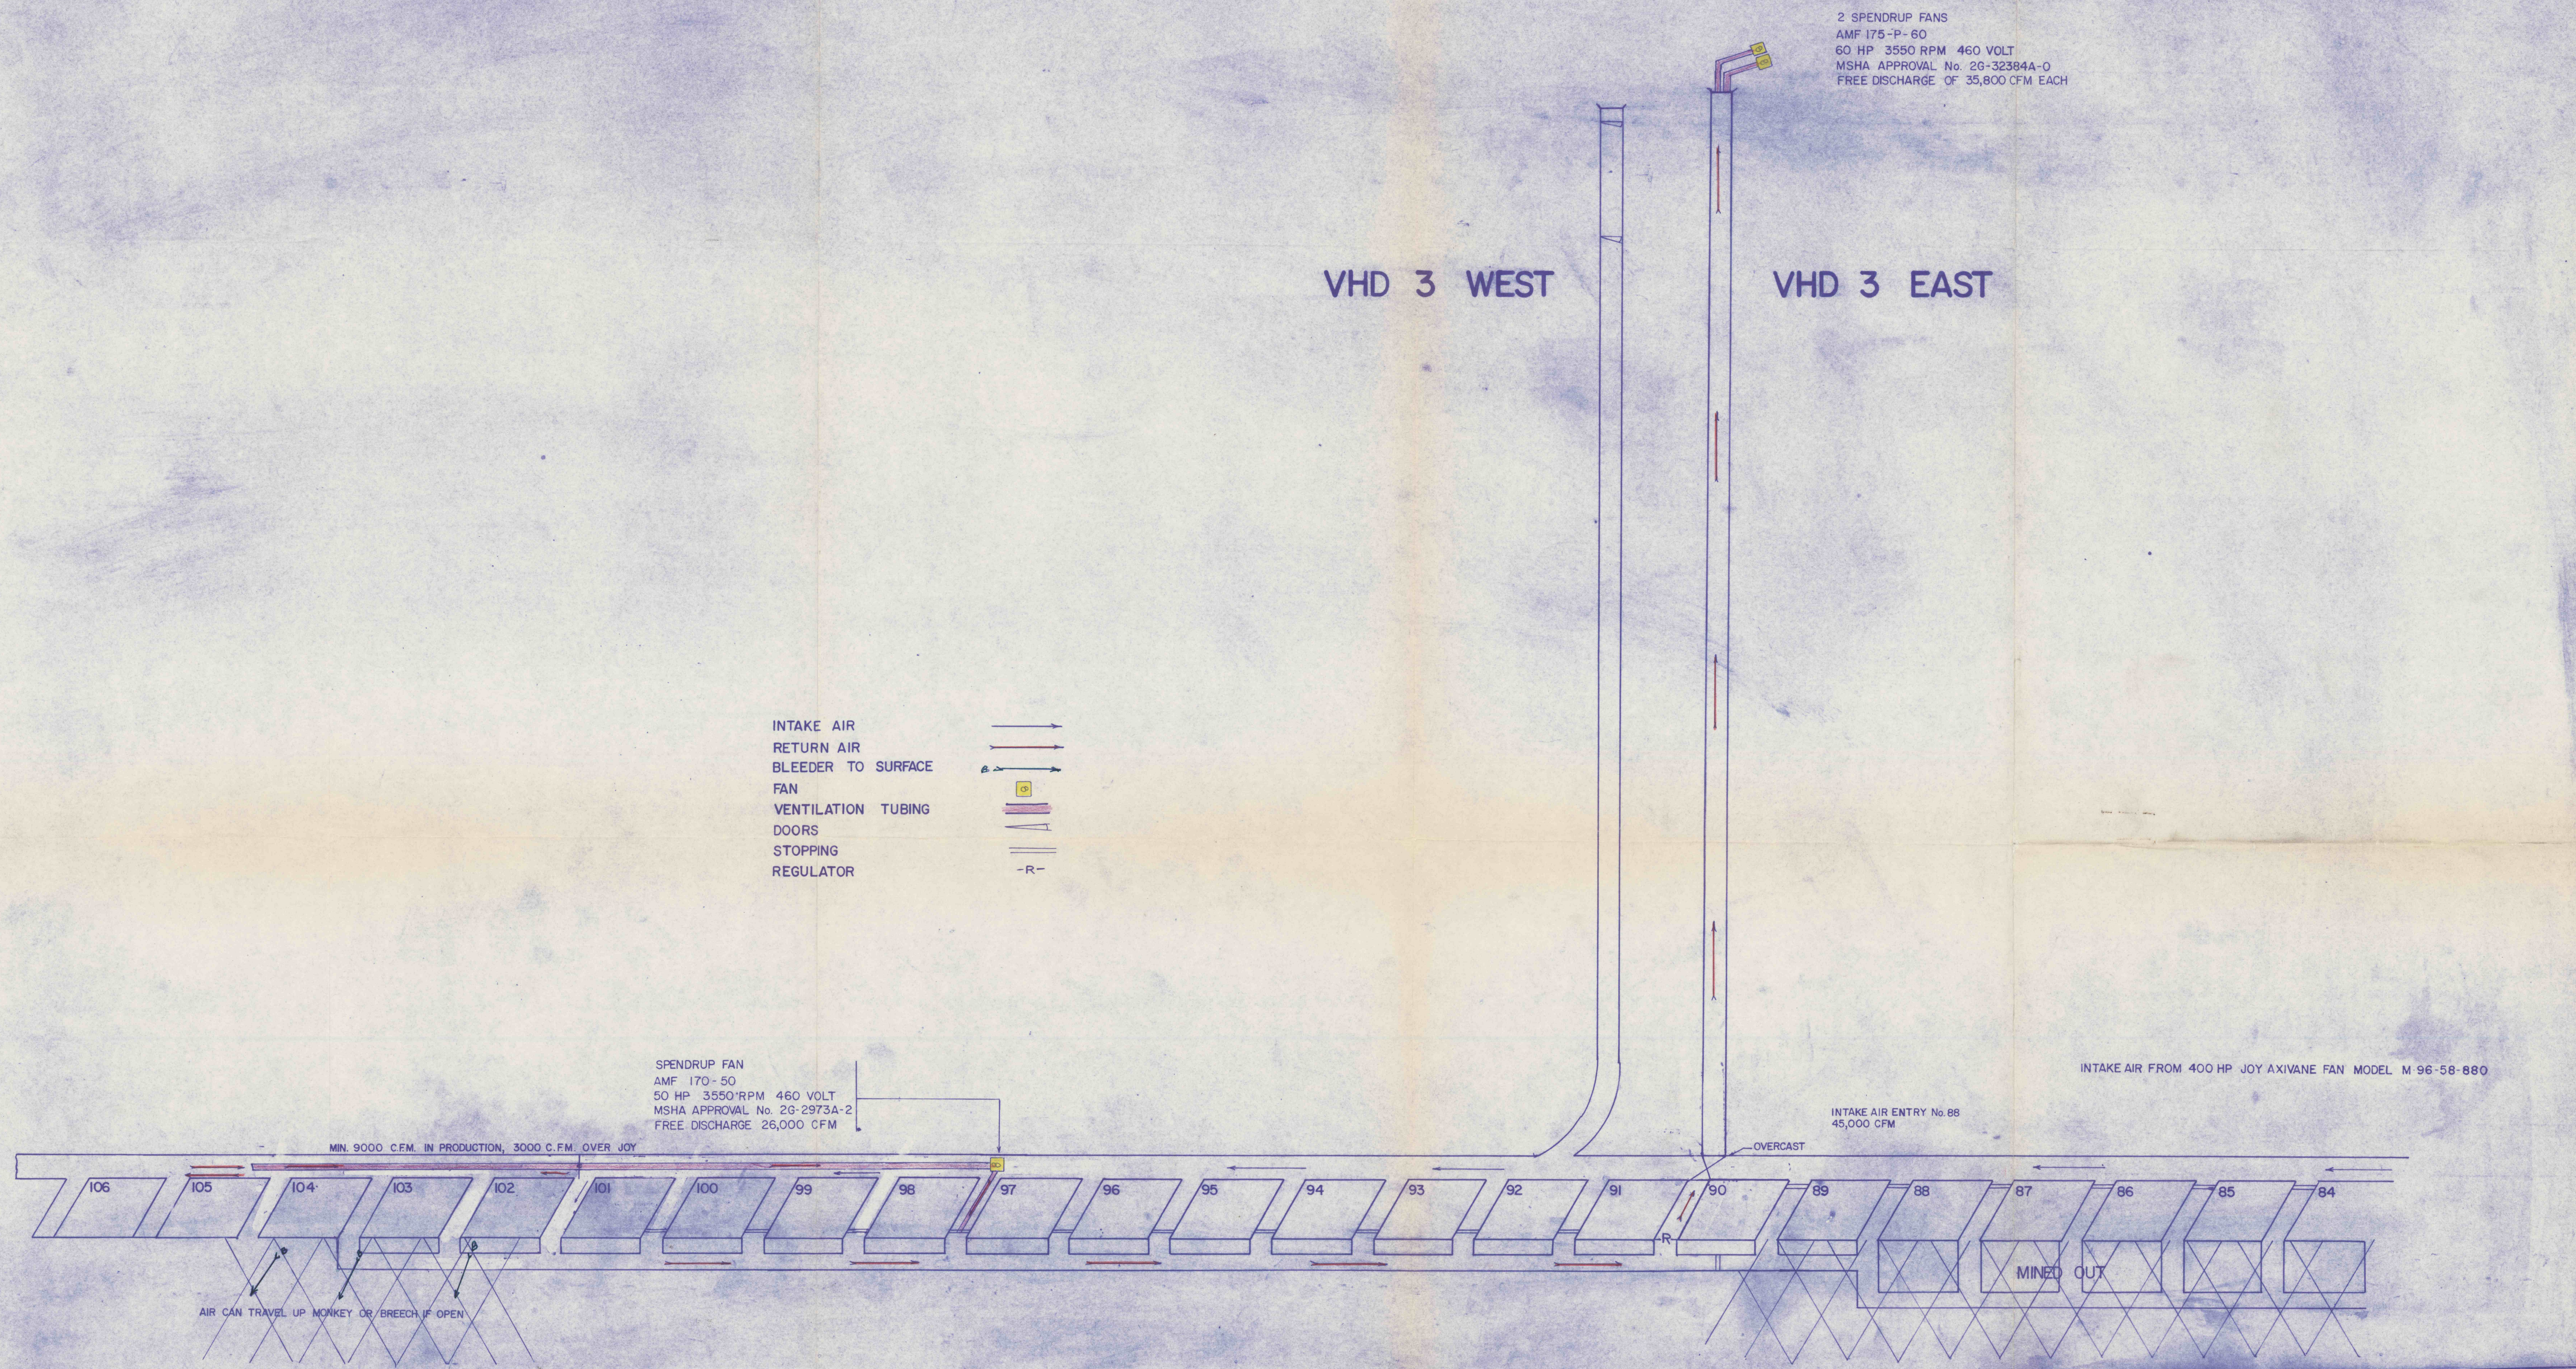

REVISED		DATE		 TOTAL 		INTERNATIONAL	
VENT MAP		1-13-89				ANTHRACITE CORPORATION	
		SCALE		1" = 50'		DATE DRAWN	
		DRAWN BY				DATE PRINTED	
		APPROVED BY				DATE RECEIVED	

2079
10210749