

OK Gary and
VHD is Developed
into Producing Coal

future 80's

INTERNATIONAL ANTHRACITE CORPORATION
B & M TUNNEL
I.D. NO. 36-01781
DIAGRAM NO. 2
VENTILATION PLAN
ADJACENT PRODUCTION UNITS
REVISED 7-2-86


LEGEND

- INTAKE AIR →
- RETURN AIR →
- BLEEDER TO SURFACE → B
- FAN (yellow box with 88)
- VENTILATION TUBING (dashed line)

KENNEDY WALL
(METAL)

VENTILATION / HAULAGE DRIFT (VHD)

AIR WILL BE DIRECTED TO THE
PRODUCTION FACE USING EITHER LINE
BRATTICE OR AUXILIARY FANS WITH
TUBING TO WITHIN 10 FEET OF THE FACE.

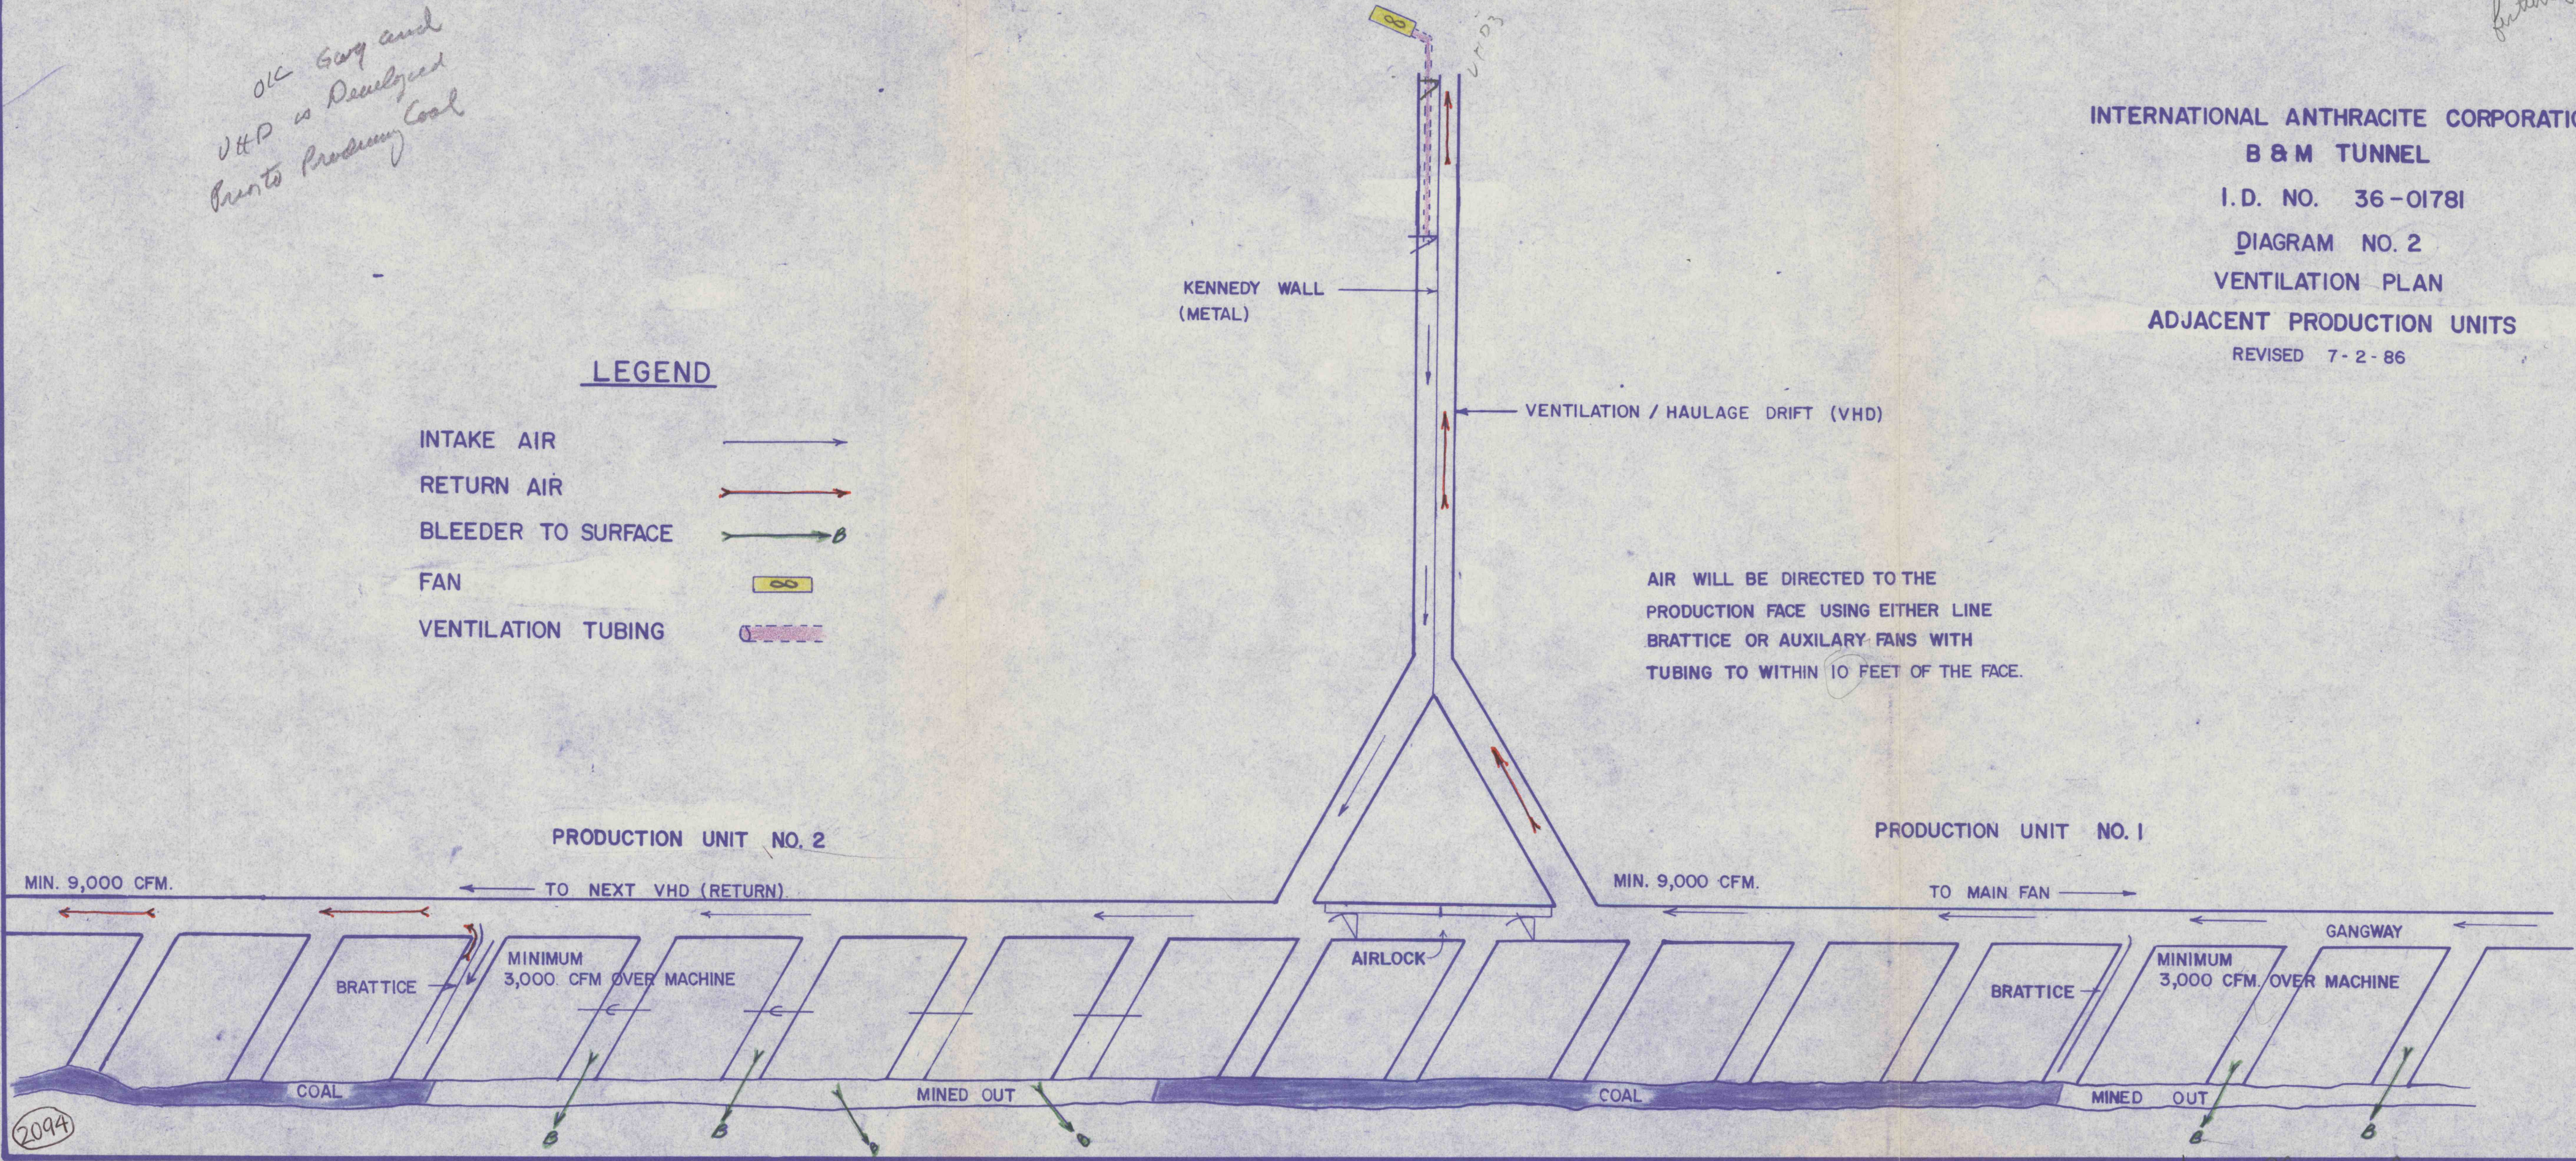

2094

Vent Plan Files

Revised 7-14-86