



SURFACE FAN

SIZE: 36 inch
Hp: 10
V: 440
RPM: 1160
WG: 1.5 in

MAIN RETURN
22000 CFM
METHANE 0.0%

ROOTER FAN

SIZE: 30 inch
Hp: 7
V: 440
RPM: 1740

SLOPE INTAKE
17000 CFM

INTAKE 9000 CFM
MAMMOTH VEIN
PIERCE LINE


BLOWER FAN
SIZE: 20 inch
Hp: 7
RPM: 1160

9000 CFM
MAMMOTH RETURN

PRICES RISE O/CART
TO MAMMOTH VEIN
FROM SEQUENCE

LEGEND

- X OVERCAST
- DIRECTION OF AIR FLOW
- STOPPING
- BOUNDARY
- /// ROBBING
- ACTIVE WORKINGS SHOWN IN GREEN
- RETURN
- INTAKE
- E ESCAPEWAY

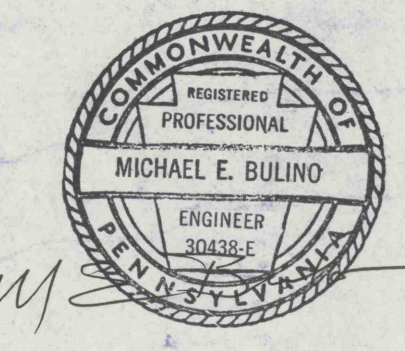

VENTILATION MAP
BAYLOR RUSH INCORPORATED
I.D.# 36-01789
BERNITSKY #2 SLOPE
NEW PHILADELPHIA PA
SCALE 1" = 100'

POSTED MARCH 20, 1965
POSTED OCT. 24, 1971
POSTED NOV 21, 1972
POSTED OCTOBER 5, 1989

POSTED JAN. 21, 1978
POSTED APRIL 21, 1979
POSTED MARCH 26, 1982
POSTED OCTOBER 5 1990

2130