


2140

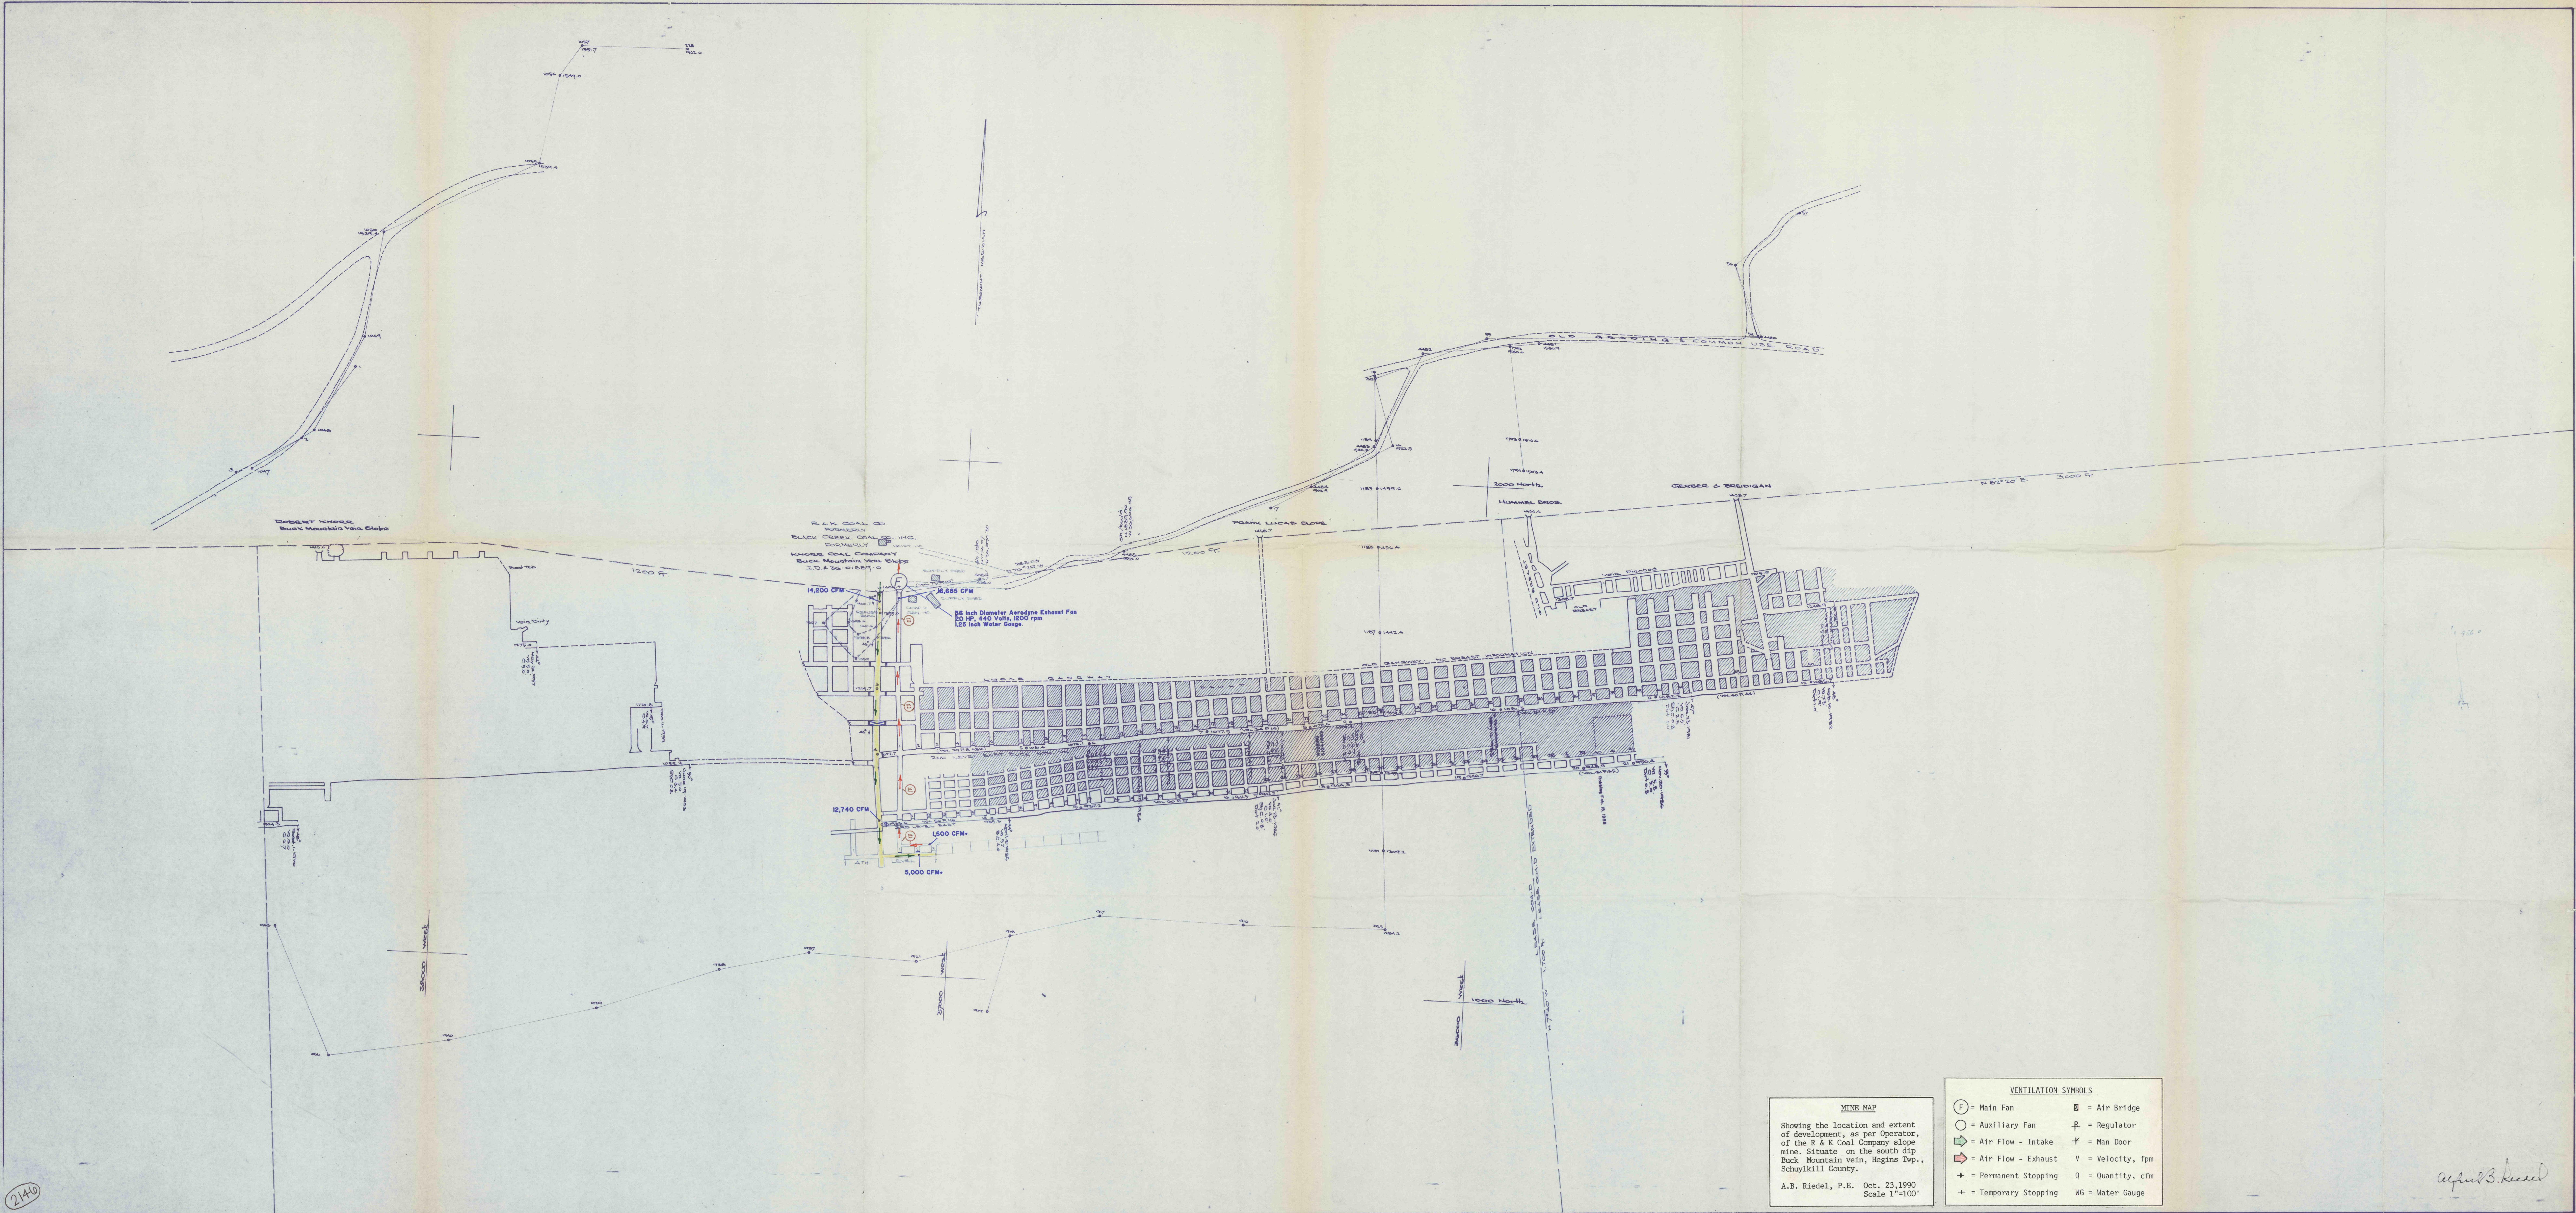

MINE MAP
Showing the location and extent of development, as per Operator, of the R & K Coal Company Slope mine. Situate on the south dip Buck Mountain vein, Hegins Twp., Schuylkill County.
A.B. Riedel, P.E. Oct. 23, 1990
Scale 1"=100'

VENTILATION SYMBOLS			
(F) = Main Fan	⊠ = Air Bridge		
○ = Auxiliary Fan	⊕ = Regulator		
→ = Air Flow - Intake	⊥ = Man Door		
⇨ = Air Flow - Exhaust	V = Velocity, fpm		
+ = Permanent Stopping	Q = Quantity, cfm		
⊕ = Temporary Stopping	WG = Water Gauge		

as per B. Riedel