


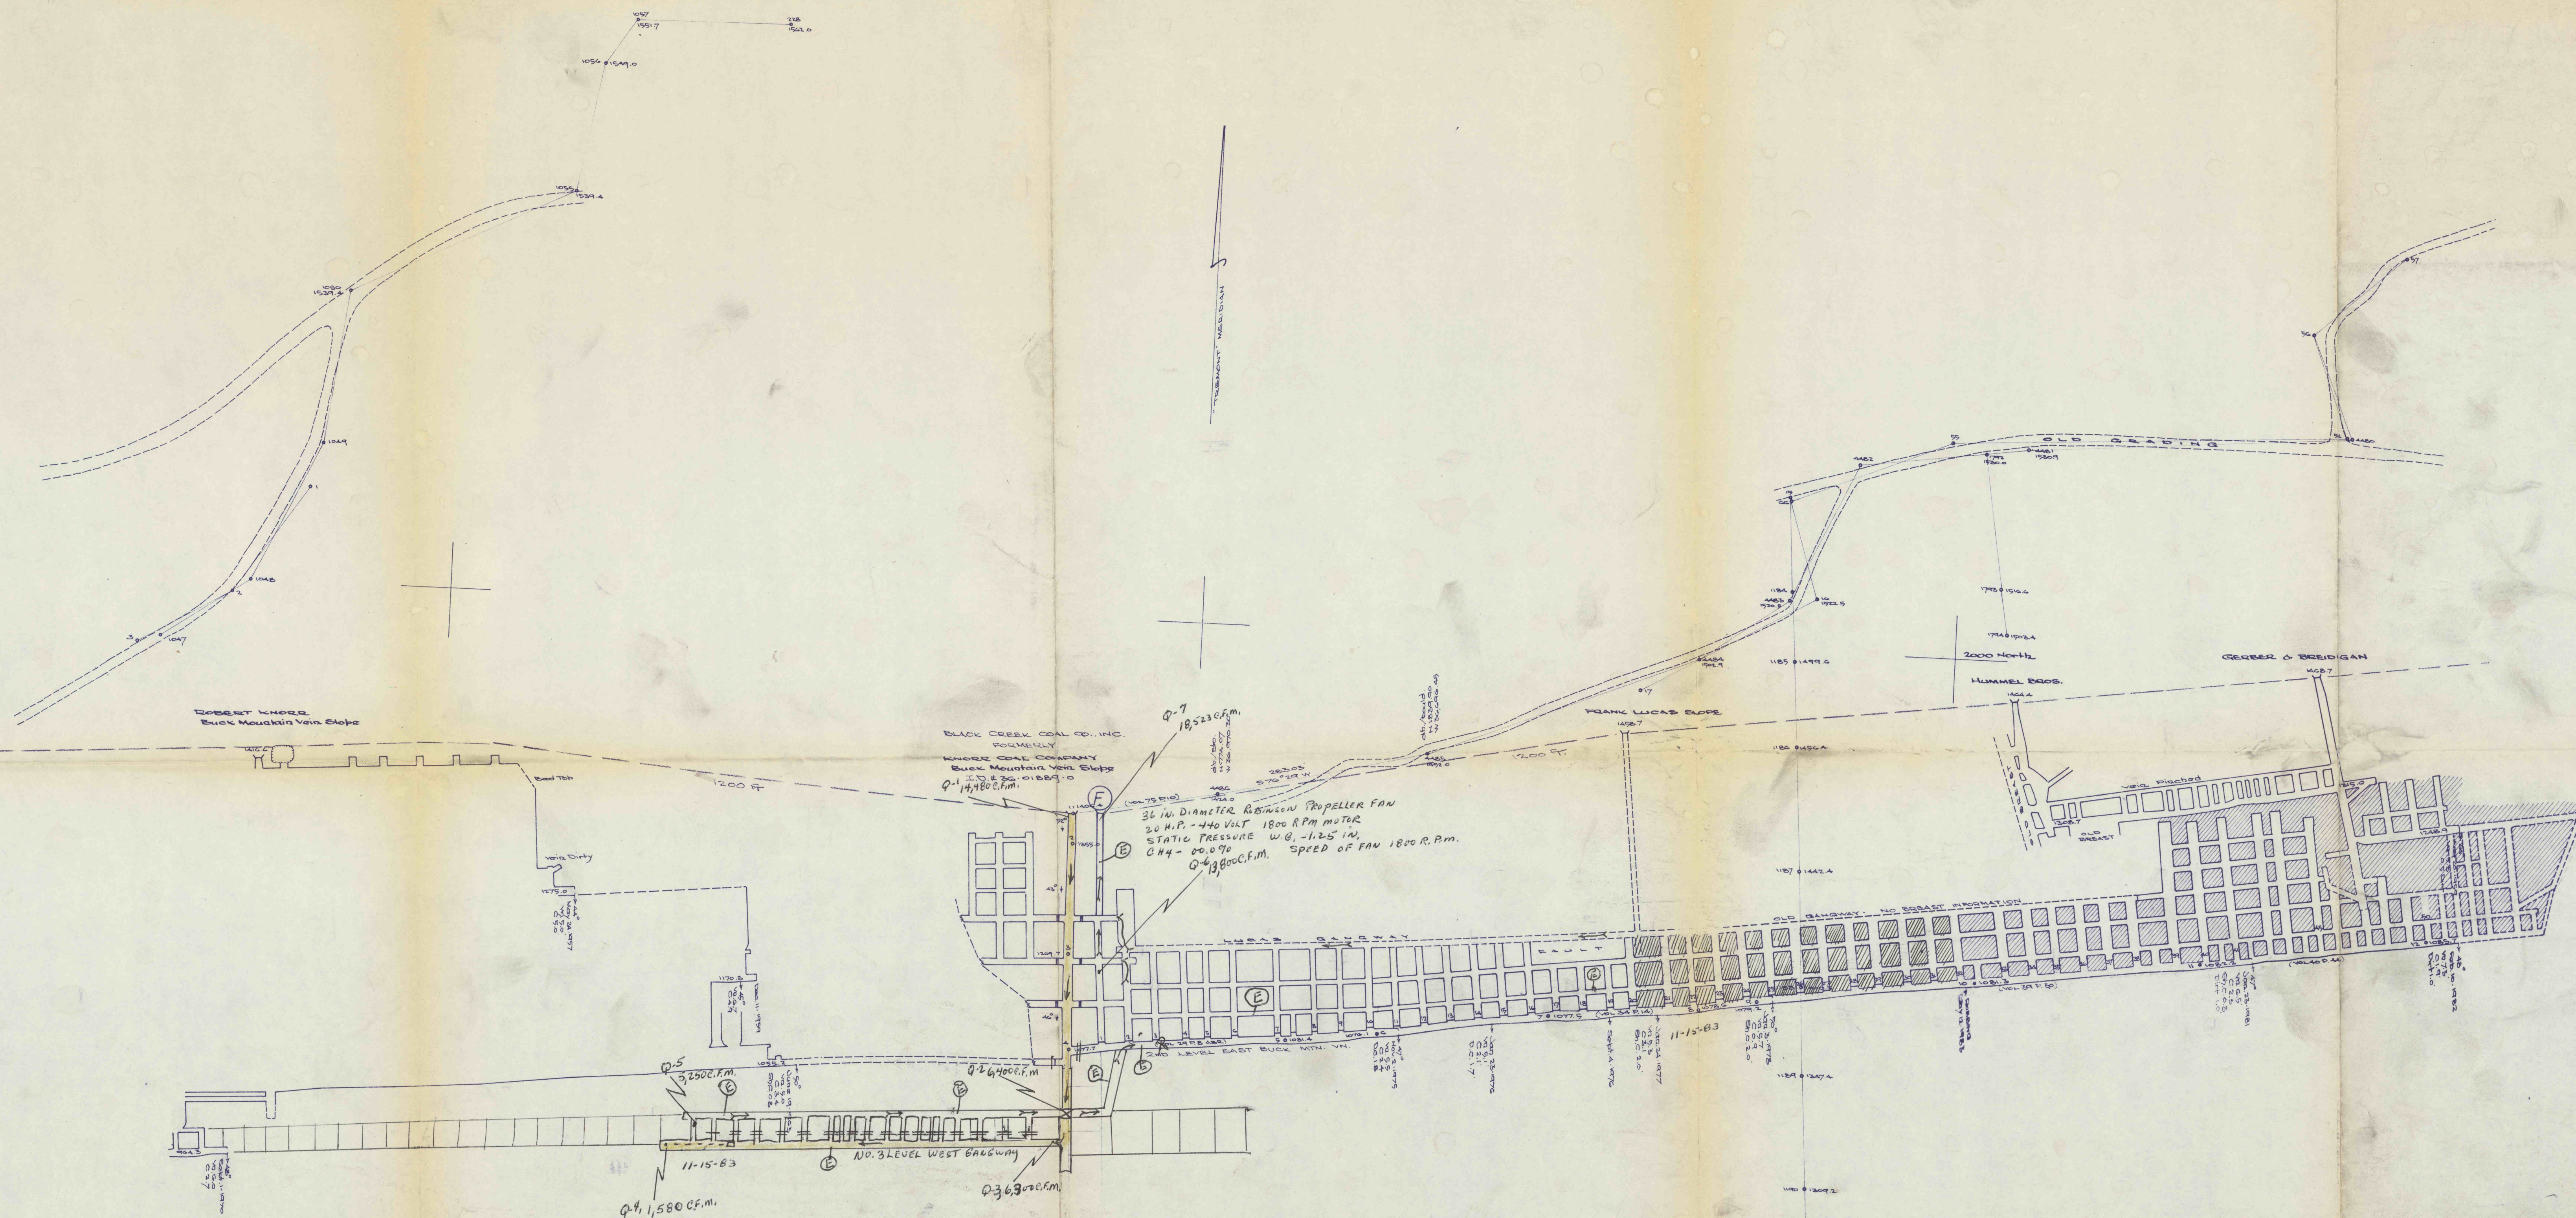

* A MINIMUM QUANTITY OF 1,500 C.F.M. WILL BE MAINTAINED AT EACH WORKING FACE.
 * A MINIMUM QUANTITY OF 5,000 C.F.M. WILL BE MAINTAINED AT THE LAST OPEN CROSSCUT.
 * A MINIMUM QUANTITY OF 5,000 C.F.M. WILL BE MAINTAINED AT THE INTAKE END OF PILLAR LINE.
 * LINE BRATTICE OR VENTILATION TUBING WILL BE MAINTAINED WITH IN 20 FEET OF EACH WORKING FACE.

DATE NOV. 15, 1983
 BUCK MOUNTAIN SLOPE
 BLACK CREEK COAL COMPANY
 BOODSPRING, SCHUYLKILL COUNTY, PA.
 I. D. NO. 36-01889
 BUCK MOUNTAIN VEIN
 SCALE - 1" = 100'

- LEGEND
- || MINE OPENINGS
 - ⊙ MAIN SURFACE FAN
 - INTAKE AIR
 - ↪ RETURN AIR
 - ⊥ TEMPORARY STOPPING
 - ⊥ PERMANENT STOPPING
 - Q AIR MEASUREMENT LOCATION
 - LINE BRATTICE
 - AIR MOVER WITH TUBING
 - ⊕ ESCAPEWAY
 - ACTIVE WORKINGS DELINEATED IN YELLOW
 - ⊗ AIR (RETURN) OVERCAST
 - R REGULATOR

MINE MAP
 Showing the location and extent of development of the Black Creek Coal Co., Inc., slope mine. Situate on the So. dip Buck Mtn. Vein, Hegins Township, Schuylkill County, Pa.
 A.B. Riedel, P.E. May 12, 1983 Scale 1"=100'

Alfred Riedel