


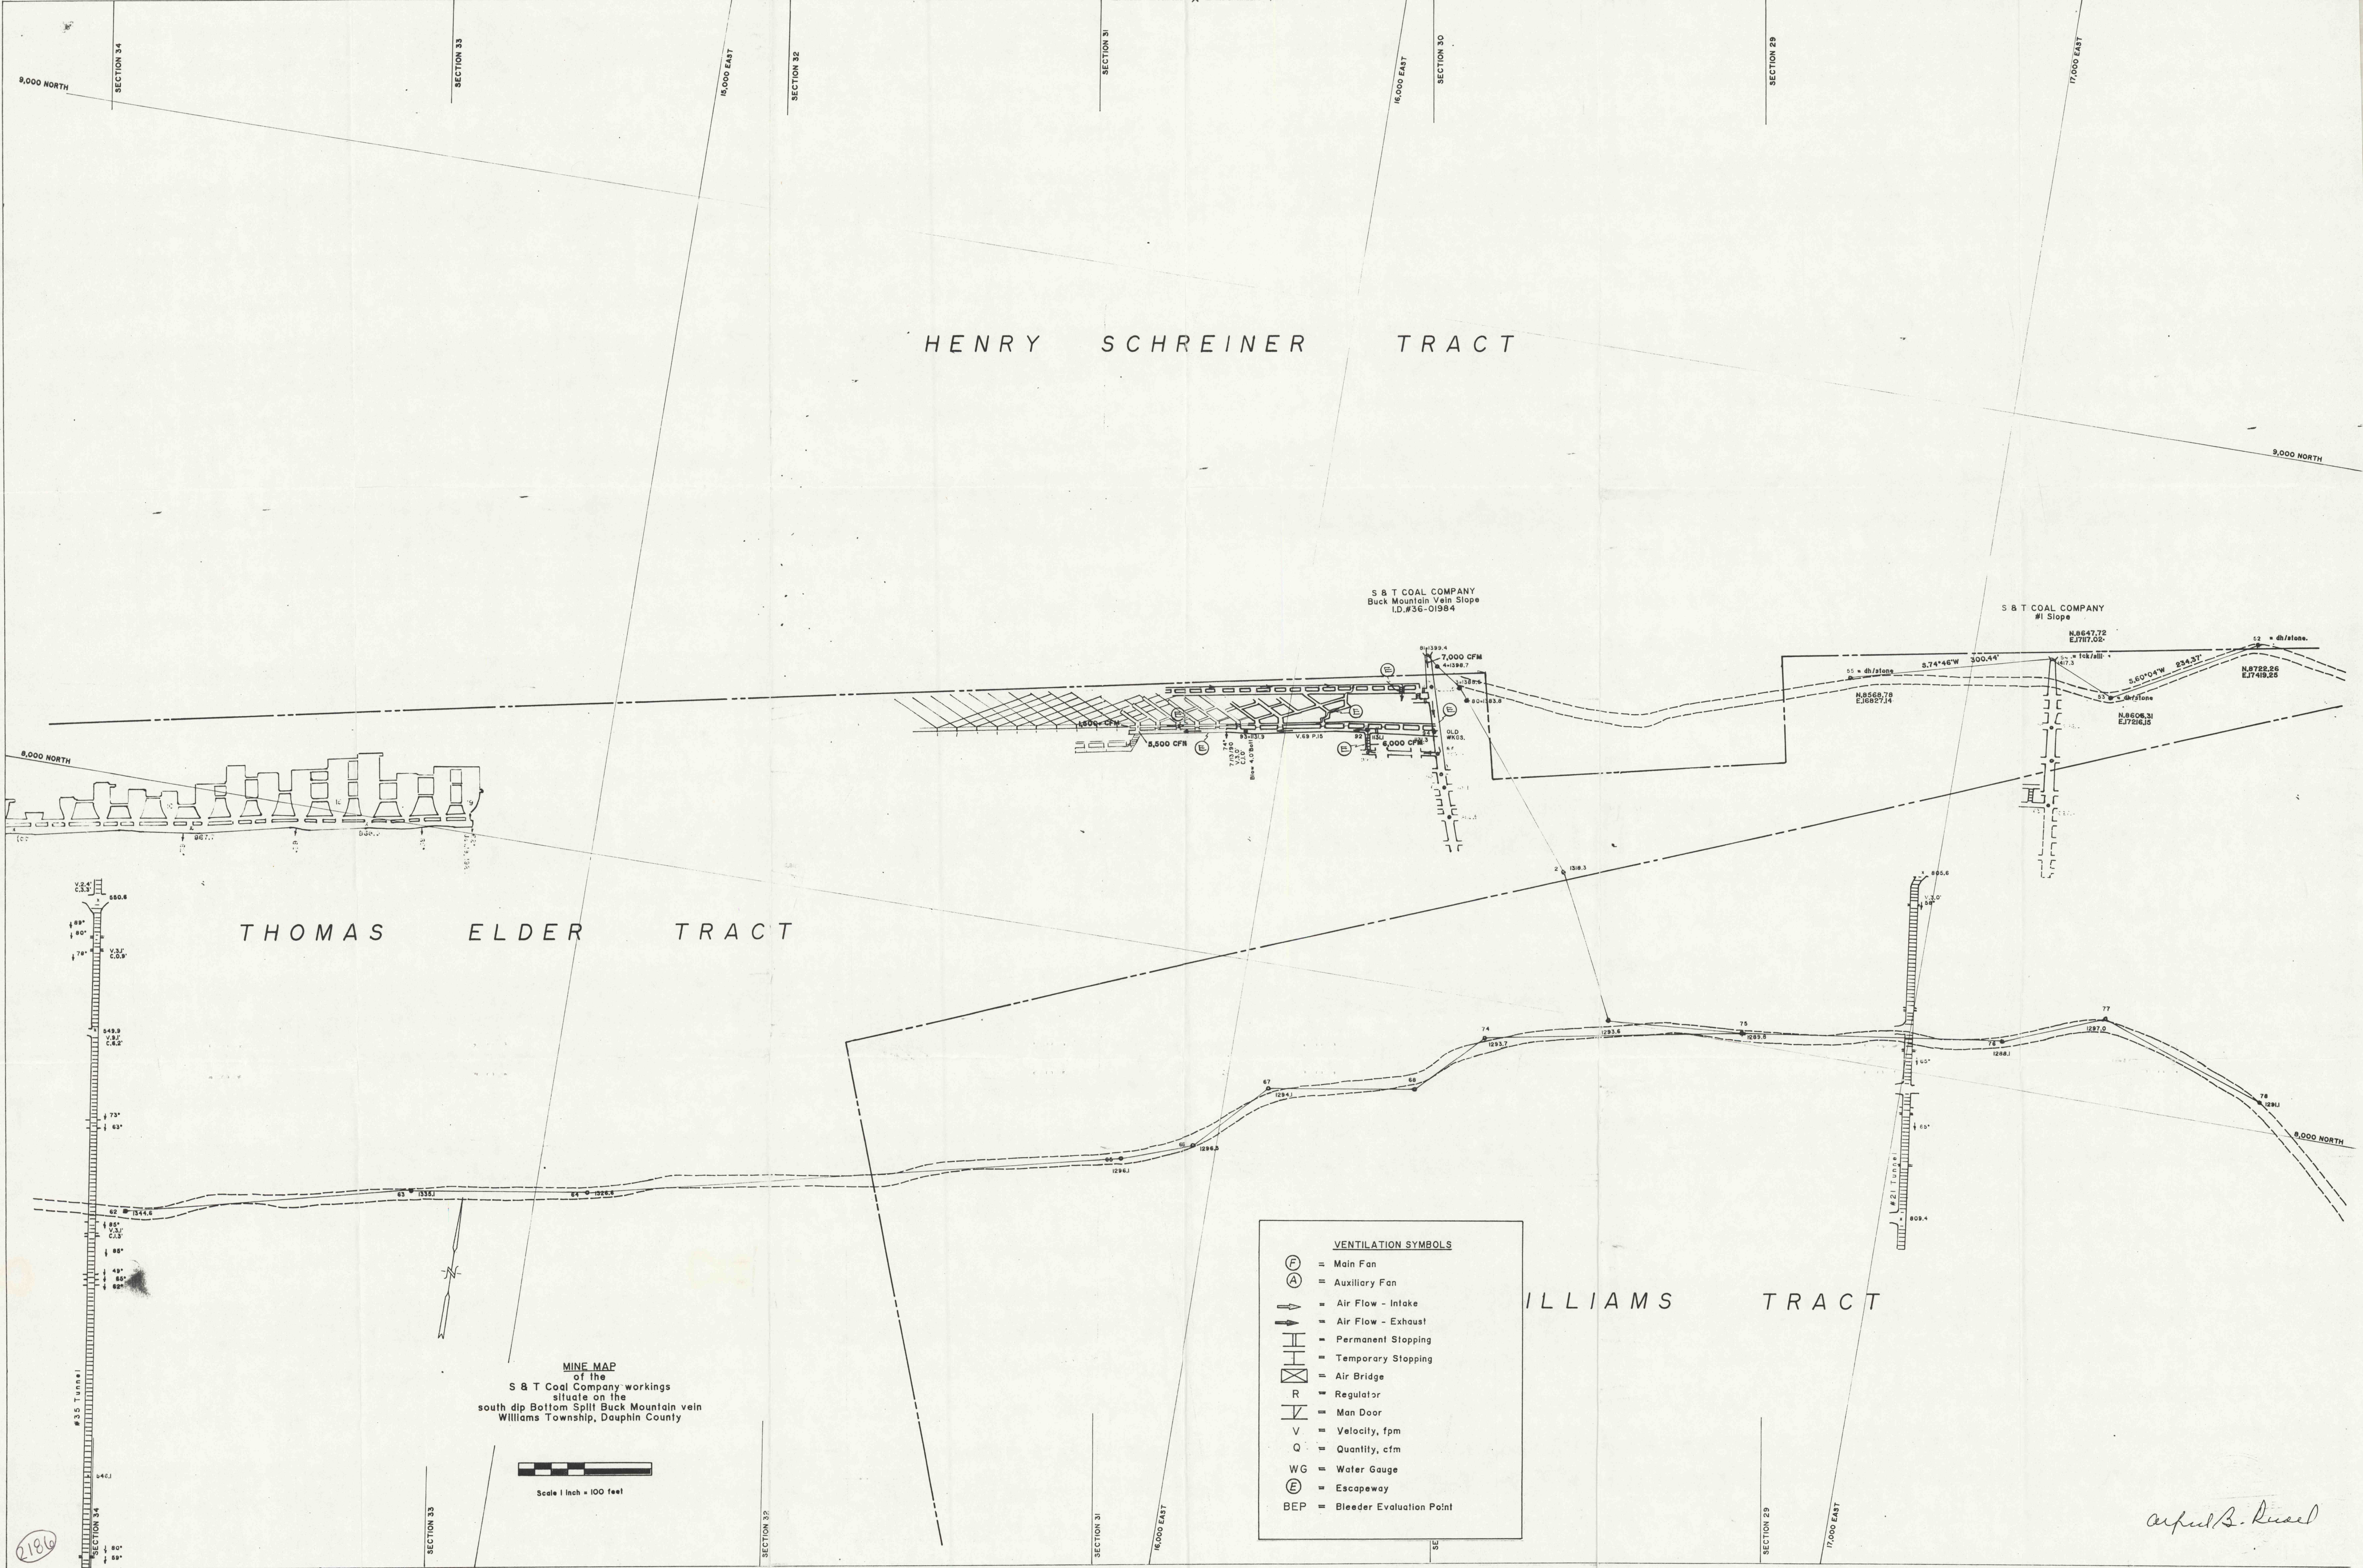

HENRY SCHREINER TRACT

THOMAS ELDER TRACT

WILLIAMS TRACT

S & T COAL COMPANY
Buck Mountain Vein Slope
I.D.#36-01984

S & T COAL COMPANY
#1 Slope

MINE MAP
of the
S & T Coal Company workings
situated on the
south dip Bottom Split Buck Mountain vein
Williams Township, Dauphin County

VENTILATION SYMBOLS

- (F) = Main Fan
- (A) = Auxiliary Fan
- = Air Flow - Intake
- ⇝ = Air Flow - Exhaust
- |—|—| = Permanent Stopping
- - -| - - -| - - -| = Temporary Stopping
- ⊠ = Air Bridge
- R = Regulator
- ⌋ = Man Door
- V = Velocity, fpm
- Q = Quantity, cfm
- WG = Water Gauge
- (E) = Escapeway
- BEP = Bleeder Evaluation Point

Arthur B. Russell