


NOTES:

- HORIZONTAL AND VERTICAL DATUM - SUSQUEHANNA COAL CO.
 - VENTILATION INFORMATION PROVIDED BY MINE OPERATOR
 - COAL VEIN INFORMATION PROVIDED BY MINE OPERATOR
 - ONE YEAR PROJECTION ESTIMATED BY MINE OPERATOR AND SUBJECT TO CHANGE AS CONDITIONS CHANGE
- THERE MAY BE OLD MINE WORKINGS IN THIS AREA!
- OLD MINE WORKINGS SHOWN ARE TAKEN FROM OLD AVAILABLE MINE MAPS.
 - AS ADDITIONAL INFORMATION AND/OR MINE MAPS BECOME AVAILABLE MAPPING SHALL BE UPDATED.
 - NO CERTIFICATION IS EXPRESSED OR IMPLIED AS TO EXISTENCE, NO EXISTENCE, ACCURACY OR LOCATIONS OF OLD MINE WORKINGS.
 - THE MINE OPERATOR SHALL BE RESPONSIBLE FOR THE VERIFICATION OF THE LOCATIONS OF ALL OLD MINE WORKINGS.

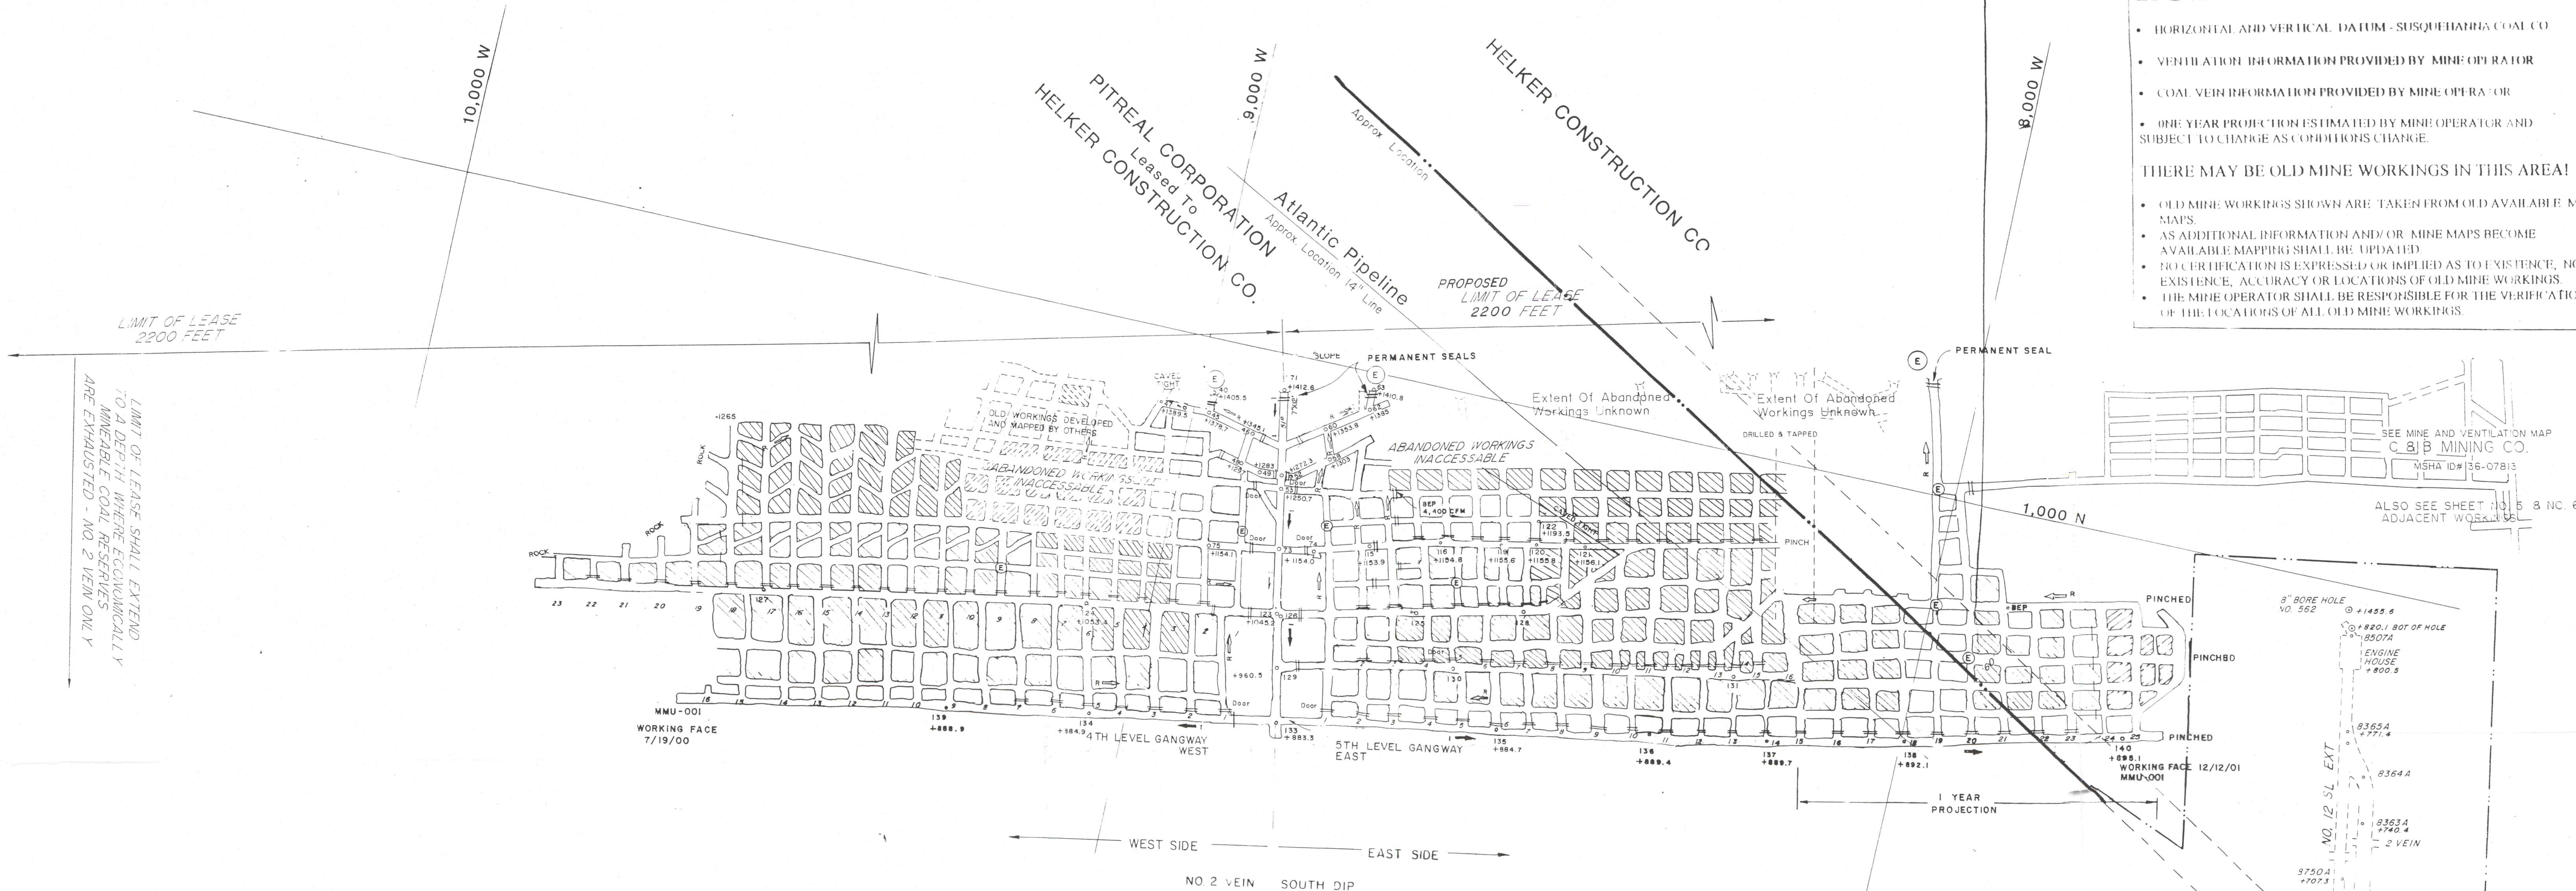

HORIZONTAL & VERTICAL CONTROL DATA

STA.	NORTHING	EASTING	ELEV. DESC.
15	900.270	-8985.720	1378.70 SPAD
16	885.110	-8923.500	1315.10 SPAD
17	899.950	-9017.790	1389.50 PK
18	813.320	-8928.010	1297.00 SPAD
19	835.810	-8903.190	1283.00 SPAD
51	837.560	-8871.120	1267.70 SPAD
52	836.720	-8862.010	1272.30 SPAD
53	818.580	-8868.220	1250.70 SPAD
58	869.690	-8818.900	1303.09 SPAD
60	908.210	-8831.850	1353.80 SPAD
62	913.930	-8783.800	1385.00 SPAD
63	970.080	-8782.210	1410.80 HOOK
71	951.110	-8893.800	1412.60 CHISEL
73	712.200	-8855.280	1151.00 SPAD
74	751.110	-8809.610	1155.36 SPAD
75	729.380	-8947.620	1154.10 SPAD
115	771.290	-8711.230	1154.80 SPAD
116	797.150	-8619.300	1154.84 SPAD
119	812.760	-8569.110	1155.55 SPAD
120	823.690	-8523.600	1155.80 SPAD
121	834.990	-8461.730	1156.07 SPAD
122	851.200	-8528.630	1193.45 SPAD
123	662.720	-8839.100	1045.20 PK
124	619.620	-9089.780	1053.12 SPAD
125	701.130	-8665.930	SPAD
126	661.010	-8875.900	1051.09 SPAD
127	537.731	-9505.688	1051.16 SPAD
129	595.005	-8571.119	965.300 SPAD
130	644.963	-8596.805	972.380 SPAD
131	719.16	-8233.58	976.18 SPAD
133	526.61	-8806.85	883.29 SPAD
134	478.92	-9051.07	884.85 SPAD
135	580.60	-8524.72	884.71 SPAD
136	624.69	-8324.65	889.39 SPAD
137	647.66	-8172.27	889.74 SPAD
138	685.05	-7996.85	892.11 SPAD
139	441.36	-9236.84	888.94 SPAD
140	749.76	-7711.05	895.12 SPAD

LEGEND:


- ESCAPEWAY
- ROBBED
- SURVEY STATION
- ELEVATION
- STOPPING
- INTAKE AIR
- RETURN AIR
- OLD ABANDONED WORKINGS
- NEW WORKINGS OF NORTH MOUNTAIN COAL CO.
- PROPERTY LINE
- OUTCROP LINE
- PITCH OF VEIN (DEGREES)
- BLEEDER EVALUATION POINT

FINAL SEAL PLAN
MINE AND VENTILATION MAP
No. 2 Vein - South Dip
JORDAN COAL CO.
(JORDAN NO. 1 SLOPE)
COAL TOWNSHIP, NORTHUMBERLAND COUNTY
PENNSYLVANIA
SCALE: 1 INCH = 100 FEET , DECEMBER 14, 2001
APRIL 14, 2004 (FINAL SEAL PLAN)
M.S.H.A. I.D.# 36- 07681

Received

JUN 2 2004
U.S. DEPT. OF LABOR
MSHA
WILKES-BARRE, PA

Taylor-Doback Associates
PROFESSIONAL LAND SURVEYORS
RD#1 BOX 659
SHAMOKIN, PA. 17872

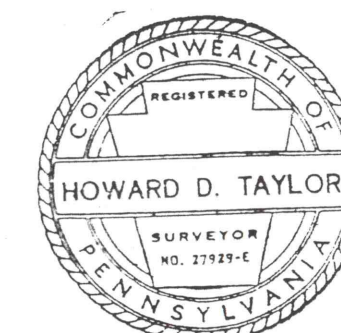

Date: 9-21-04

This map represents a complete and accurate representation of all underground mine excavations by our company and that the map is the "Final" mine map for this operation.
Signature of Company or Corporate Officer

Sub-Surface
SHEET NO. 2