


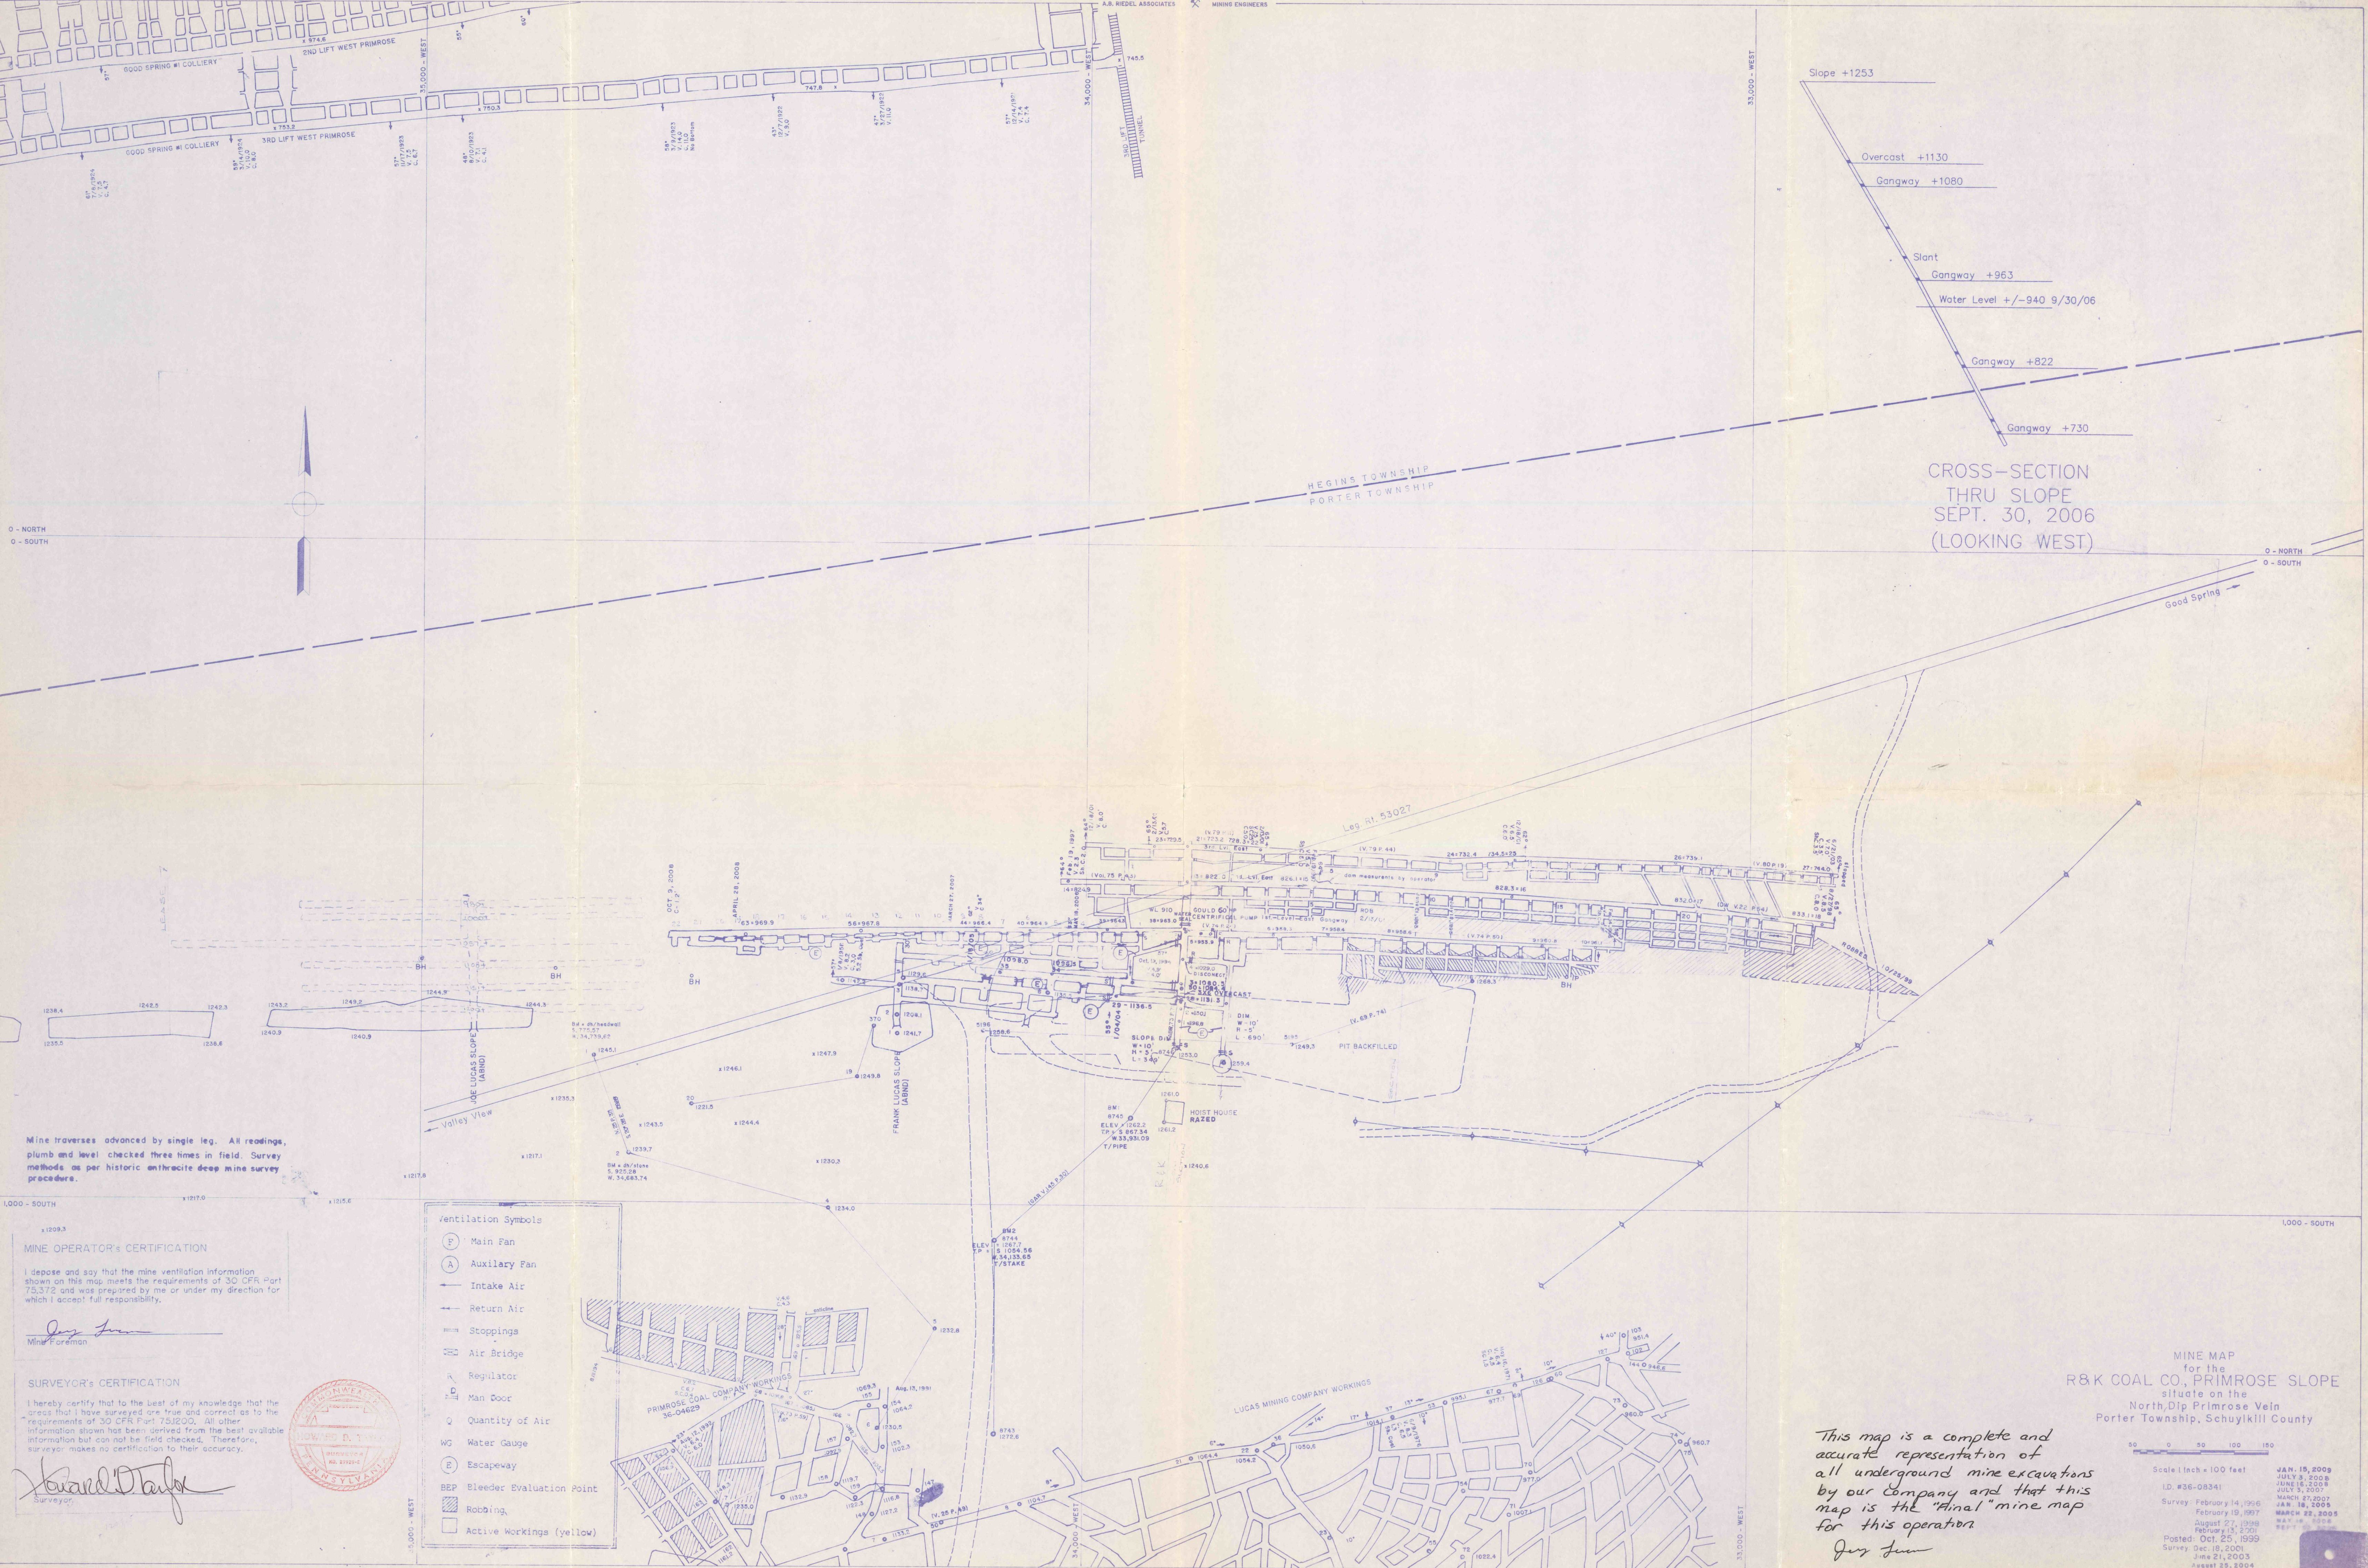

0 - NORTH
0 - SOUTH

0 - NORTH
0 - SOUTH

CROSS-SECTION
THRU SLOPE
SEPT. 30, 2006
(LOOKING WEST)

Mine traverses advanced by single leg. All readings, plumb and level checked three times in field. Survey methods as per historic anthracite deep mine survey procedures.

MINE OPERATOR'S CERTIFICATION

I depose and say that the mine ventilation information shown on this map meets the requirements of 30 CFR Part 75.372 and was prepared by me or under my direction for which I accept full responsibility.

Joe Linn
Mine Foreman

SURVEYOR'S CERTIFICATION

I hereby certify that to the best of my knowledge that the areas that I have surveyed are true and correct as to the requirements of 30 CFR Part 75.1200. All other information shown has been derived from the best available information but can not be field checked. Therefore, surveyor makes no certification to their accuracy.

Harold D. Tapp
Surveyor



- Ventilation Symbols
- Main Fan
 - Auxiliary Fan
 - Intake Air
 - Return Air
 - Stoppings
 - Air Bridge
 - Regulator
 - Man Door
 - Quantity of Air
 - WG Water Gauge
 - Escapeway
 - BEP Bleeder Evaluation Point
 - Robbing
 - Active Workings (yellow)

This map is a complete and accurate representation of all underground mine excavations by our Company and that this map is the "Final" mine map for this operation.

Joe Linn

MINE MAP
for the
R&K COAL CO., PRIMROSE SLOPE
situate on the
North Dip Primrose Vein
Porter Township, Schuylkill County

Scale 1 inch = 100 feet

ID. #36-08341

Survey: February 14, 1996
February 19, 1997
August 27, 2007
February 15, 2001
Posted: Oct. 25, 1999
Survey: Dec. 15, 2001
June 21, 2003
August 25, 2004

JAN. 15, 2009
JULY 3, 2008
JUNE 16, 2008
JULY 3, 2007
MARCH 27, 2007
JAN. 18, 2005
MARCH 22, 2005
MAY 18, 2004
MAY 18, 2004