
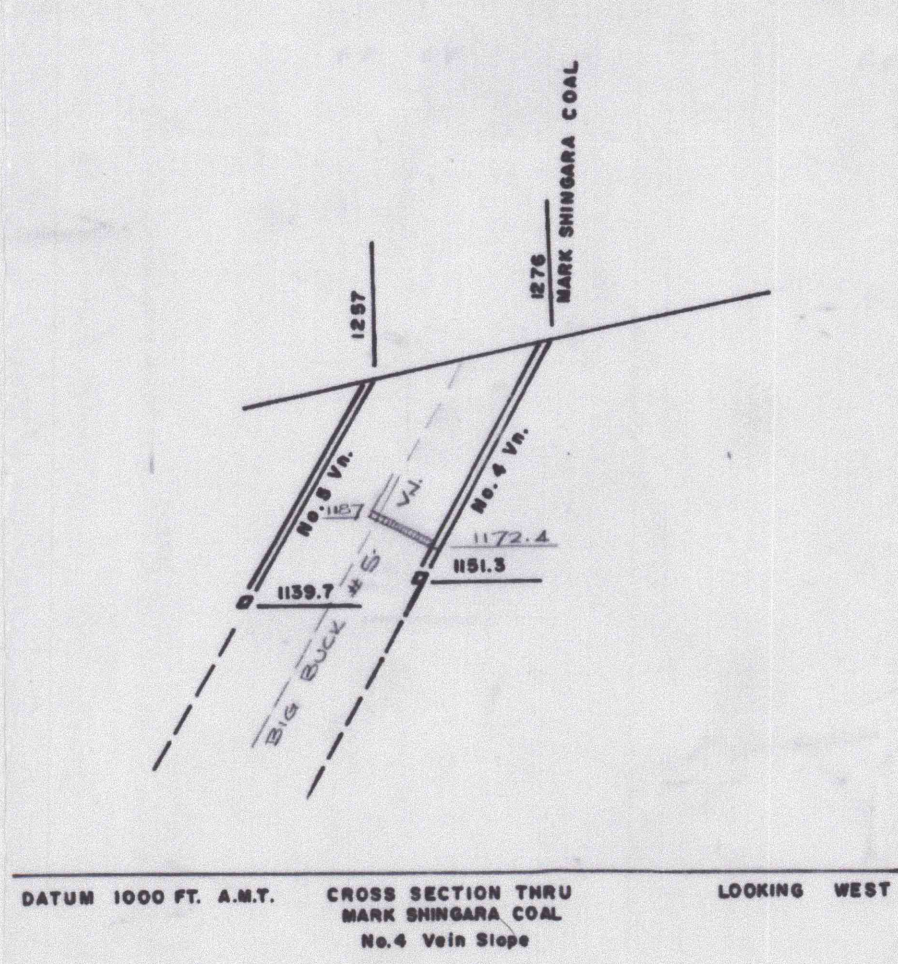


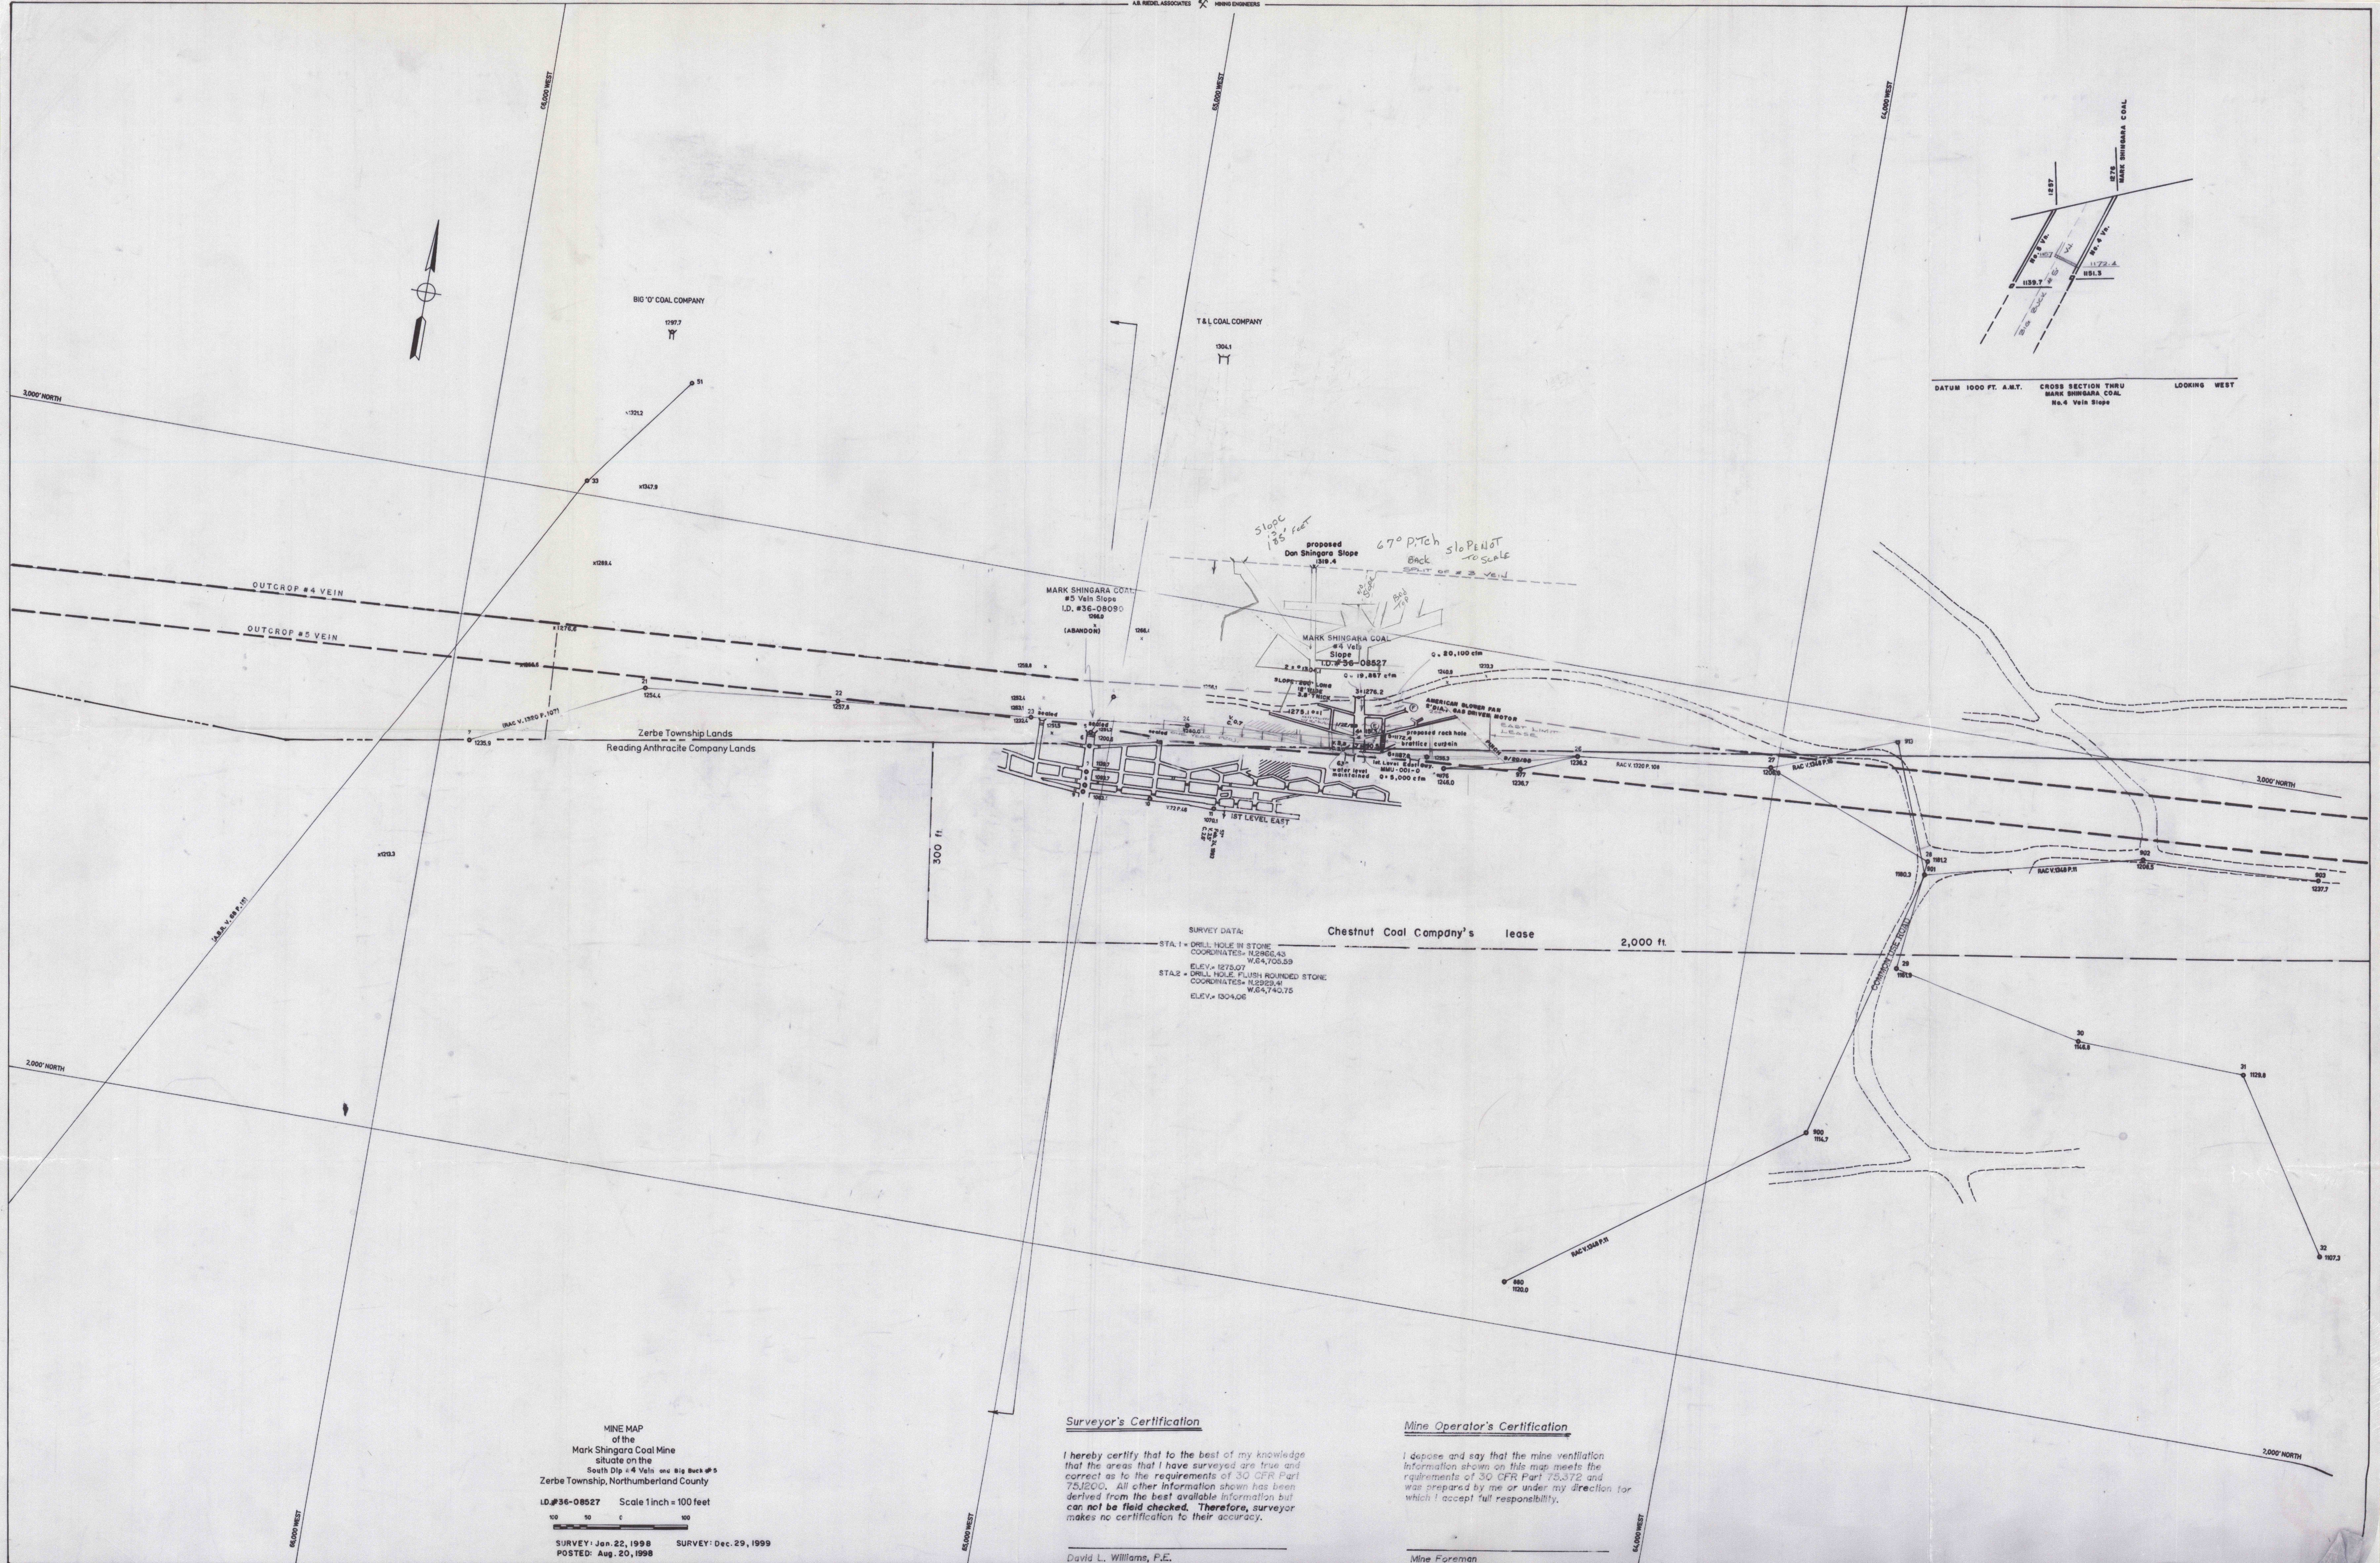

MINE MAP
of the
Mark Shingara Coal Mine
situate on the
South Dip #4 Vein and Big Back #5
Zerbe Township, Northumberland County
L.D. #36-08527 Scale 1 inch = 100 feet
SURVEY: Jan. 22, 1999
POSTED: Aug. 20, 1999
SURVEY: Dec. 29, 1999

Surveyor's Certification
I hereby certify that to the best of my knowledge
that the areas that I have surveyed are true and
correct as to the requirements of 30 CFR Part
75.200. All other information shown has been
derived from the best available information but
can not be field checked. Therefore, surveyor
makes no certification to their accuracy.
David L. Williams, F.E.

Mine Operator's Certification
I depose and say that the mine ventilation
information shown on this map meets the
requirements of 30 CFR Part 75.372 and
was prepared by me or under my direction for
which I accept full responsibility.
Mine Foreman