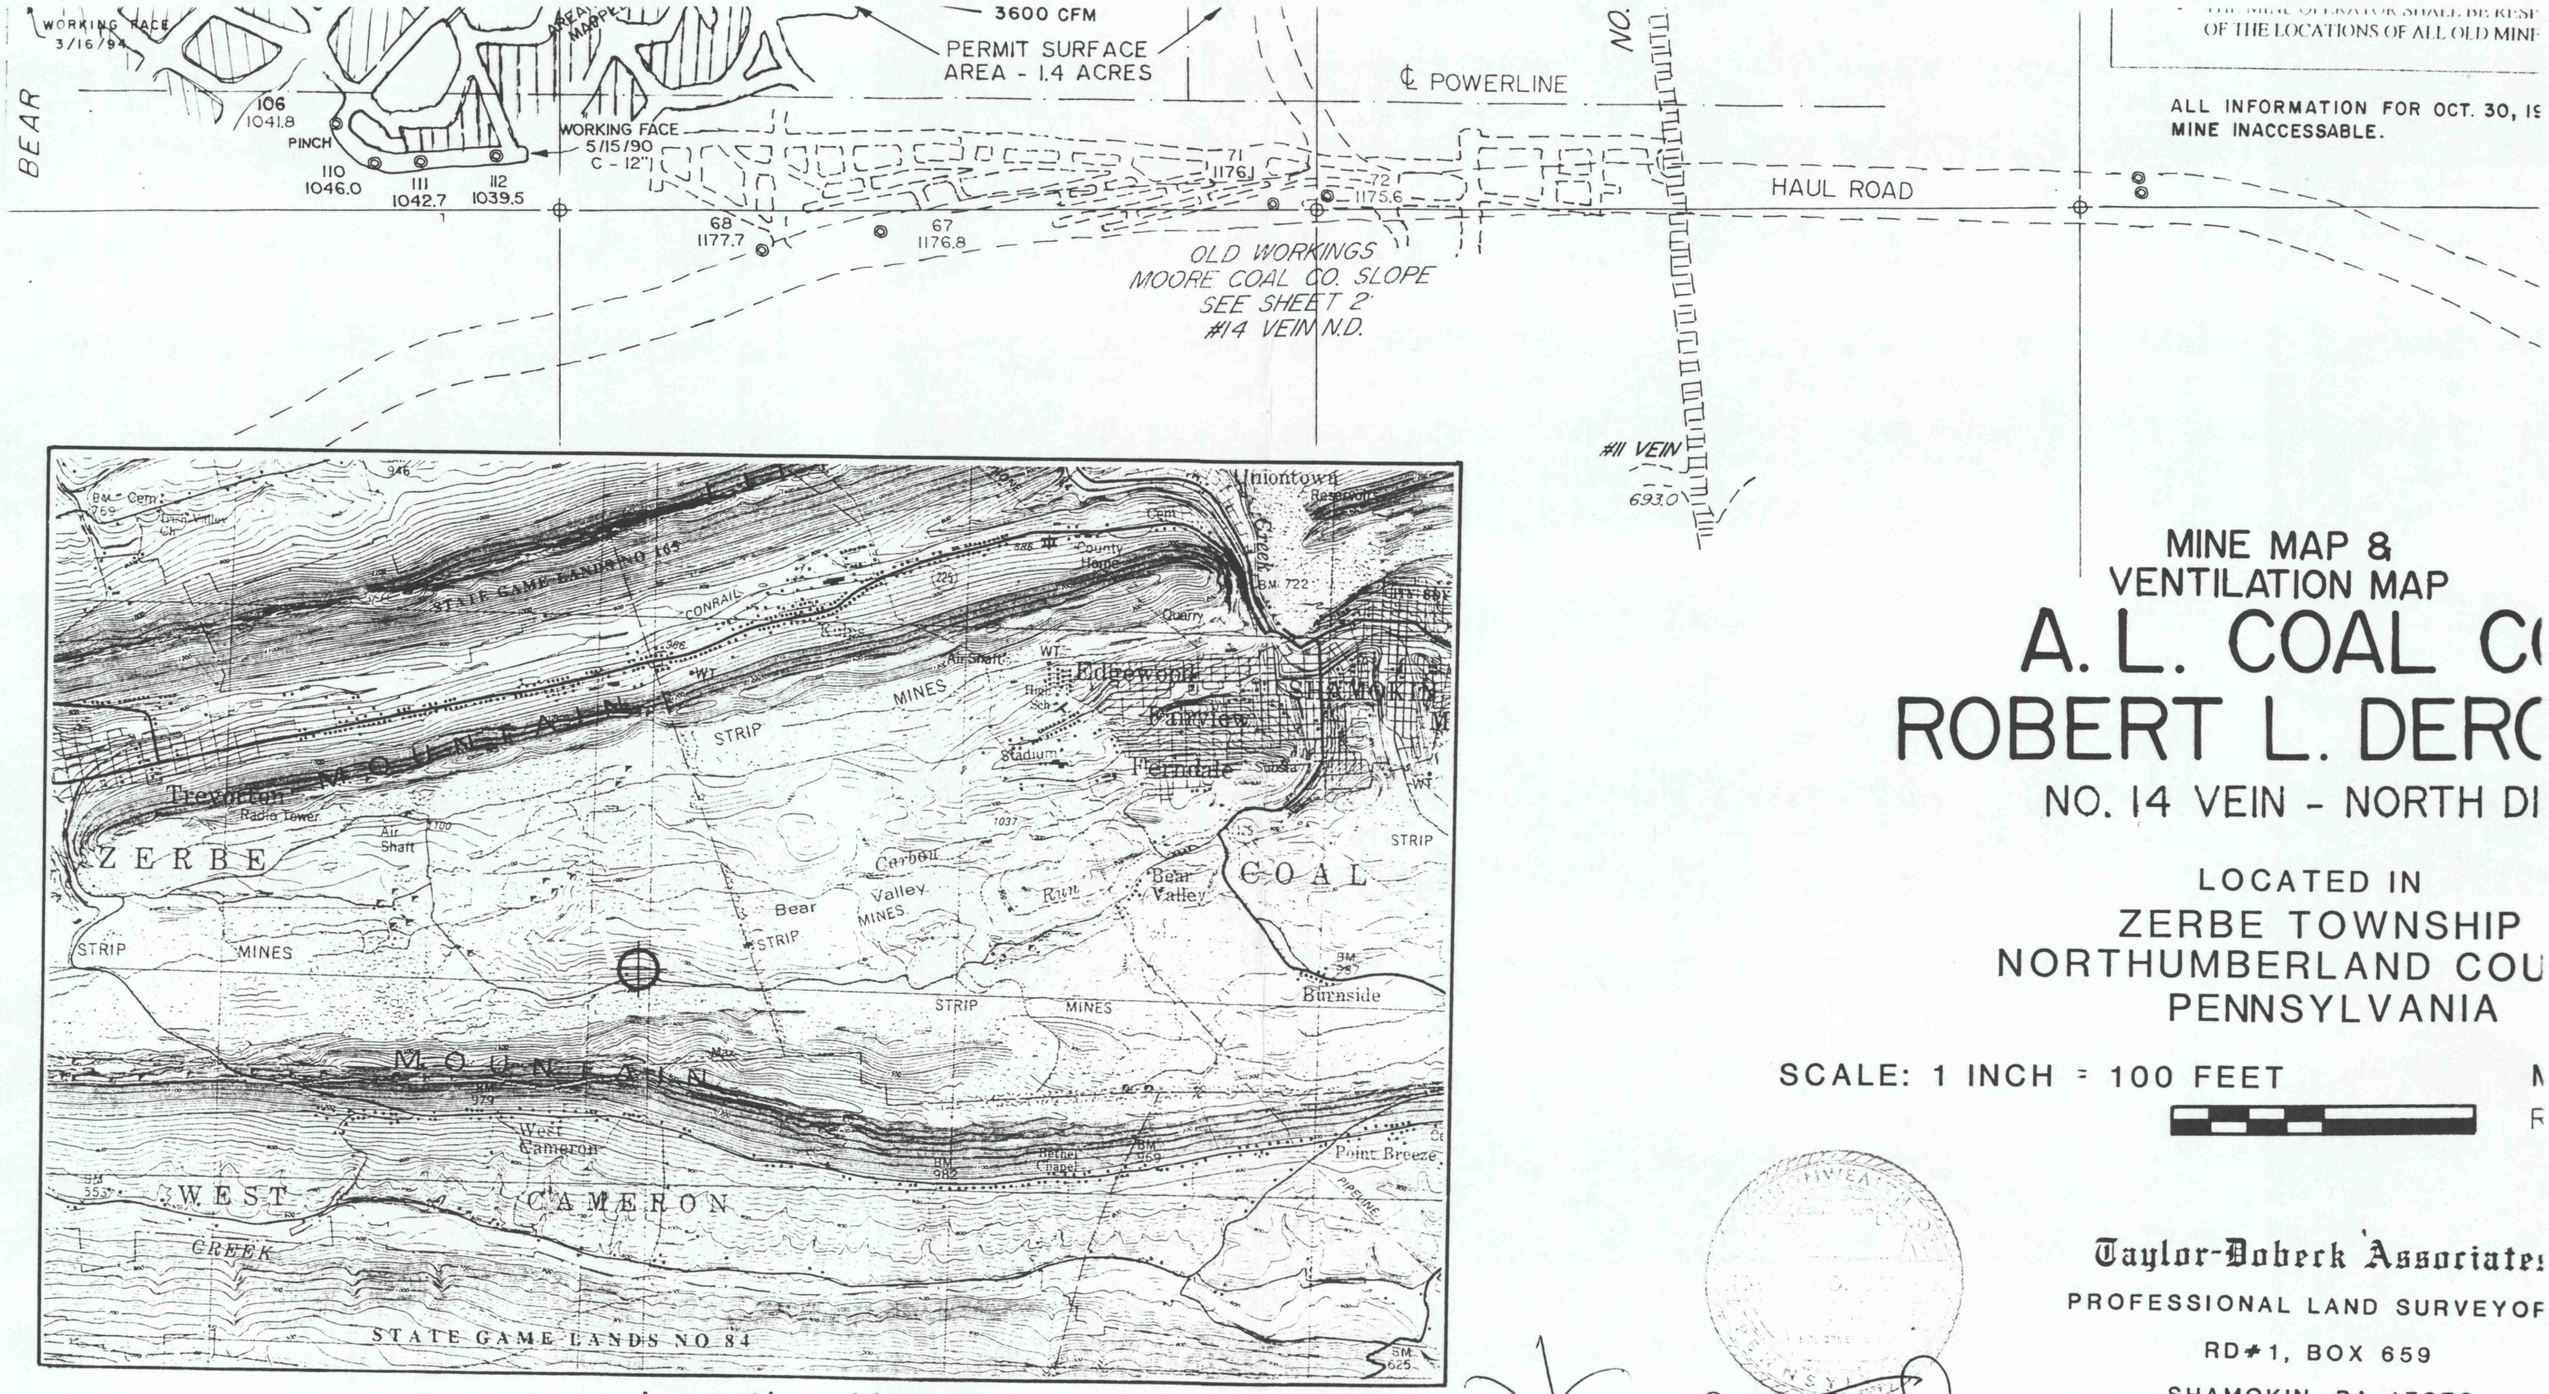

Location Map

MINE MAP &
VENTILATION MAP

A. L. COAL C
ROBERT L. DERC

NO. 14 VEIN - NORTH DI

LOCATED IN
ZERBE TOWNSHIP
NORTHUMBERLAND COU
PENNSYLVANIA

SCALE: 1 INCH = 100 FEET

N
F

Howard D Taylor

Taylor-Doberk Associates
PROFESSIONAL LAND SURVEYOR
RD#1, BOX 659
SHAMOKIN, PA 17872