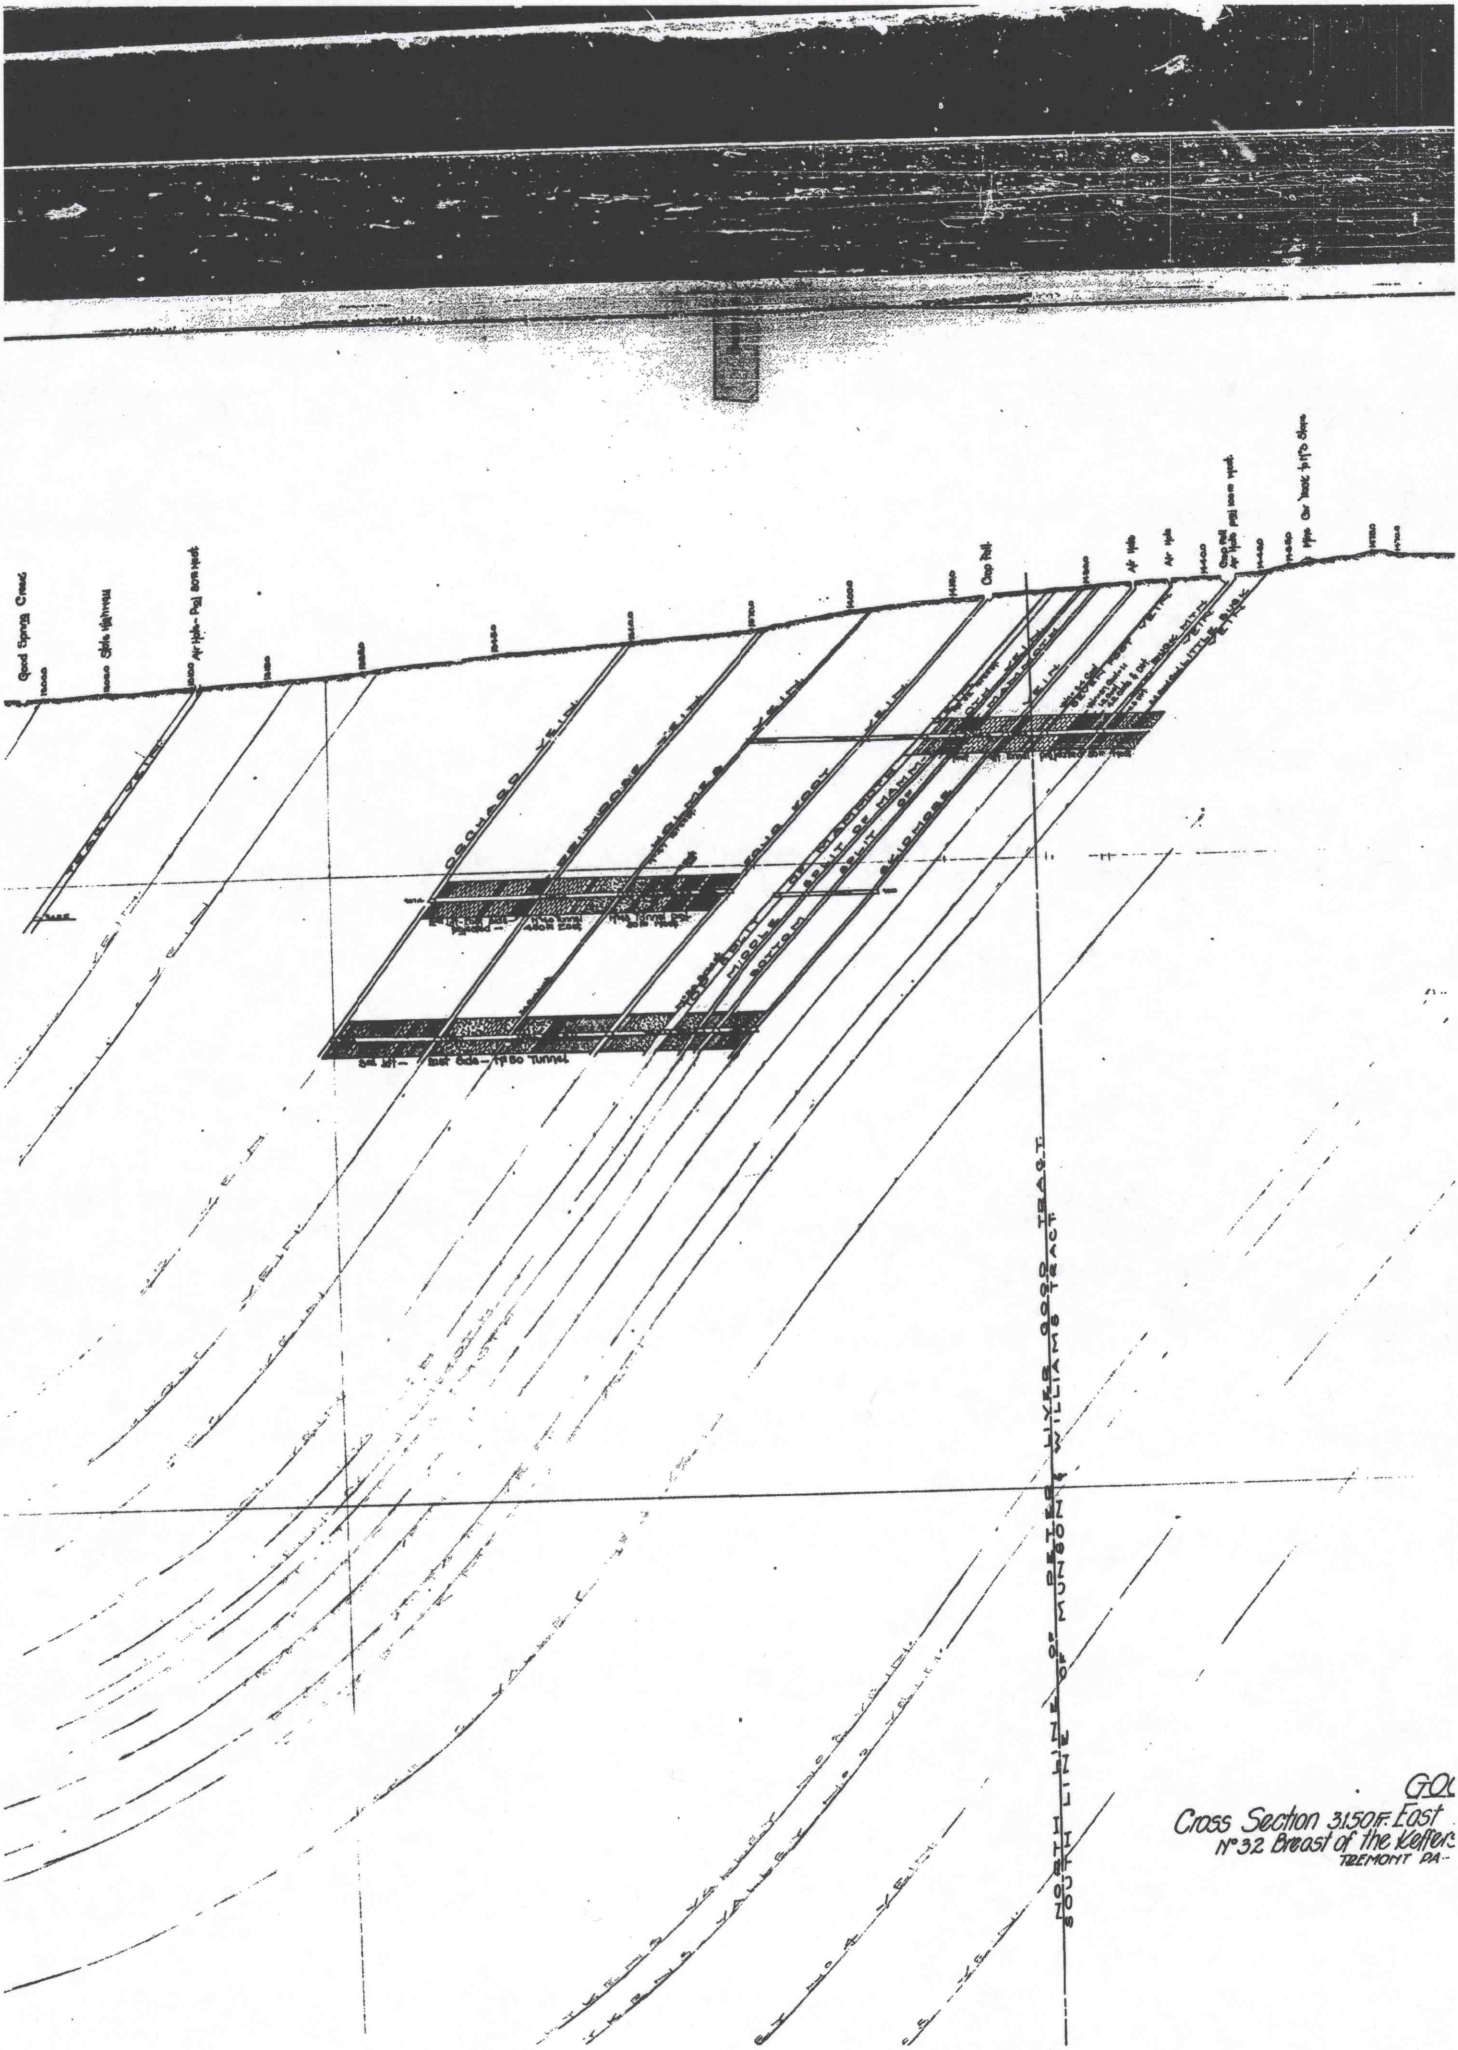
Good Spring Creek
Air Hole
Air Hole
Air Hole
Crop Pat
Crop Pat
Air Hole
Air Hole
Air Hole