


2248.8  
2248.1  
2248.4  
2248.7  
2248.4  
2247.8  
2245.0  
2242.0  
2234.7  
2232.4  
2237.6  
2236.1  
2232.2  
2230.0  
2231.2  
2230.1  
2230.0  
2230.2

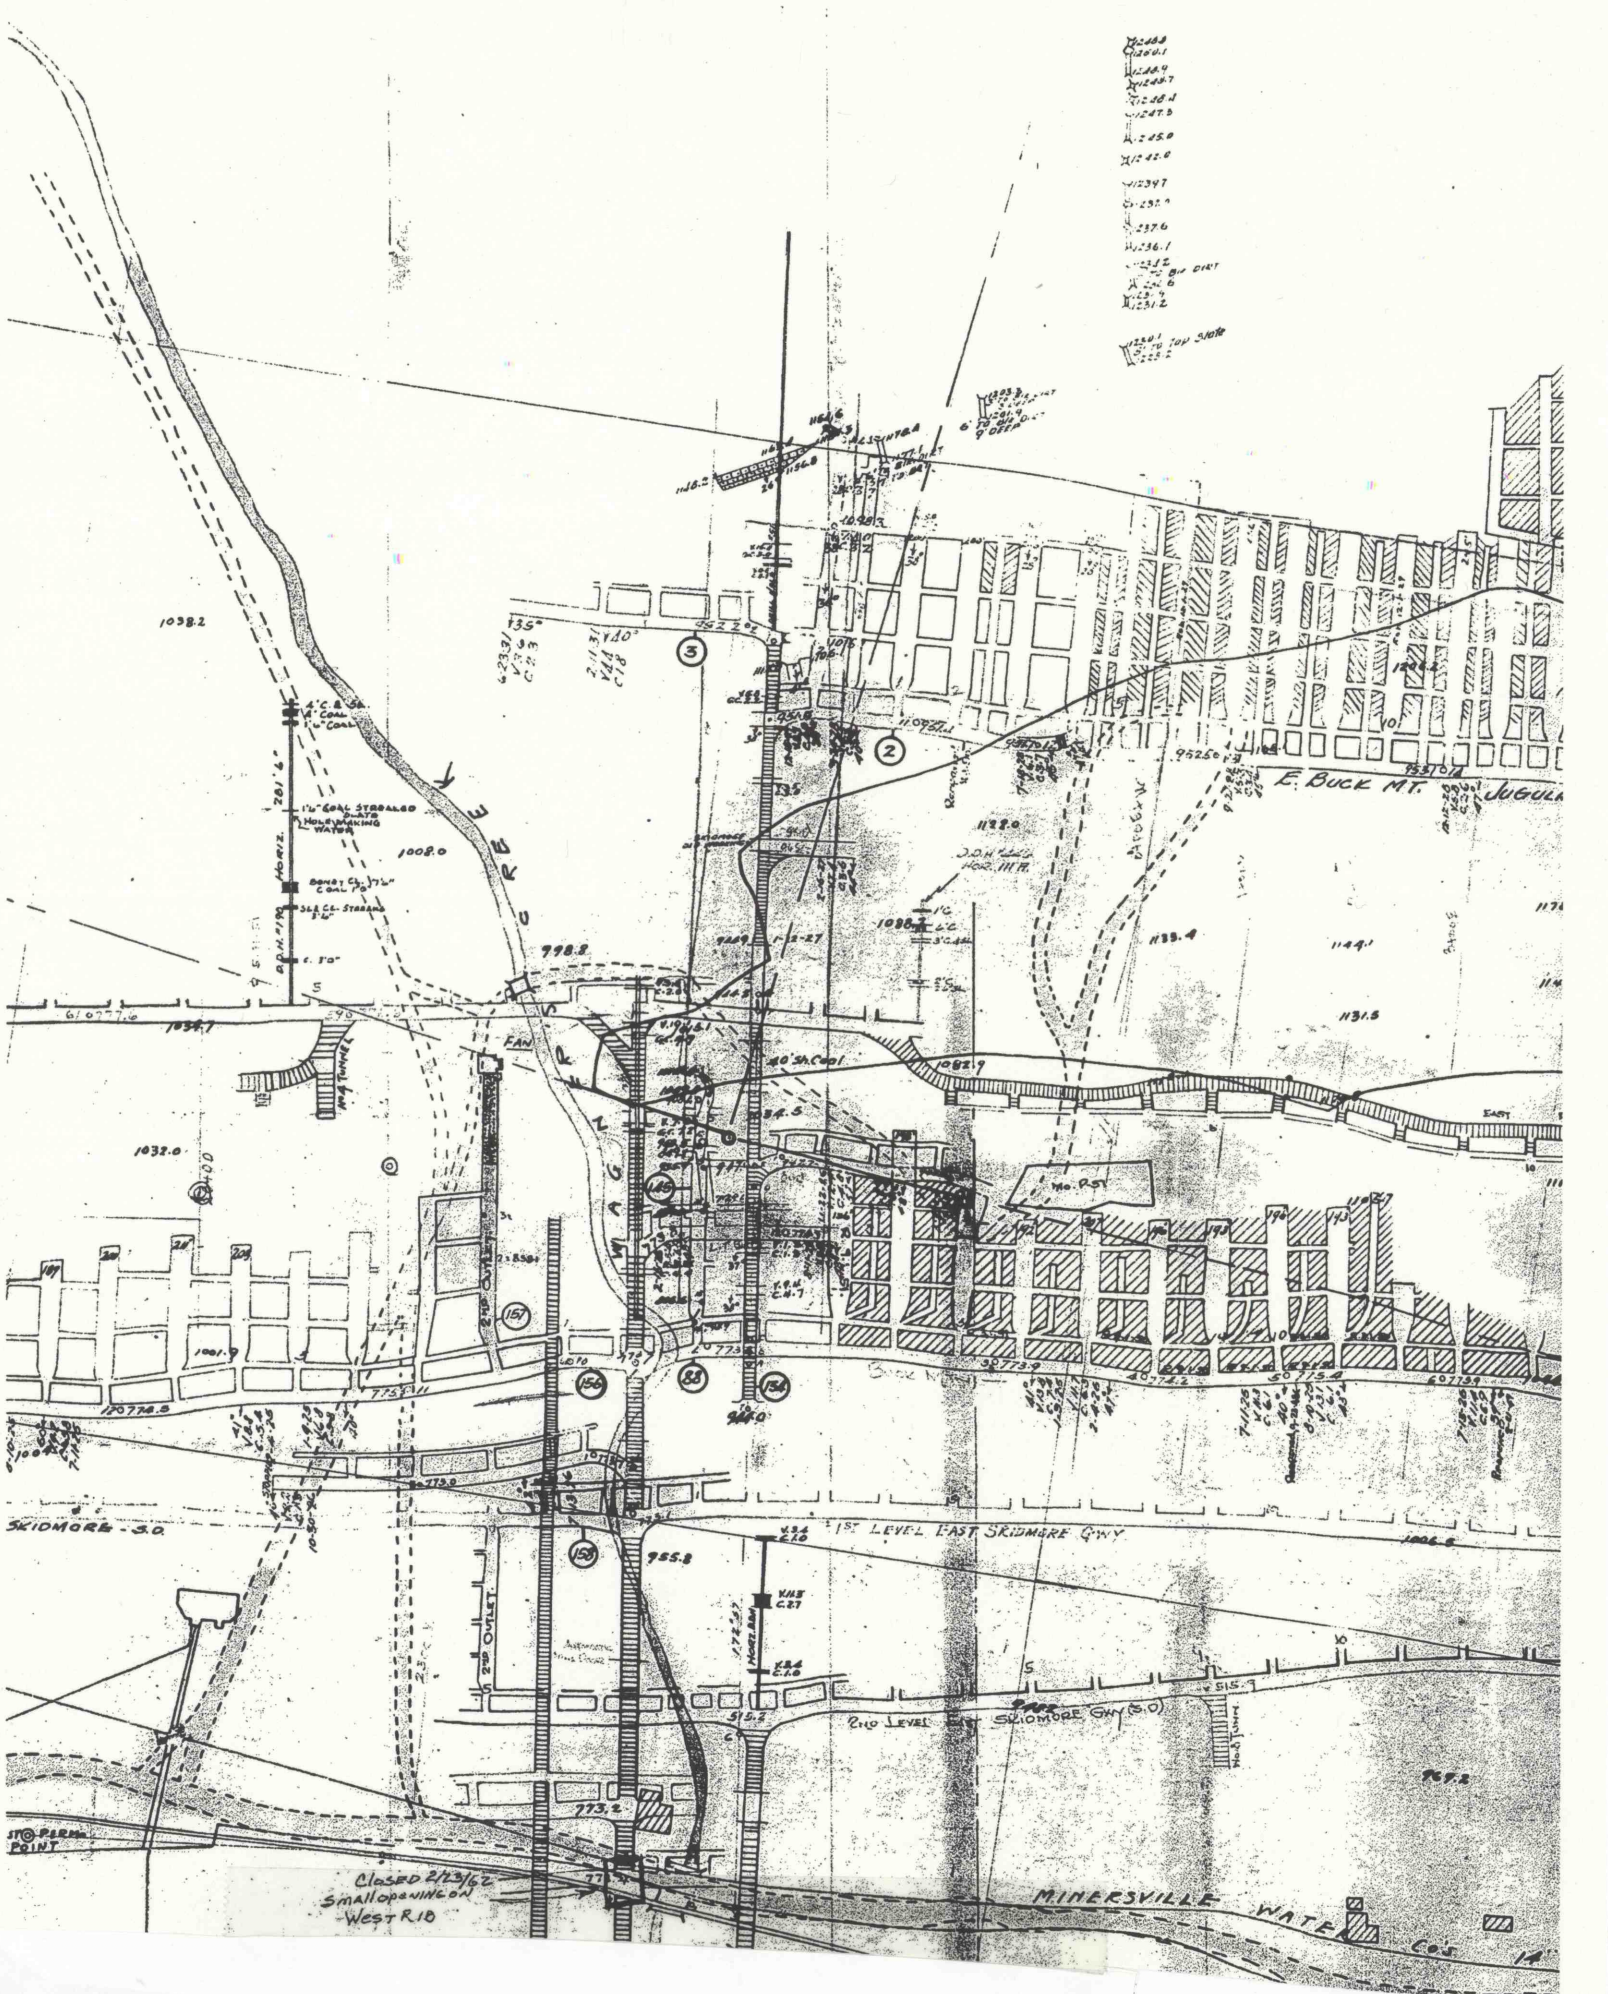

ST. PIERRE  
POINT  
CLOSED 2/23/62  
SMALL OPENING ON  
WEST R.D.

MINERSVILLE WATER  
CO.