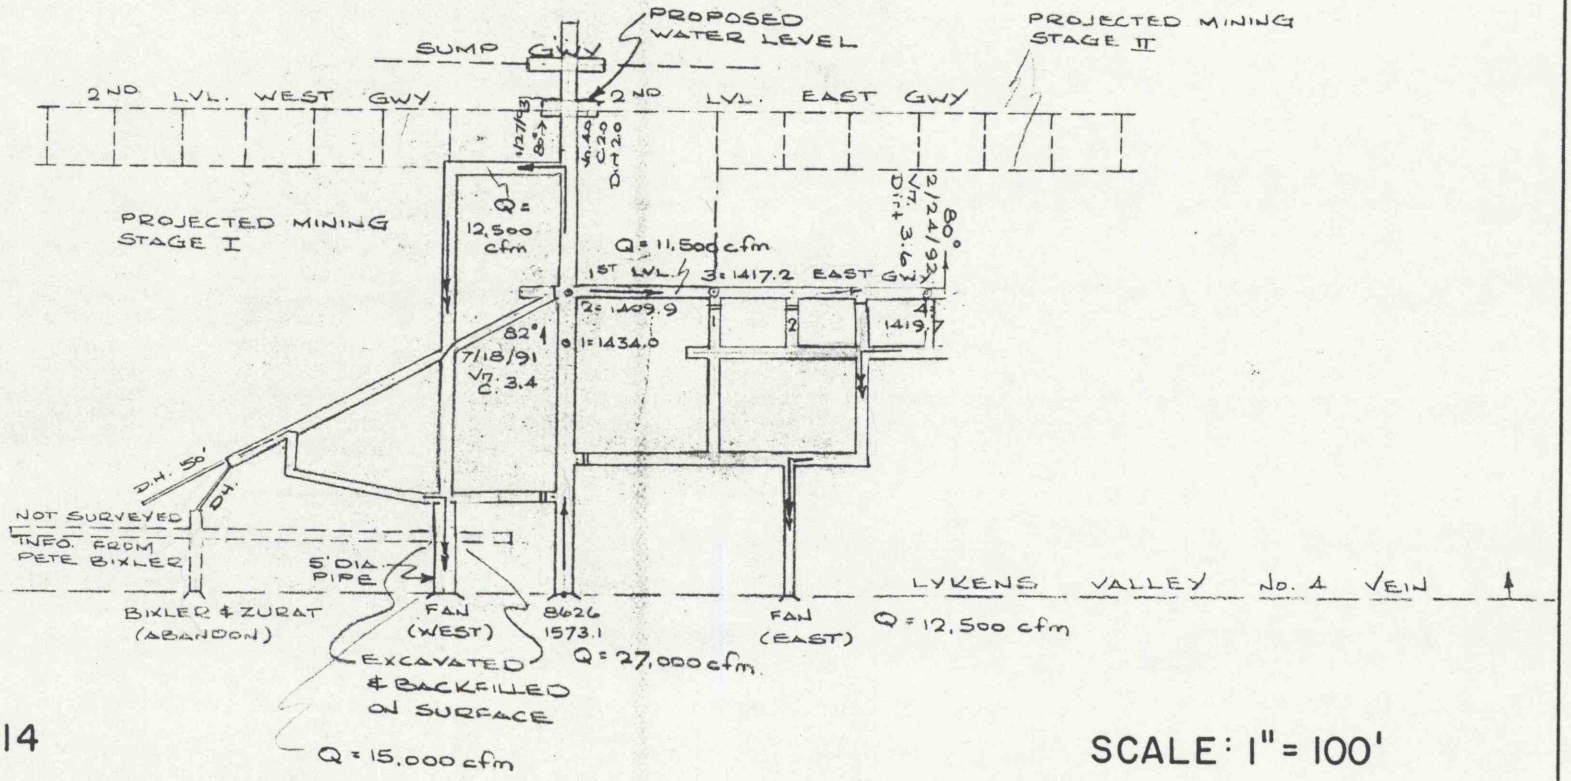

MSHA I.D.# 36-08014

SCALE: 1" = 100'

ON VEIN SECTION or VIEW OF THE LV COAL COMPANY's No. 4 Slope

David L Williams

REVISED 1/27/93

PORTER TOWNSHIP SCHUYLKILL COUNTY PENNSYLVANIA