


21 f 21

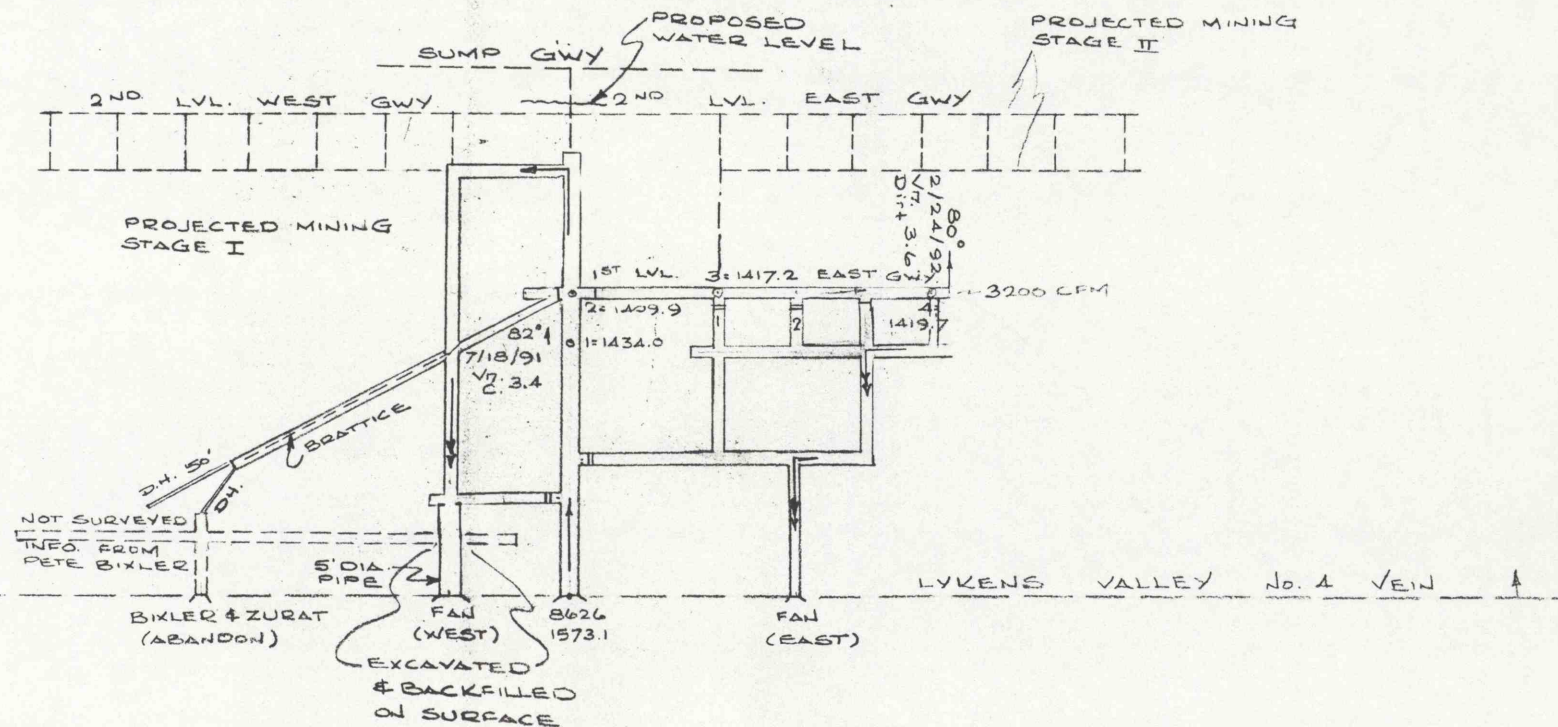

MSHA I.D.# 36-08014

SCALE: 1" = 100'

ON VEIN SECTION or VIEW OF THE
LV COAL COMPANY's No. 4 Slope

REVISED 11/23/92

PORTER TOWNSHIP

SCHUYLKILL COUNTY

PENNSYLVANIA