


Good Spring Colliery No 3 Slope workings

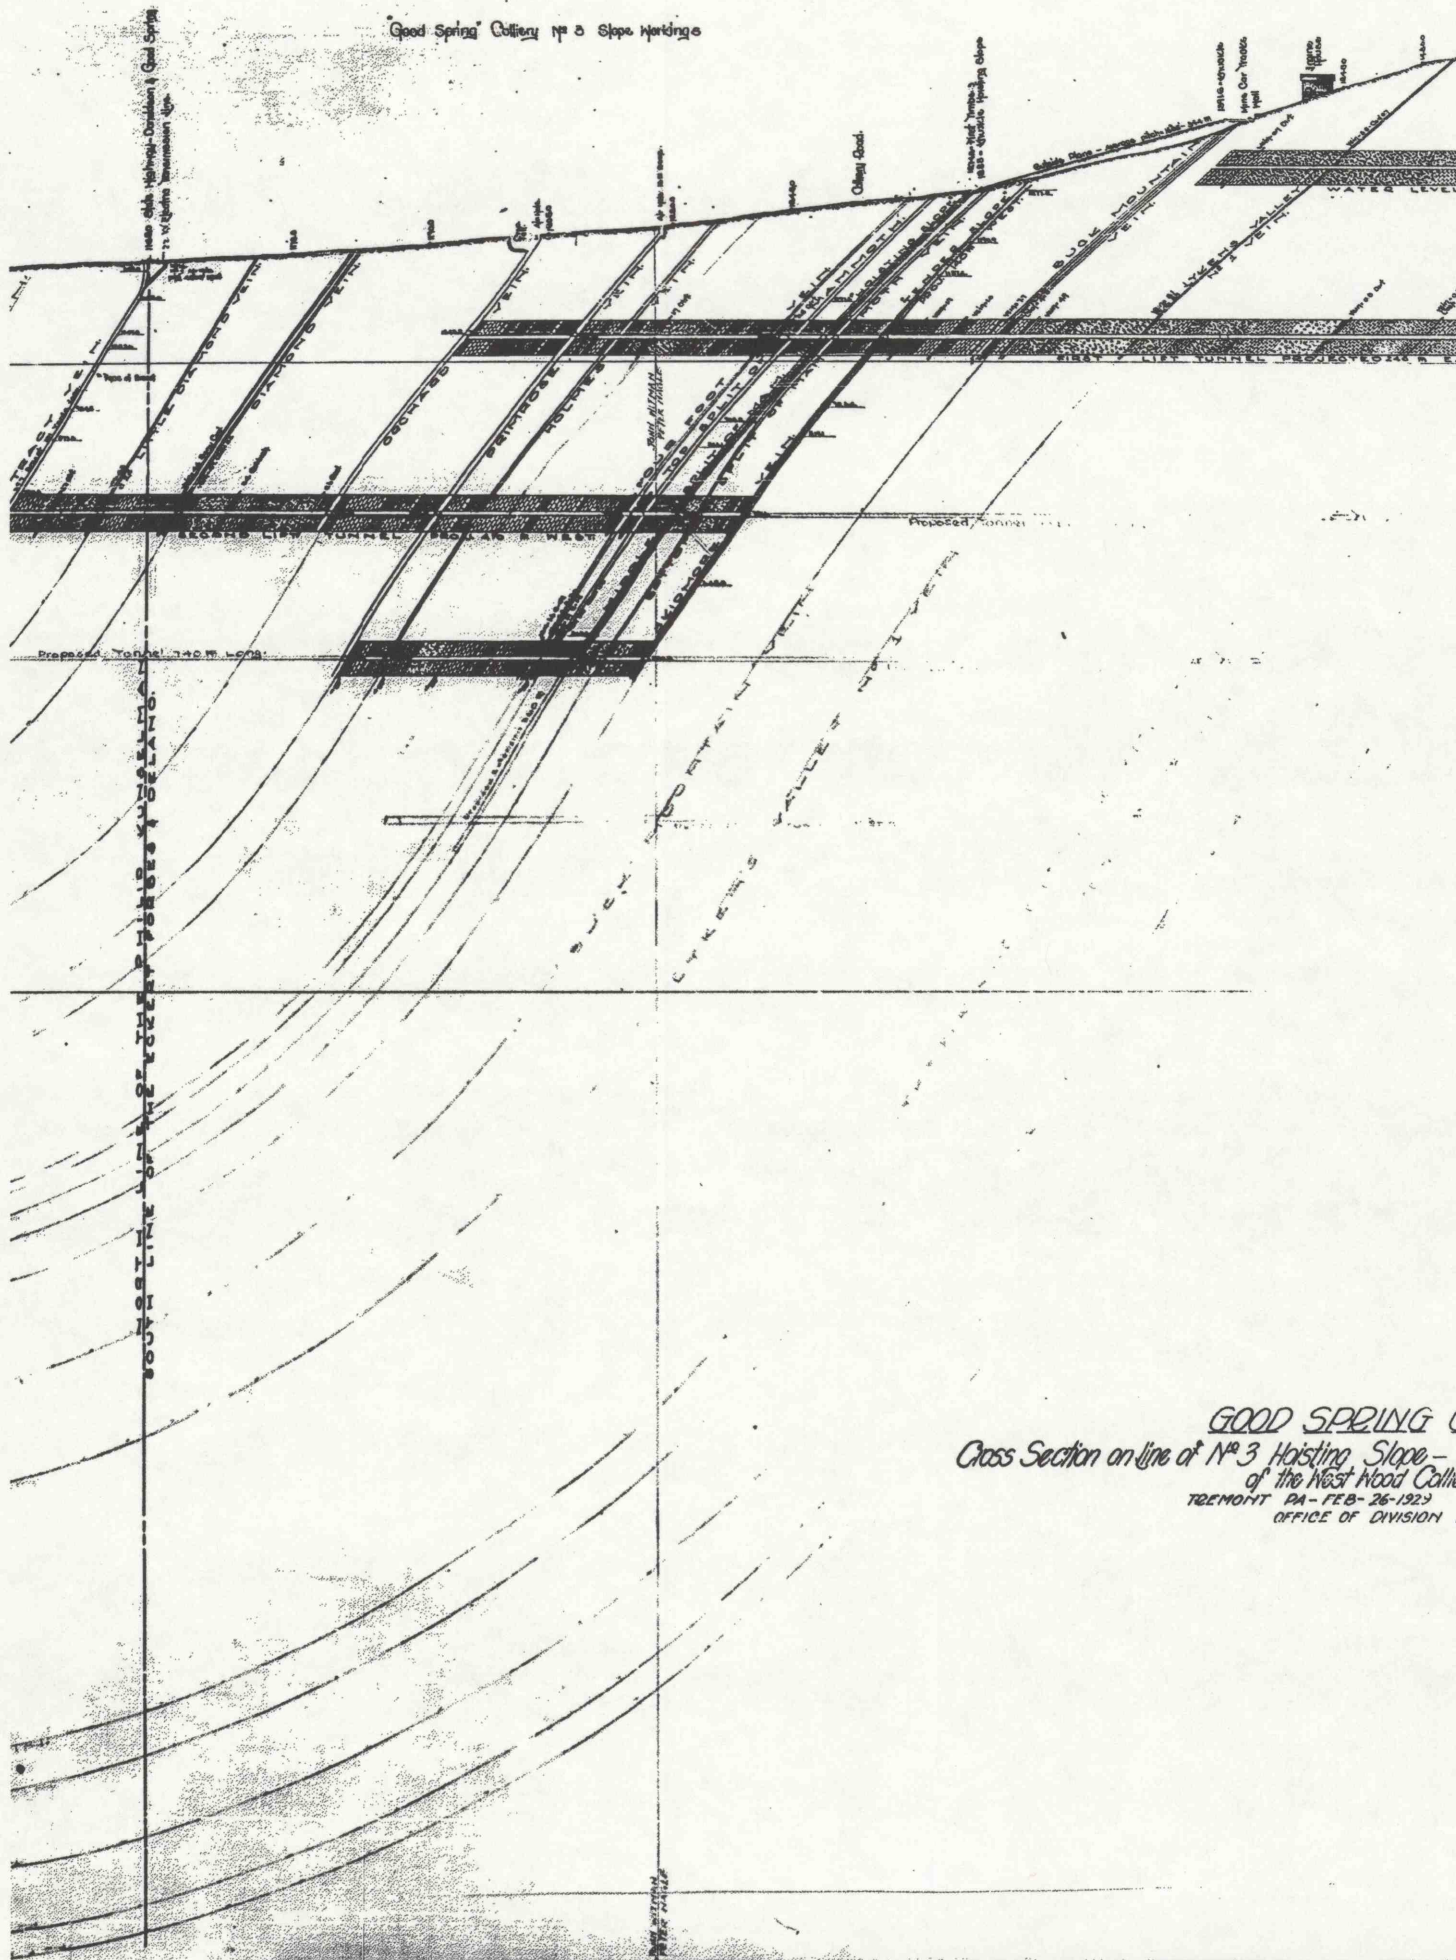

GOOD SPRING C
Cross Section on line of No 3 Hoisting Slope -
of the West Wood Colliery
TREMONT PA - FEB - 26 - 1929
OFFICE OF DIVISION