
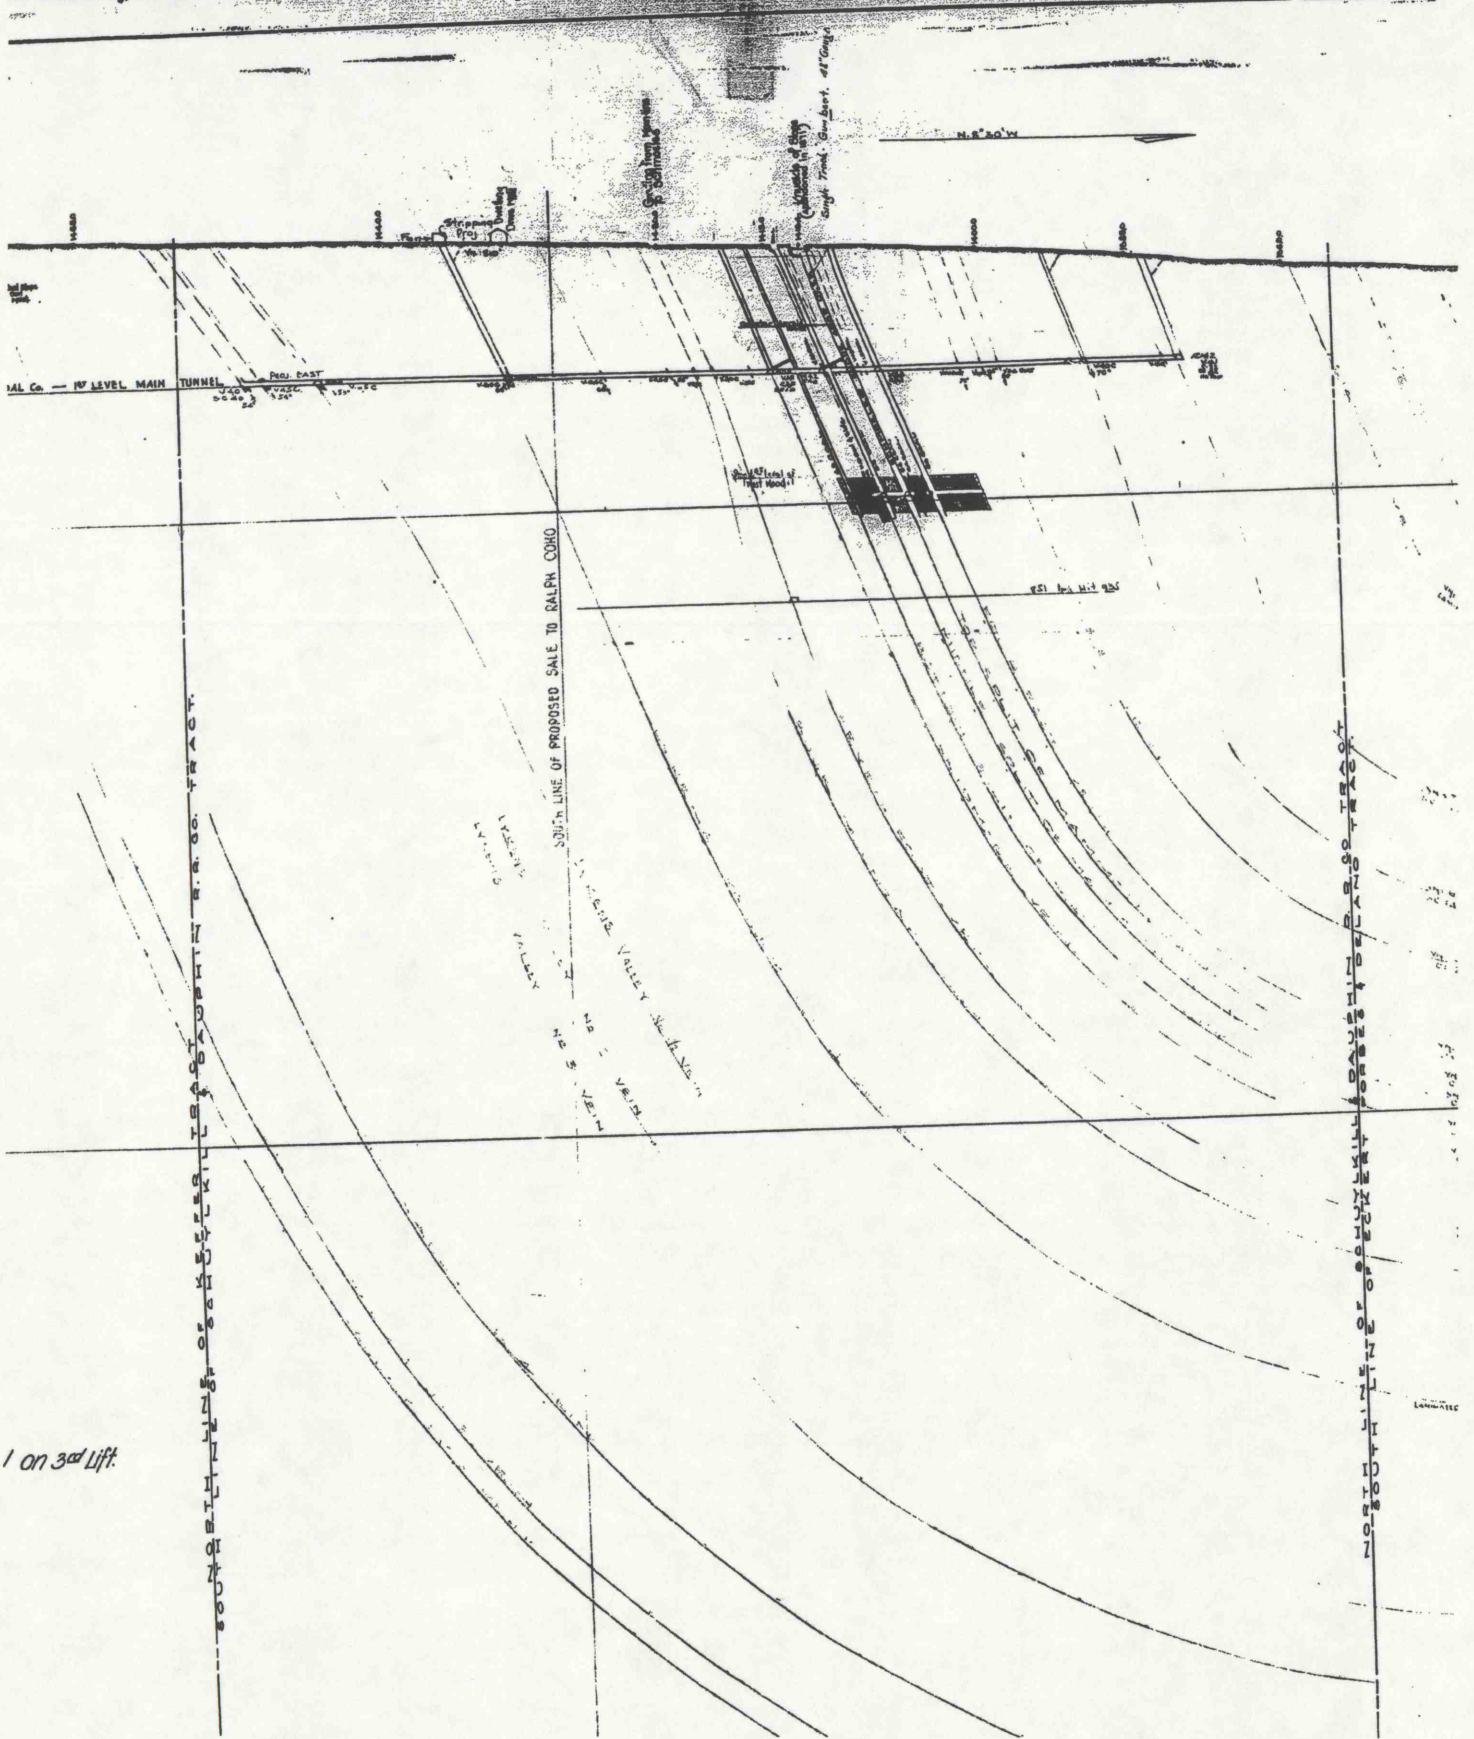


 

1 on 3rd Lift