


K.R.K. SLOPE
 I.D. NO. 36-06031
 K.R.K. COAL COMPANY
 RAVINE, SCHUYLKILL COUNTY, PA.
 SCALE-1"=100' DATE- MAY 13, 1981

1628

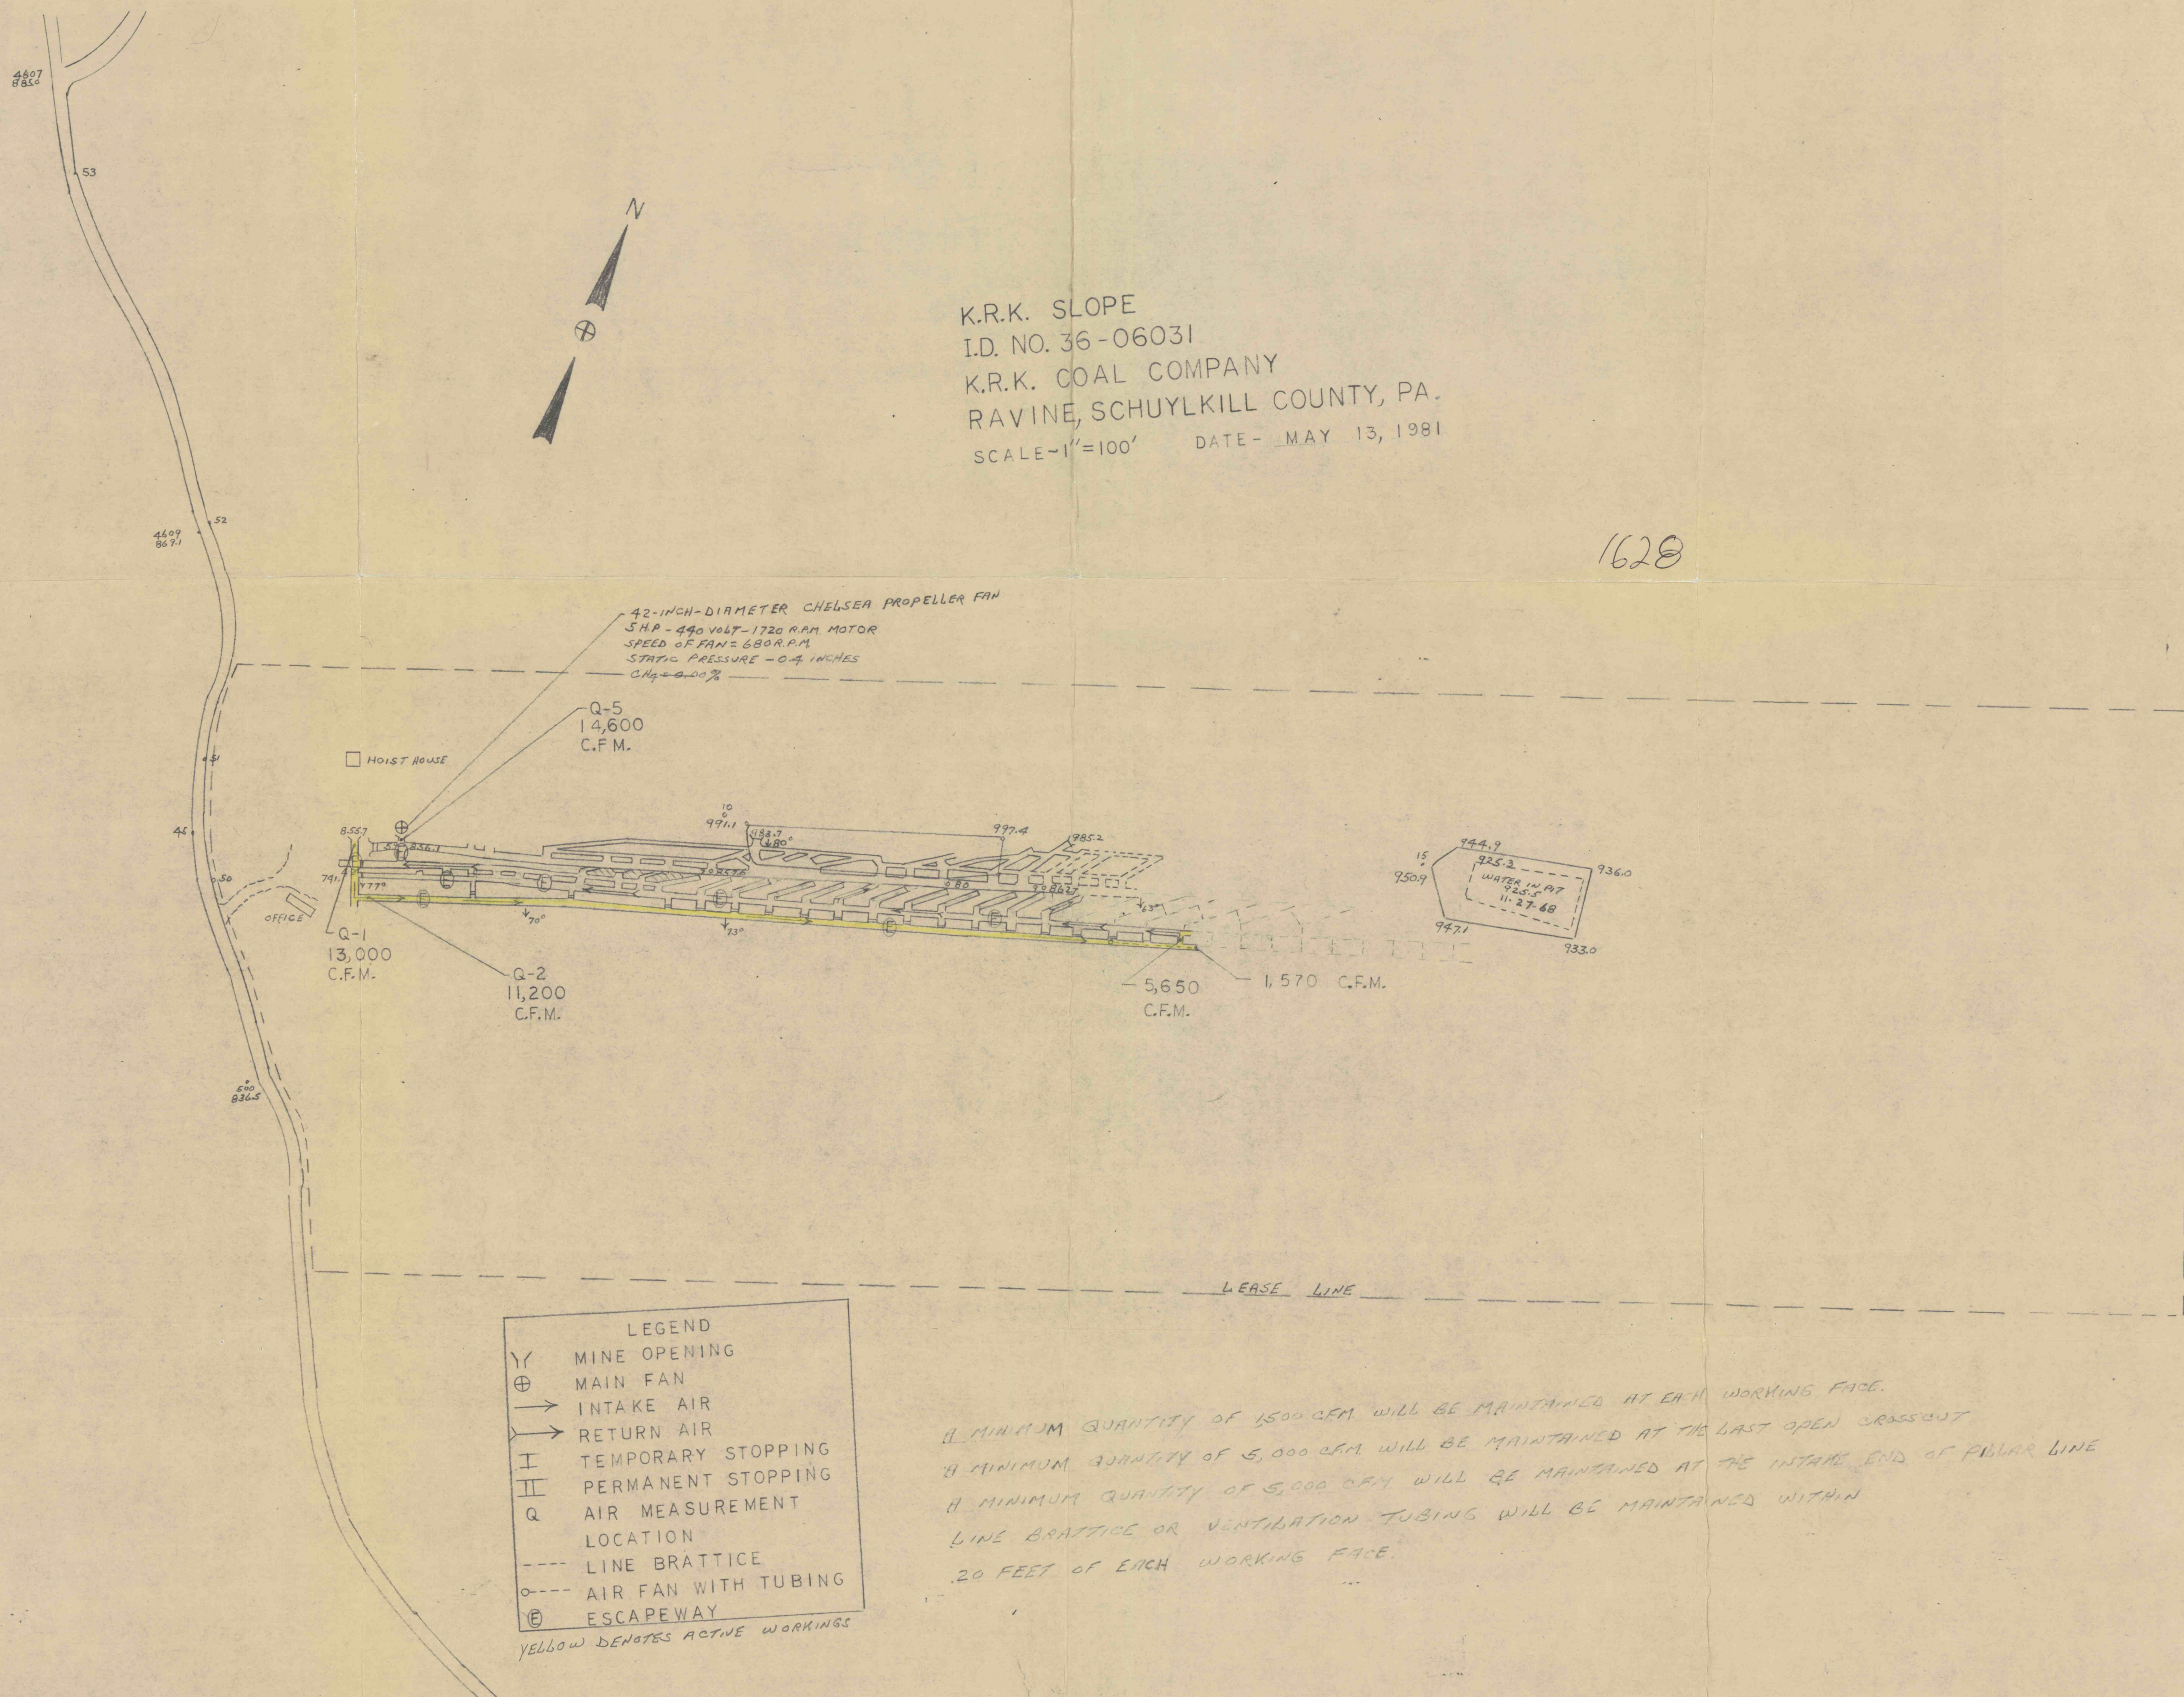

A MINIMUM QUANTITY OF 1500 CFM WILL BE MAINTAINED AT EACH WORKING FACE.
 A MINIMUM QUANTITY OF 5,000 CFM WILL BE MAINTAINED AT THE LAST OPEN CROSSCUT
 A MINIMUM QUANTITY OF 5,000 CFM WILL BE MAINTAINED AT THE INTAKE END OF PBLAR LINE
 LINE BRATTICE OR VENTILATION TUBING WILL BE MAINTAINED WITHIN
 20 FEET OF EACH WORKING FACE.