


2046
91567.9

GIBSON, HARNER &
MADESFORD
LN NO 2 LN
NOW
WEST END COAL CO DEEP MINE
ID# 36-97859

LEASE LINE

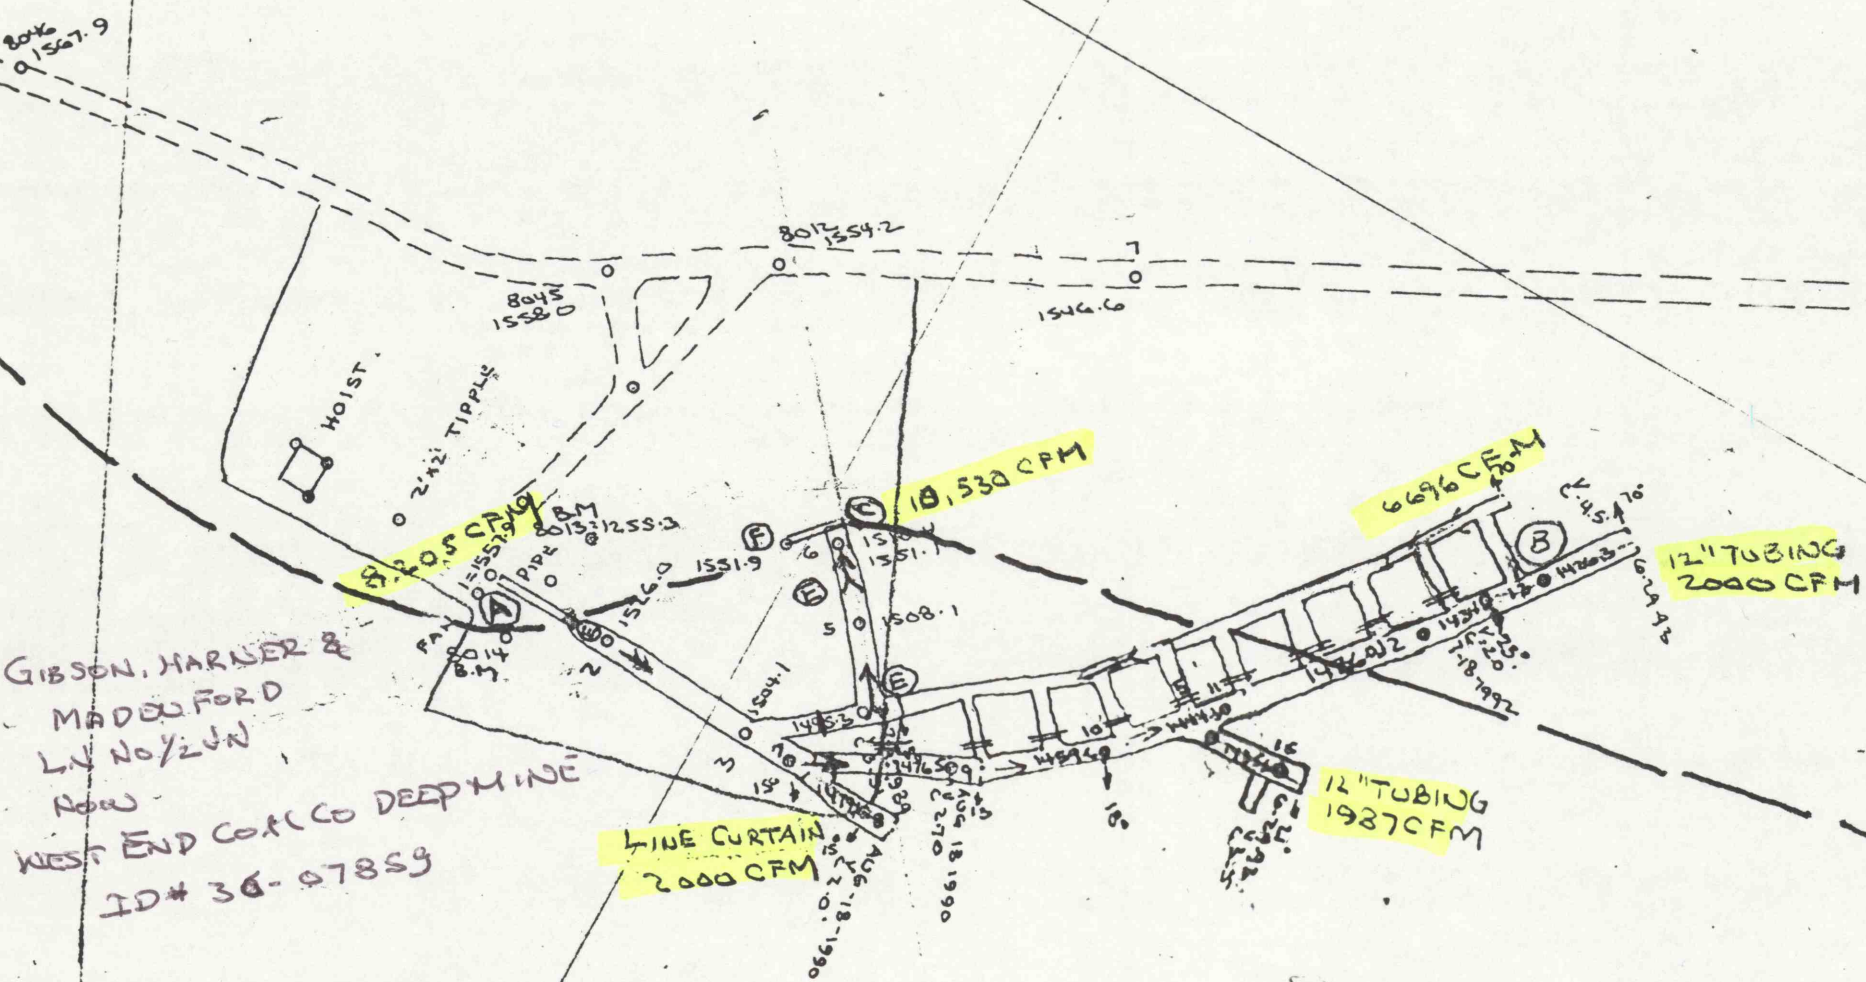

Walter Manhart