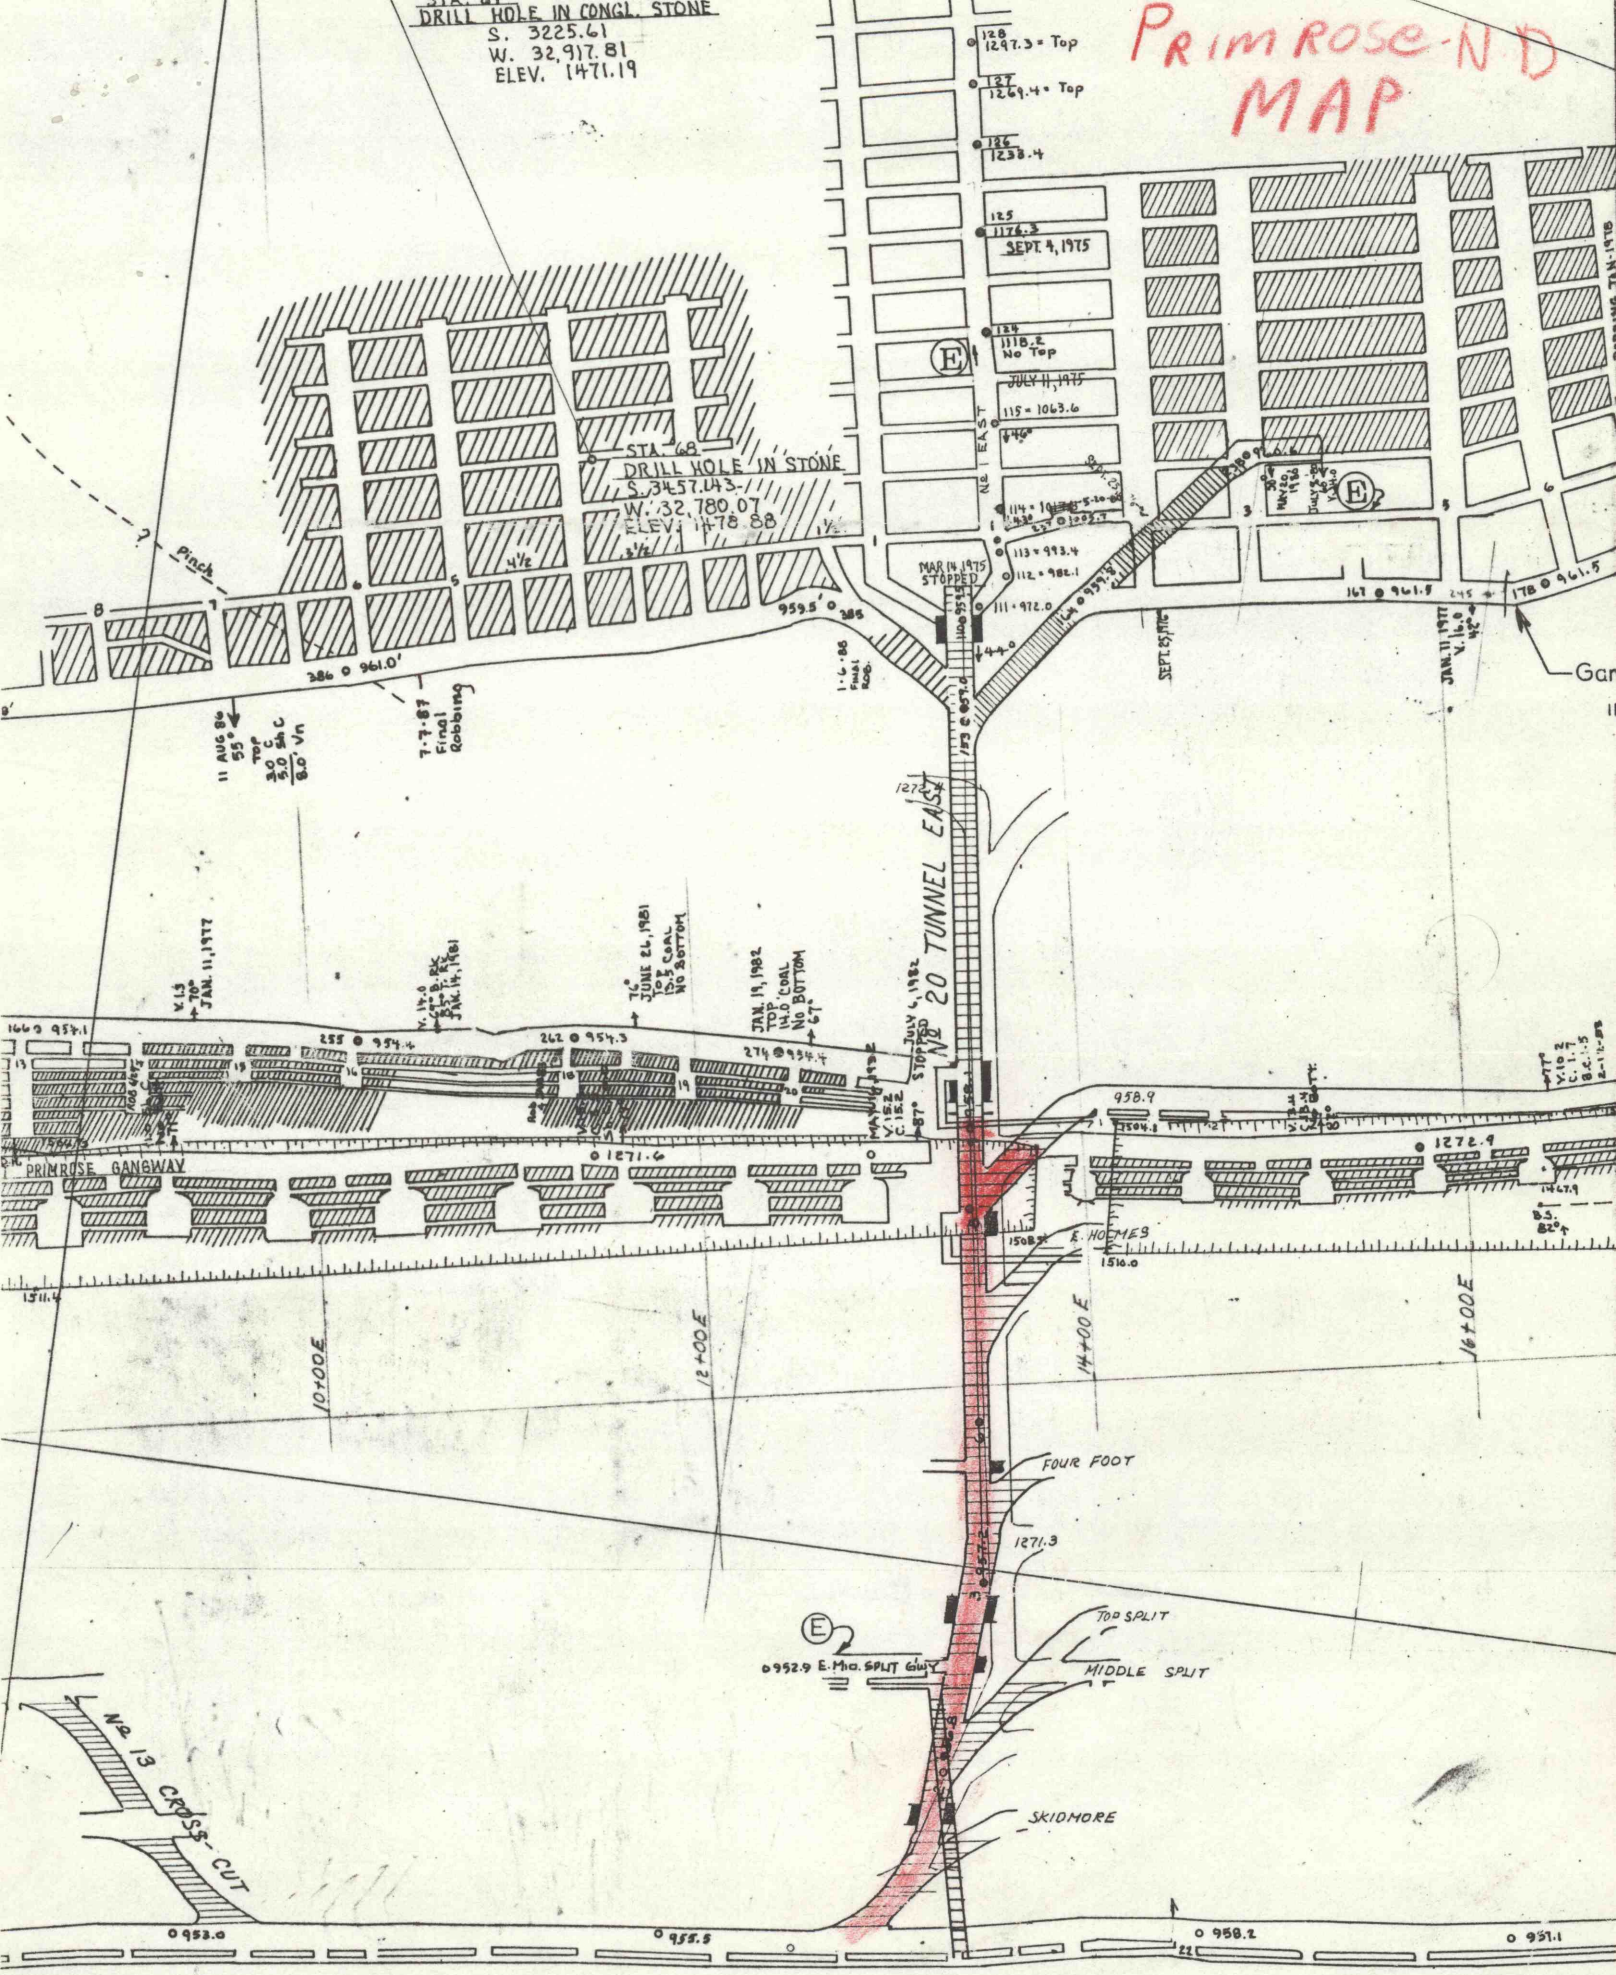
PRIMROSE-N.D MAP
DRILL HOLE IN CONGL. STONE
S. 3225.61
W. 32,917.81
ELEV. 1471.19
STA. 68
DRILL HOLE IN STONE
S. 3457.143
W. 32,780.07
ELEV. 1478.88
128 1297.3 = Top
127 1269.4 = Top
126 1238.4
125 1176.3
SEPT. 4, 1975
124 1118.2 No Top
JULY 11, 1975
115 = 1063.6
114 = 1013.3
113 = 993.4
112 = 982.1
111 = 972.0
MAR 14, 1975 STOPPED
NE EAST
Pinch
11 AUG 80 55° Top 3.0 Sh C 8.0 Vn
7-7-87 Final Robbing
1-6-88 Final Rob.
SEPT 15, 1976
JAN. 11, 1977
Gar
NE 20 TUNNEL EAST
JAN. 11, 1977
JUNE 26, 1981 10.5 COAL No BOTTOM
JAN. 19, 1982 TOP COAL 14.0 No BOTTOM
JULY 4, 1982 STOPPED
PRIMROSE GANGWAY
E. HOLMES
10+00E
12+00E
14+00E
16+00E
FOUR FOOT
1271.3
TOP SPLIT
MIDDLE SPLIT
E. Mid. SPLIT GW
SKIDMORE
NE 13 CROSS-CUT
0 952.0
0 955.5
0 958.2
0 951.1