


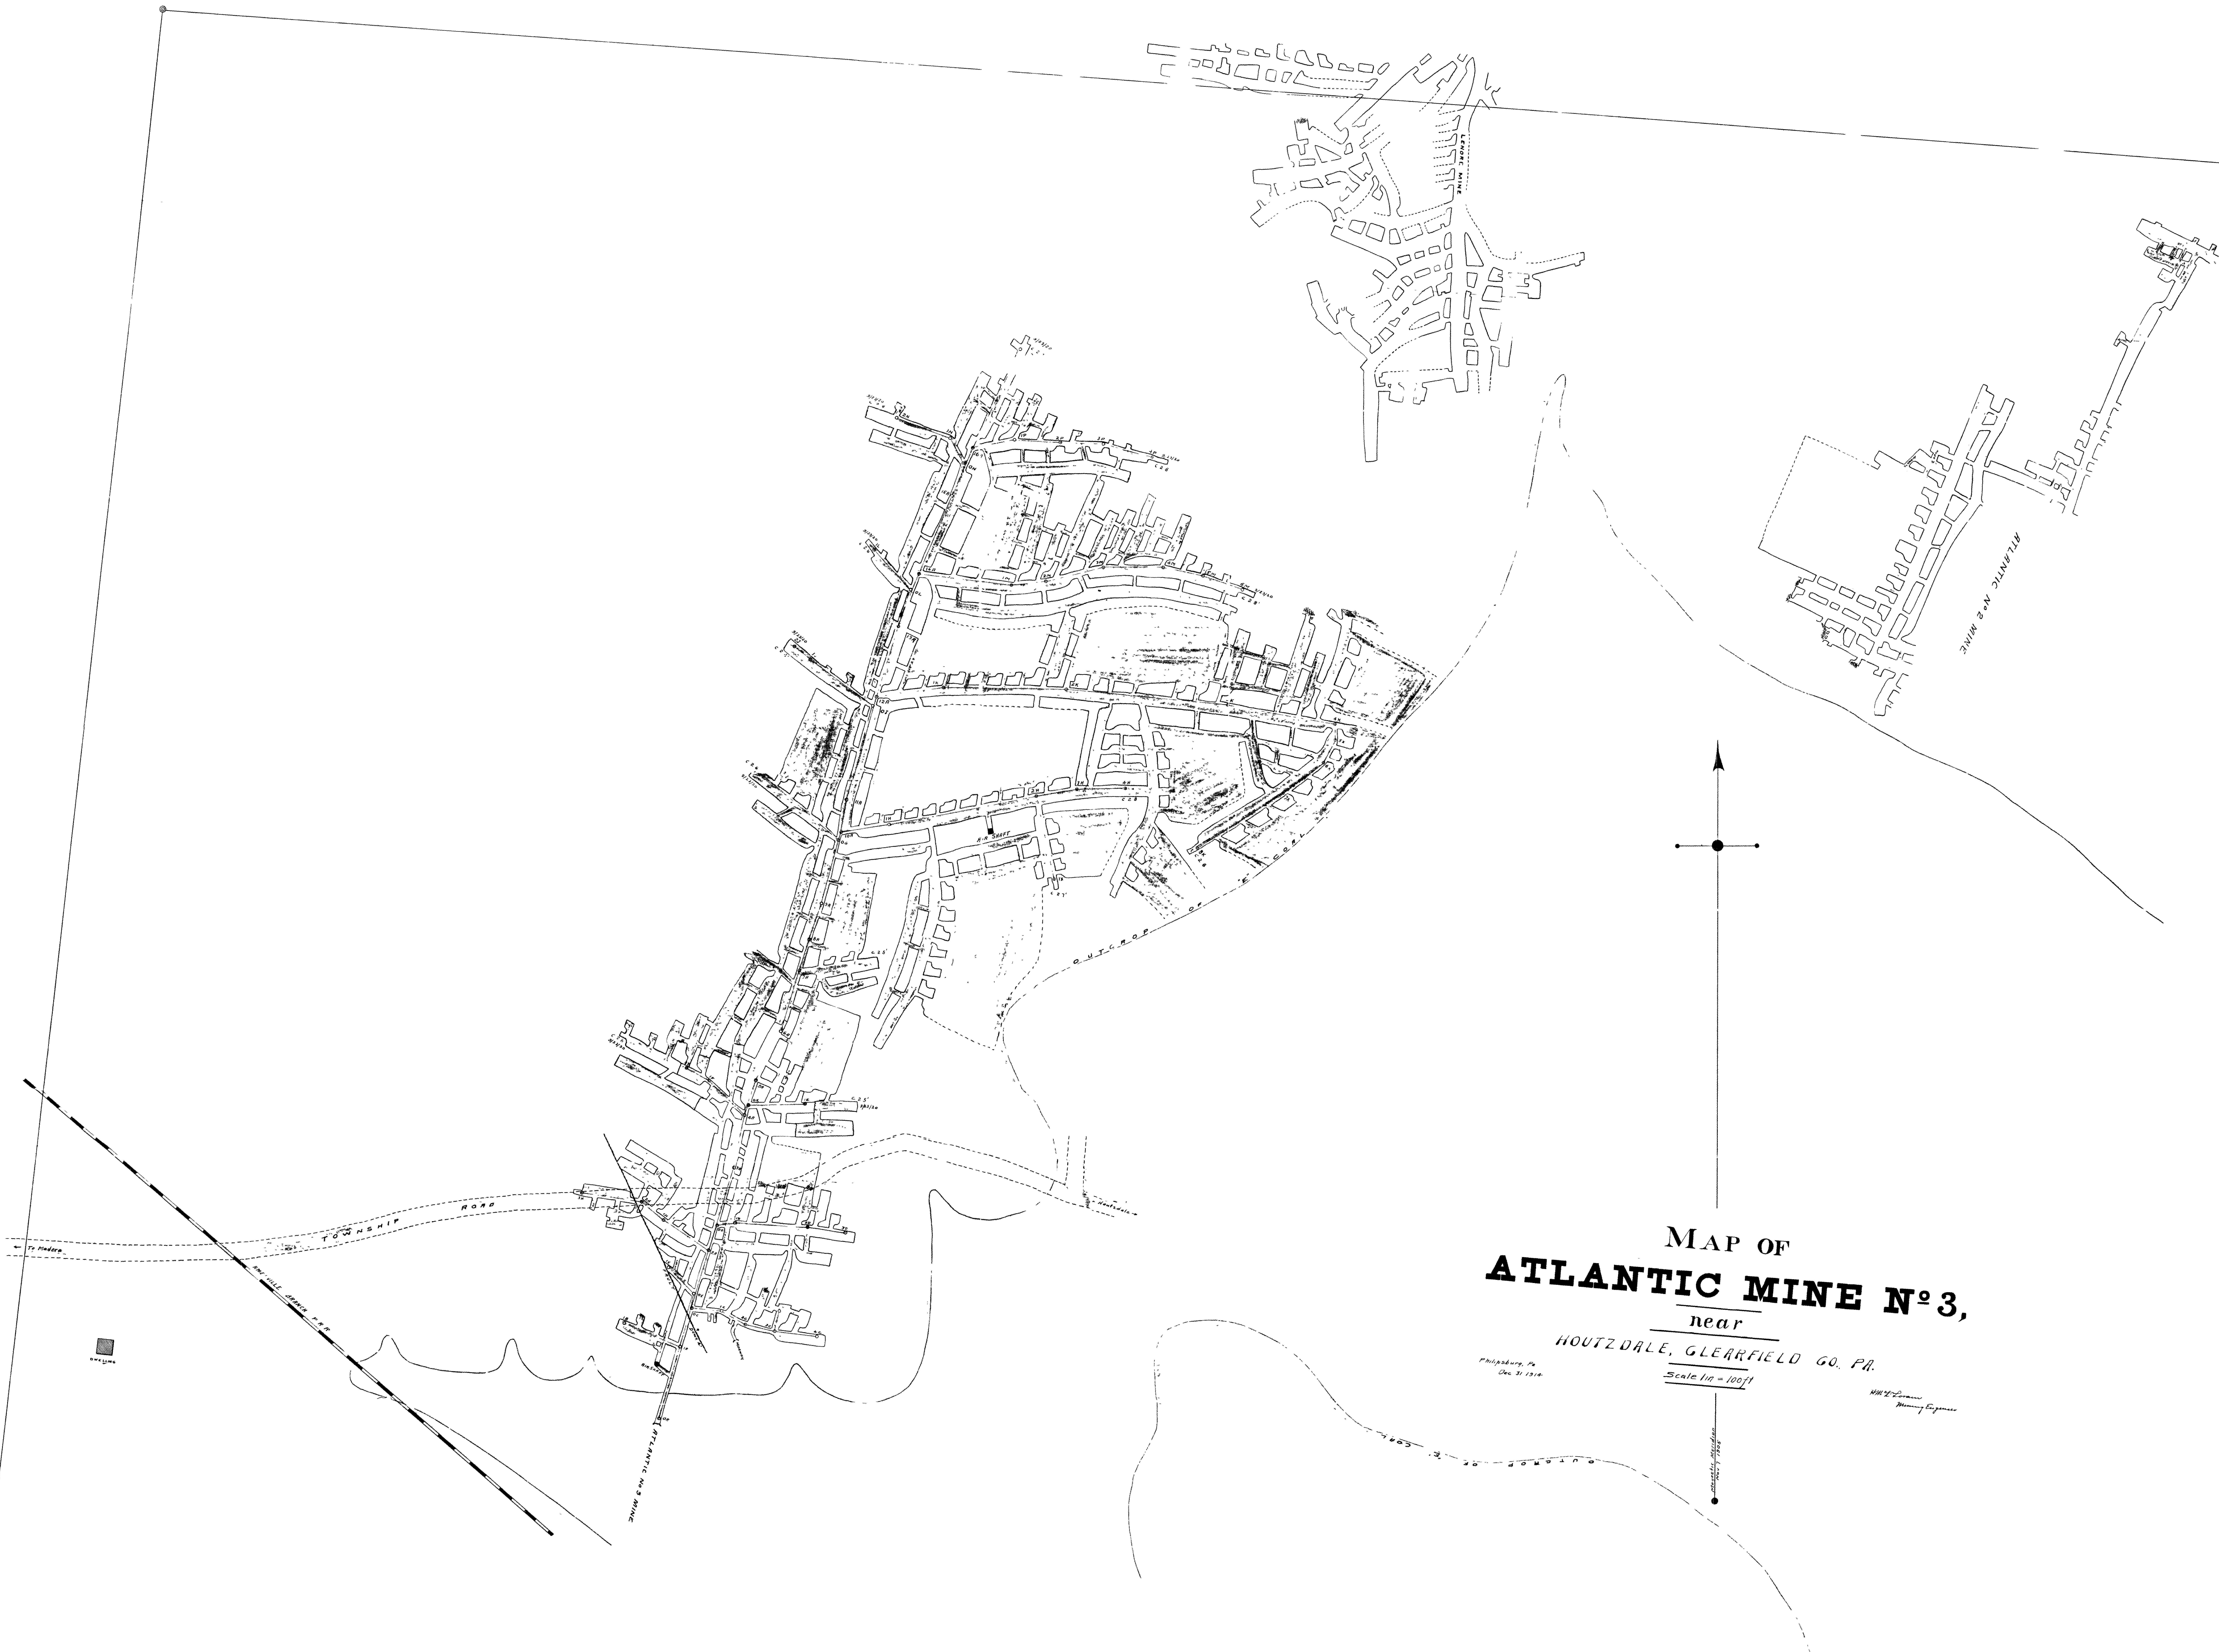

MAP OF
ATLANTIC MINE N° 3,
near
HOUTZDALE, GLACFIELD CO. PA.
Philipburg, Pa.
Dec. 31 1914

Scale 1 in = 100 ft
H. W. P. Jones
Mining Engineer