


Map showing Mine workings of Barnett Seam on the Property of Geo. P. Foreman Property
Operated By L. Shauf
Jan 1959 E. Corrie Engr 1"=100'

BARNETT SEAM
GEO. P. FOREMAN PROPERTY
L. SHAUF, OPER.

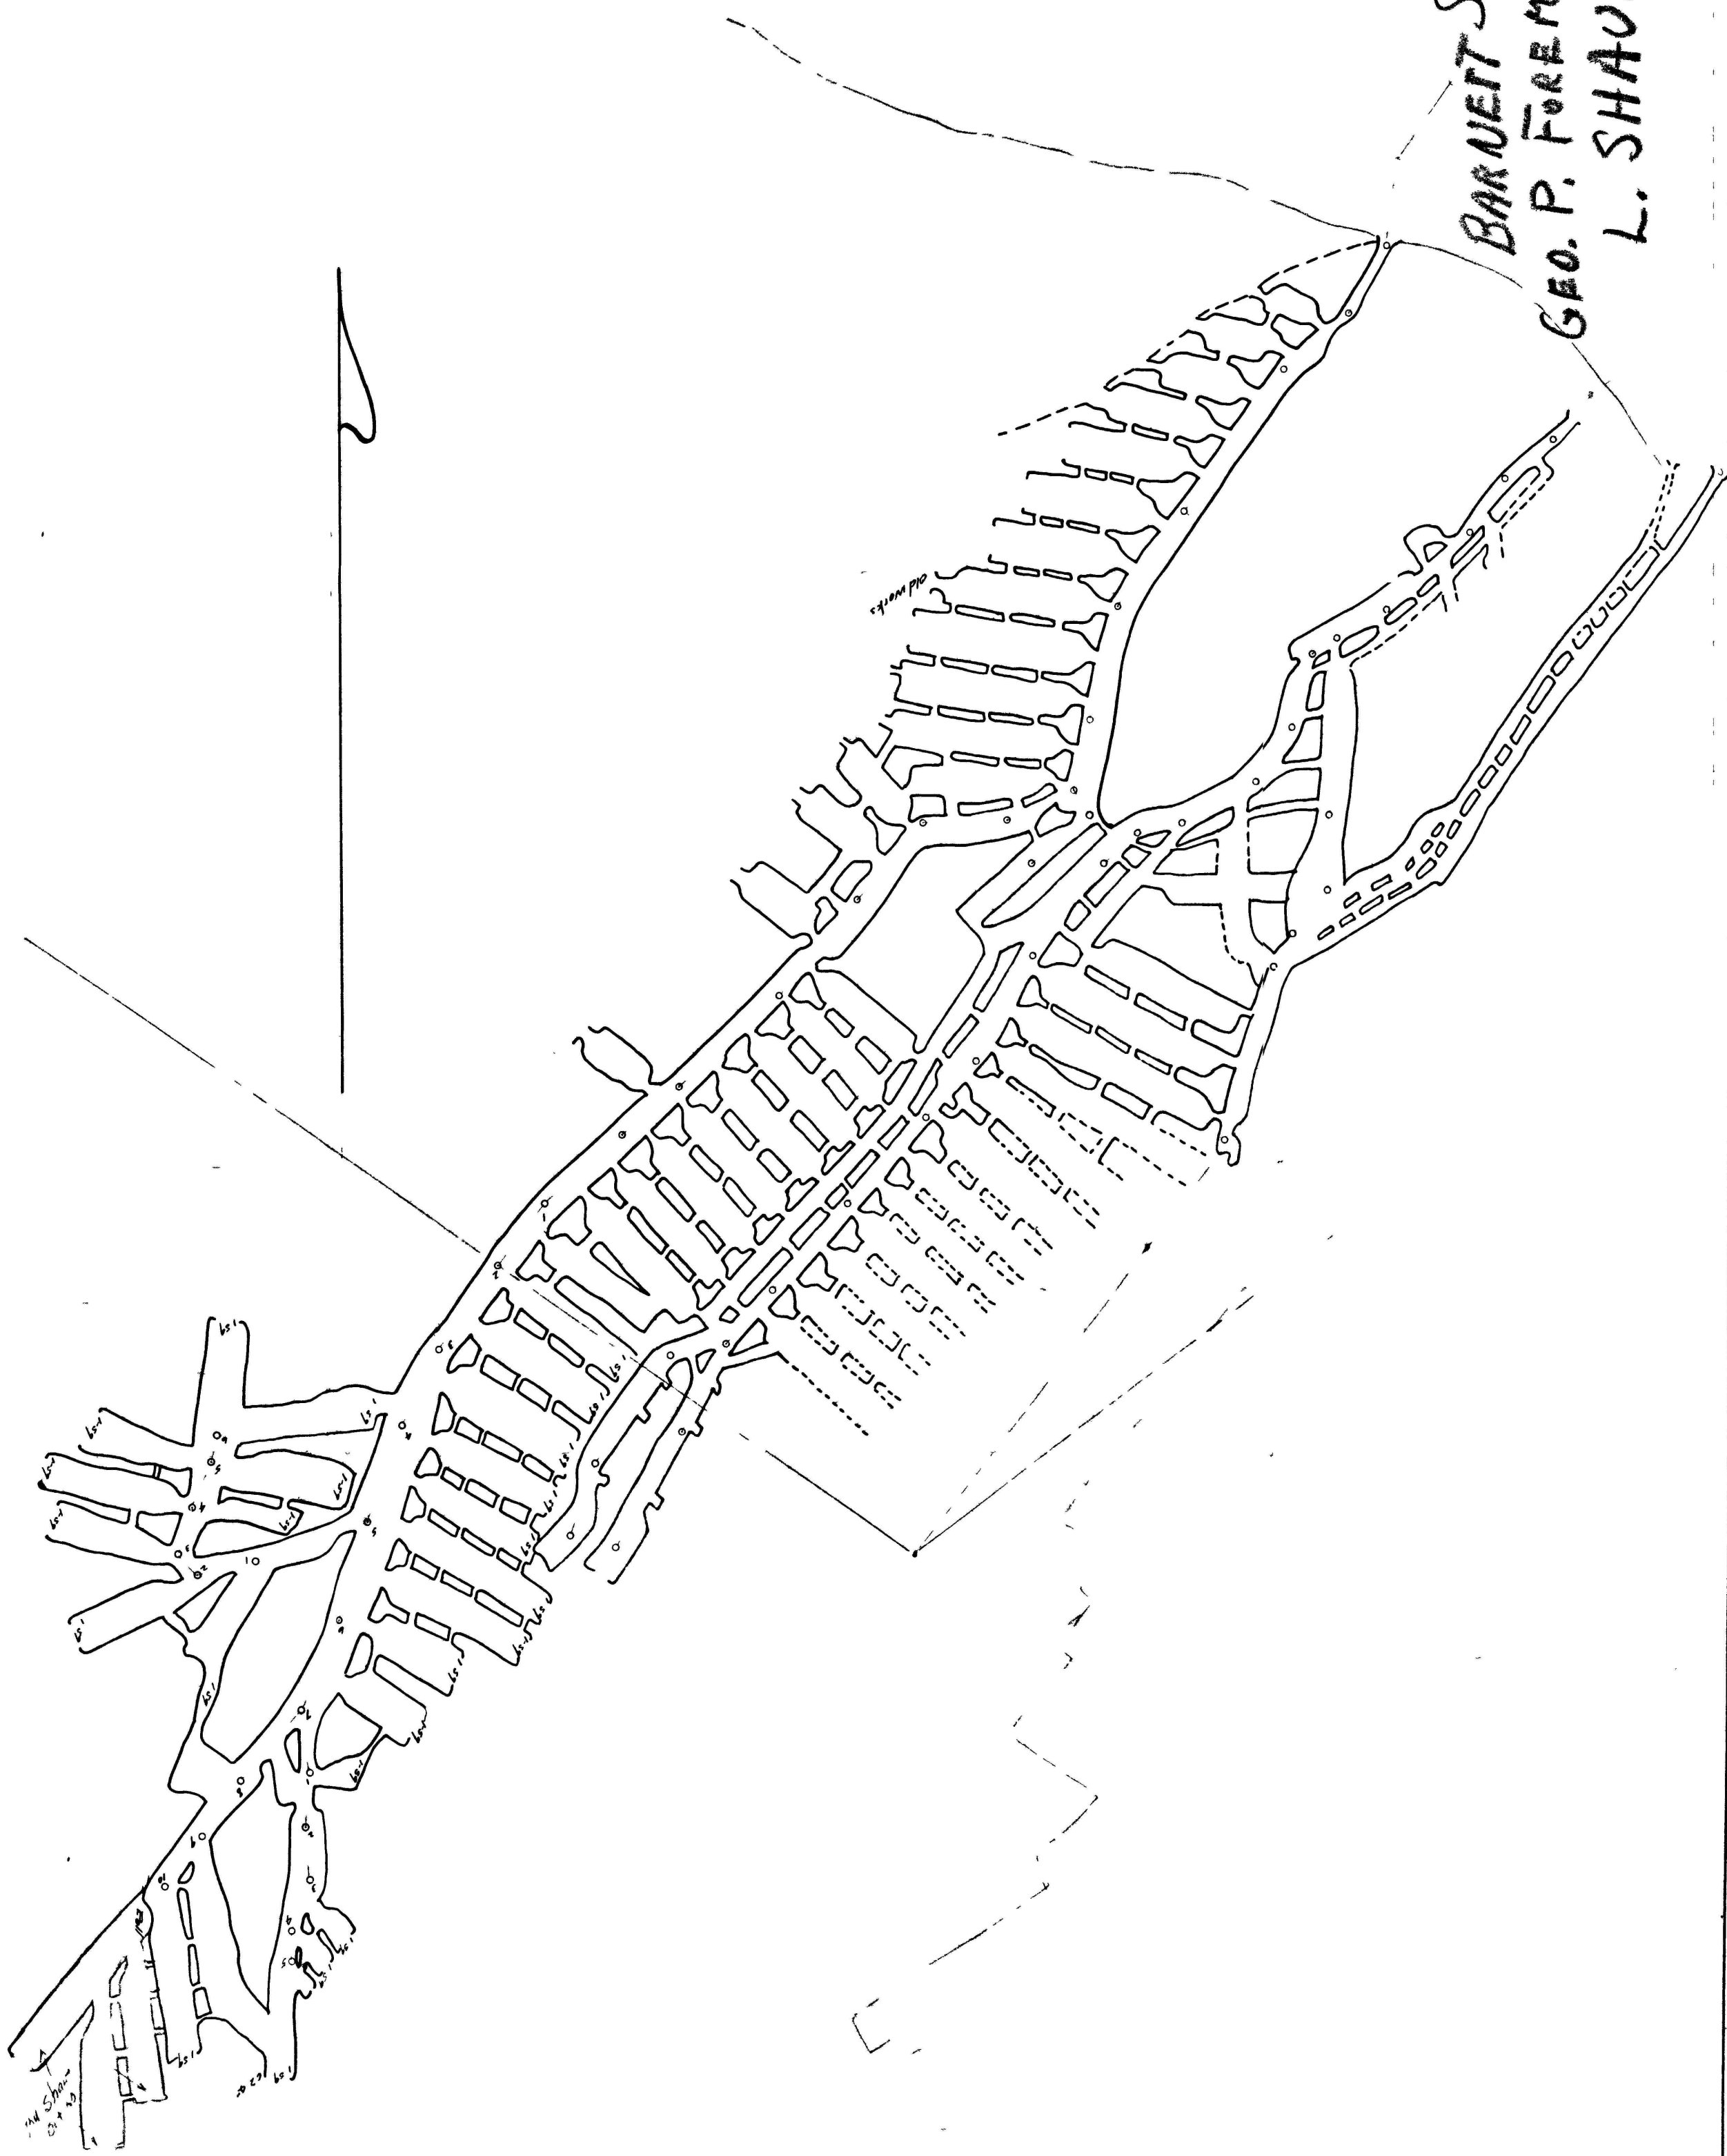

Line of Kelly working.