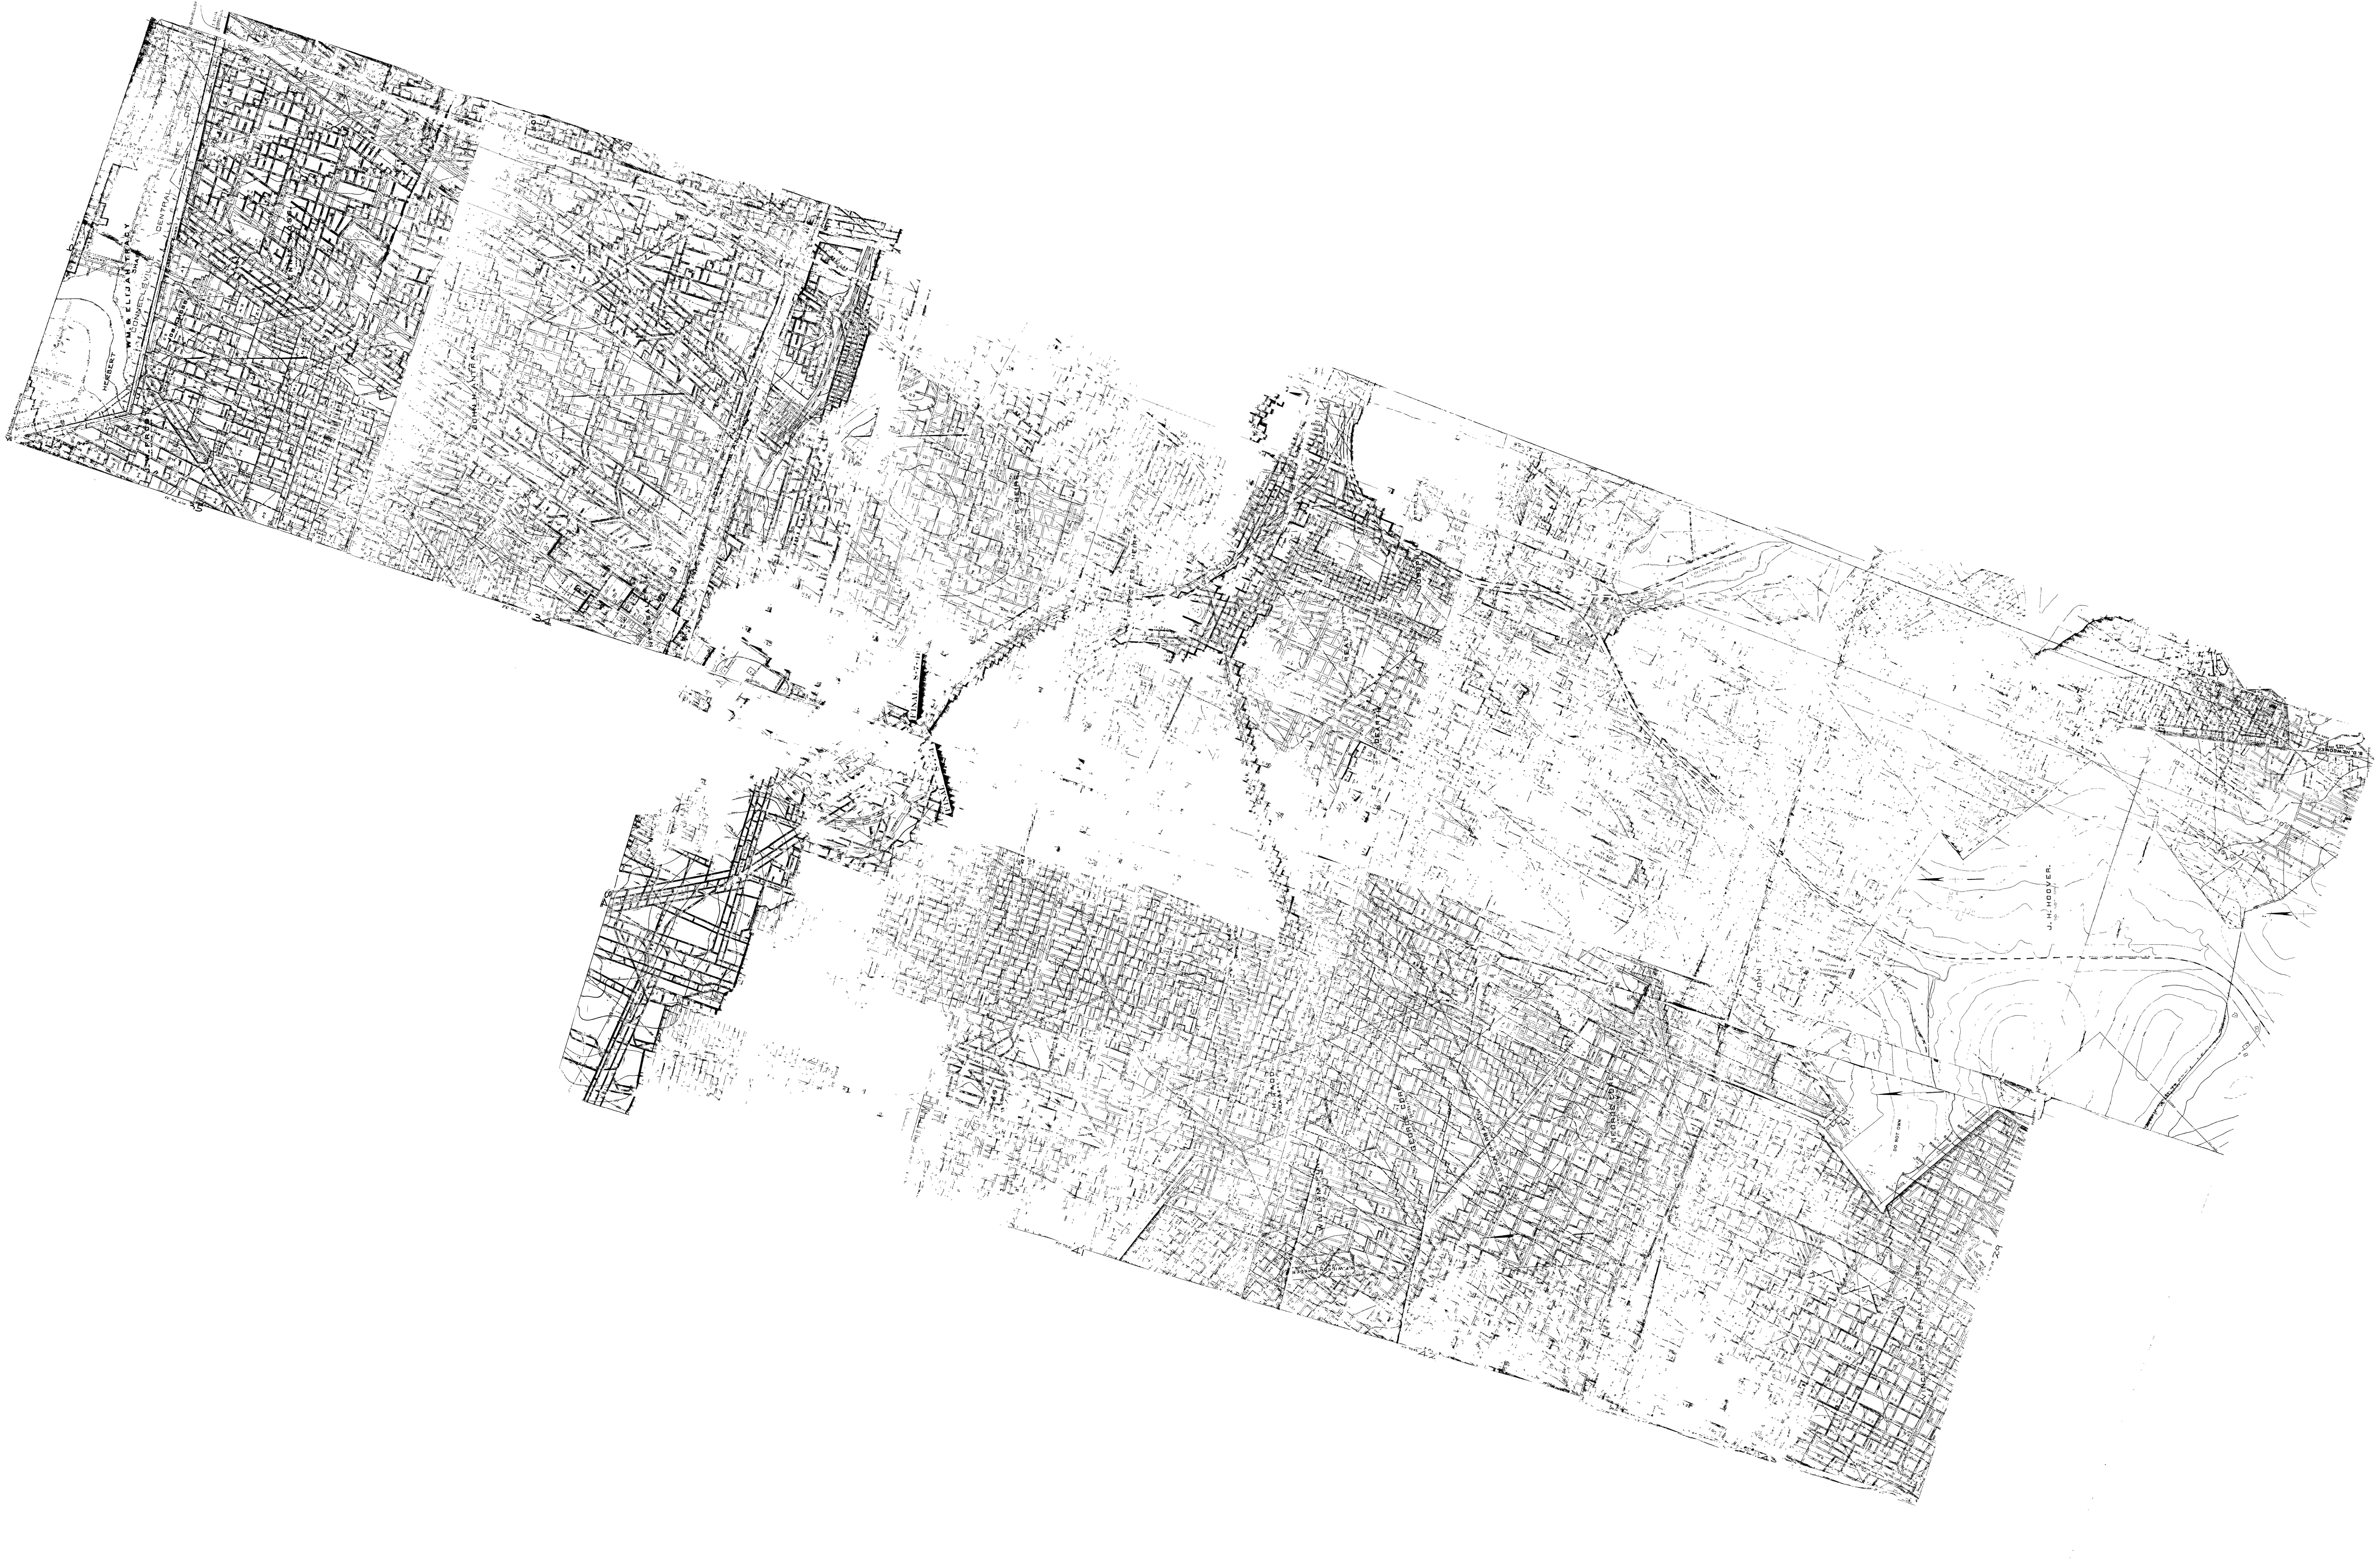
WM. & ELIJAH TRACY
CENTRAL
CONNELLSVILLE
COKE CO.
HERBERT
JOHN H. ANTRAM
J. H. HOOVER.
CONNELLSVILLE & MONONGAHELA R.R.
35