


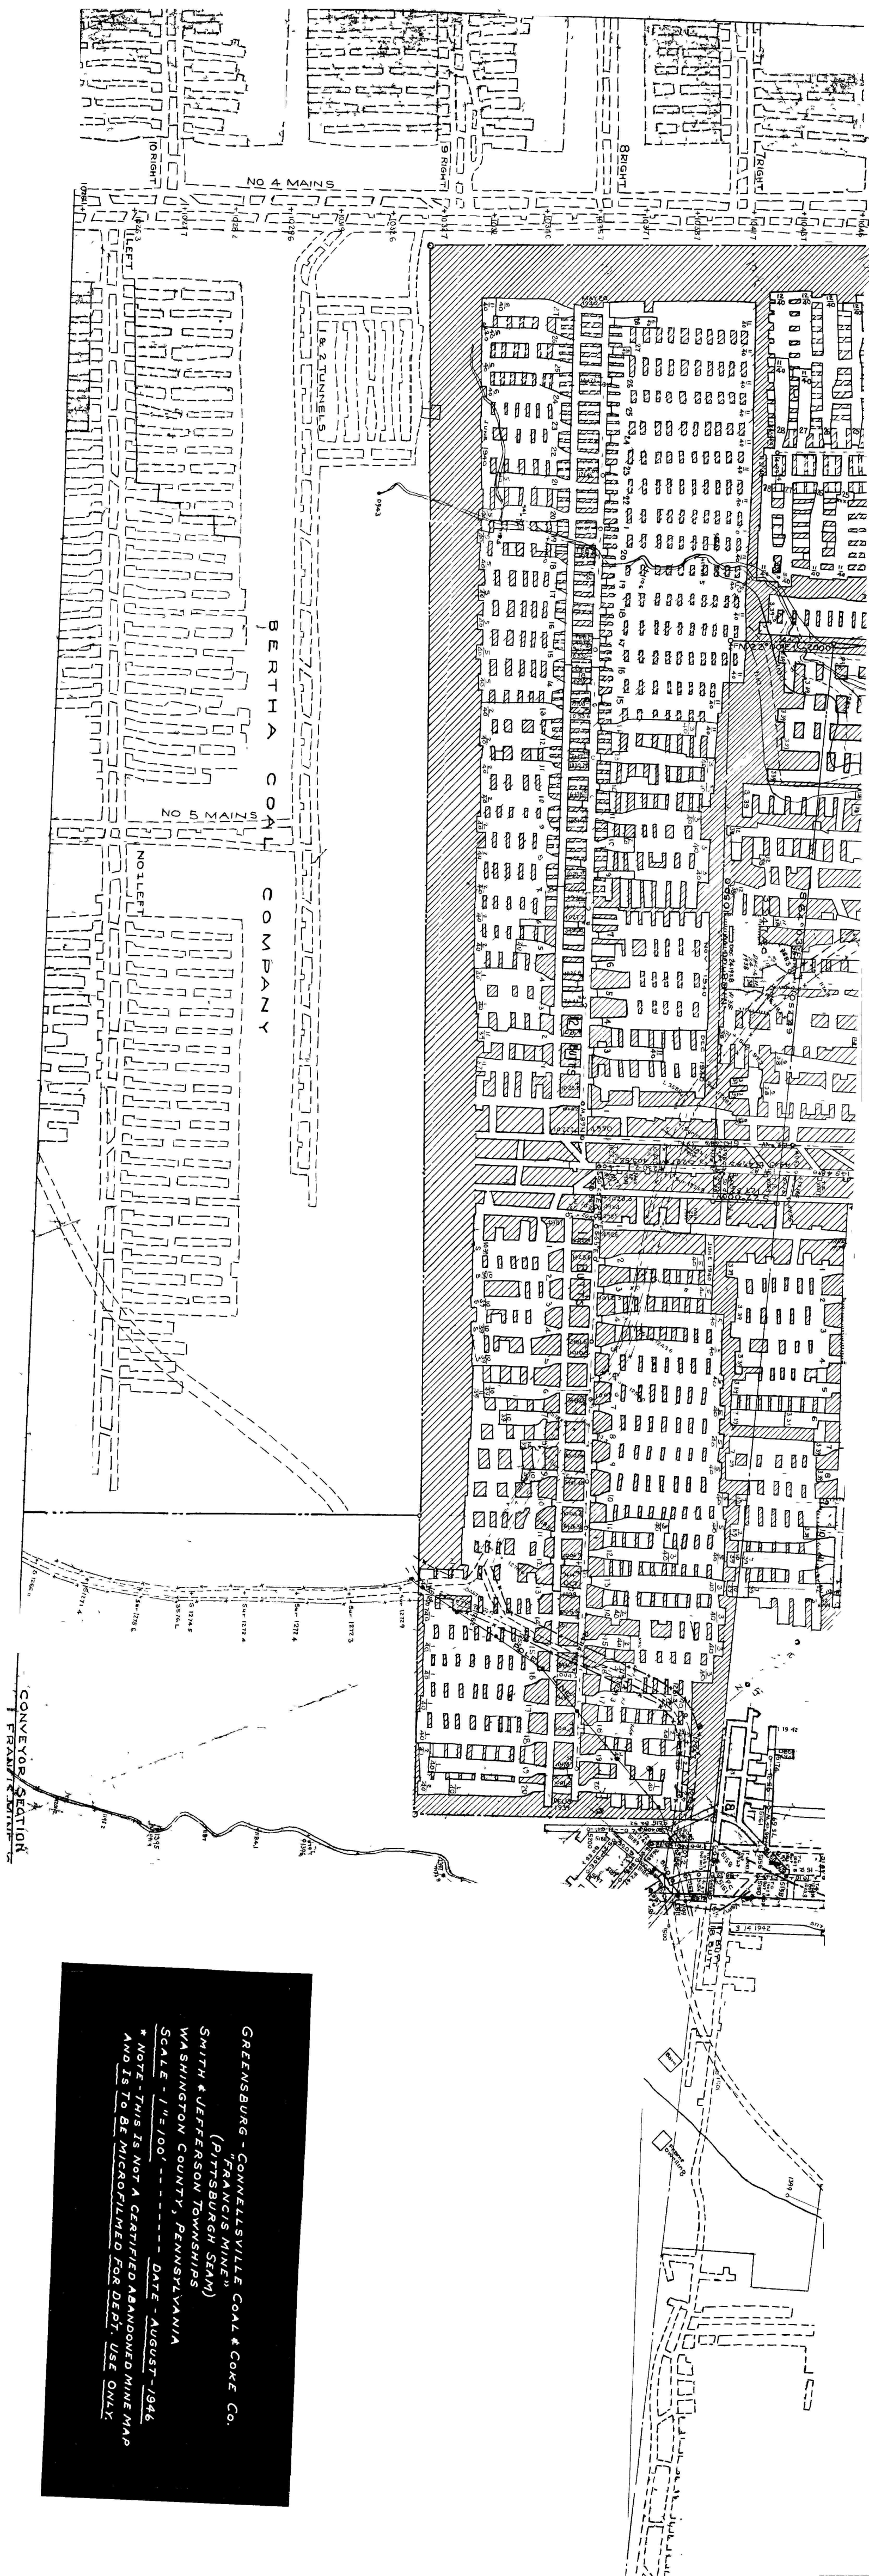

GREENSBURG - CONNELLSVILLE COAL & COKE CO.
 "FRANCIS MINE"
 (PITTSBURGH SEAM)
 SMITH & JEFFERSON TOWNSHIPS
 WASHINGTON COUNTY, PENNSYLVANIA
 SCALE - 1"=100' ----- DATE - AUGUST-1946
 * NOTE - THIS IS NOT A CERTIFIED ABANDONED MINE MAP
 AND IS TO BE MICROFILMED FOR DEPT. USE ONLY.