


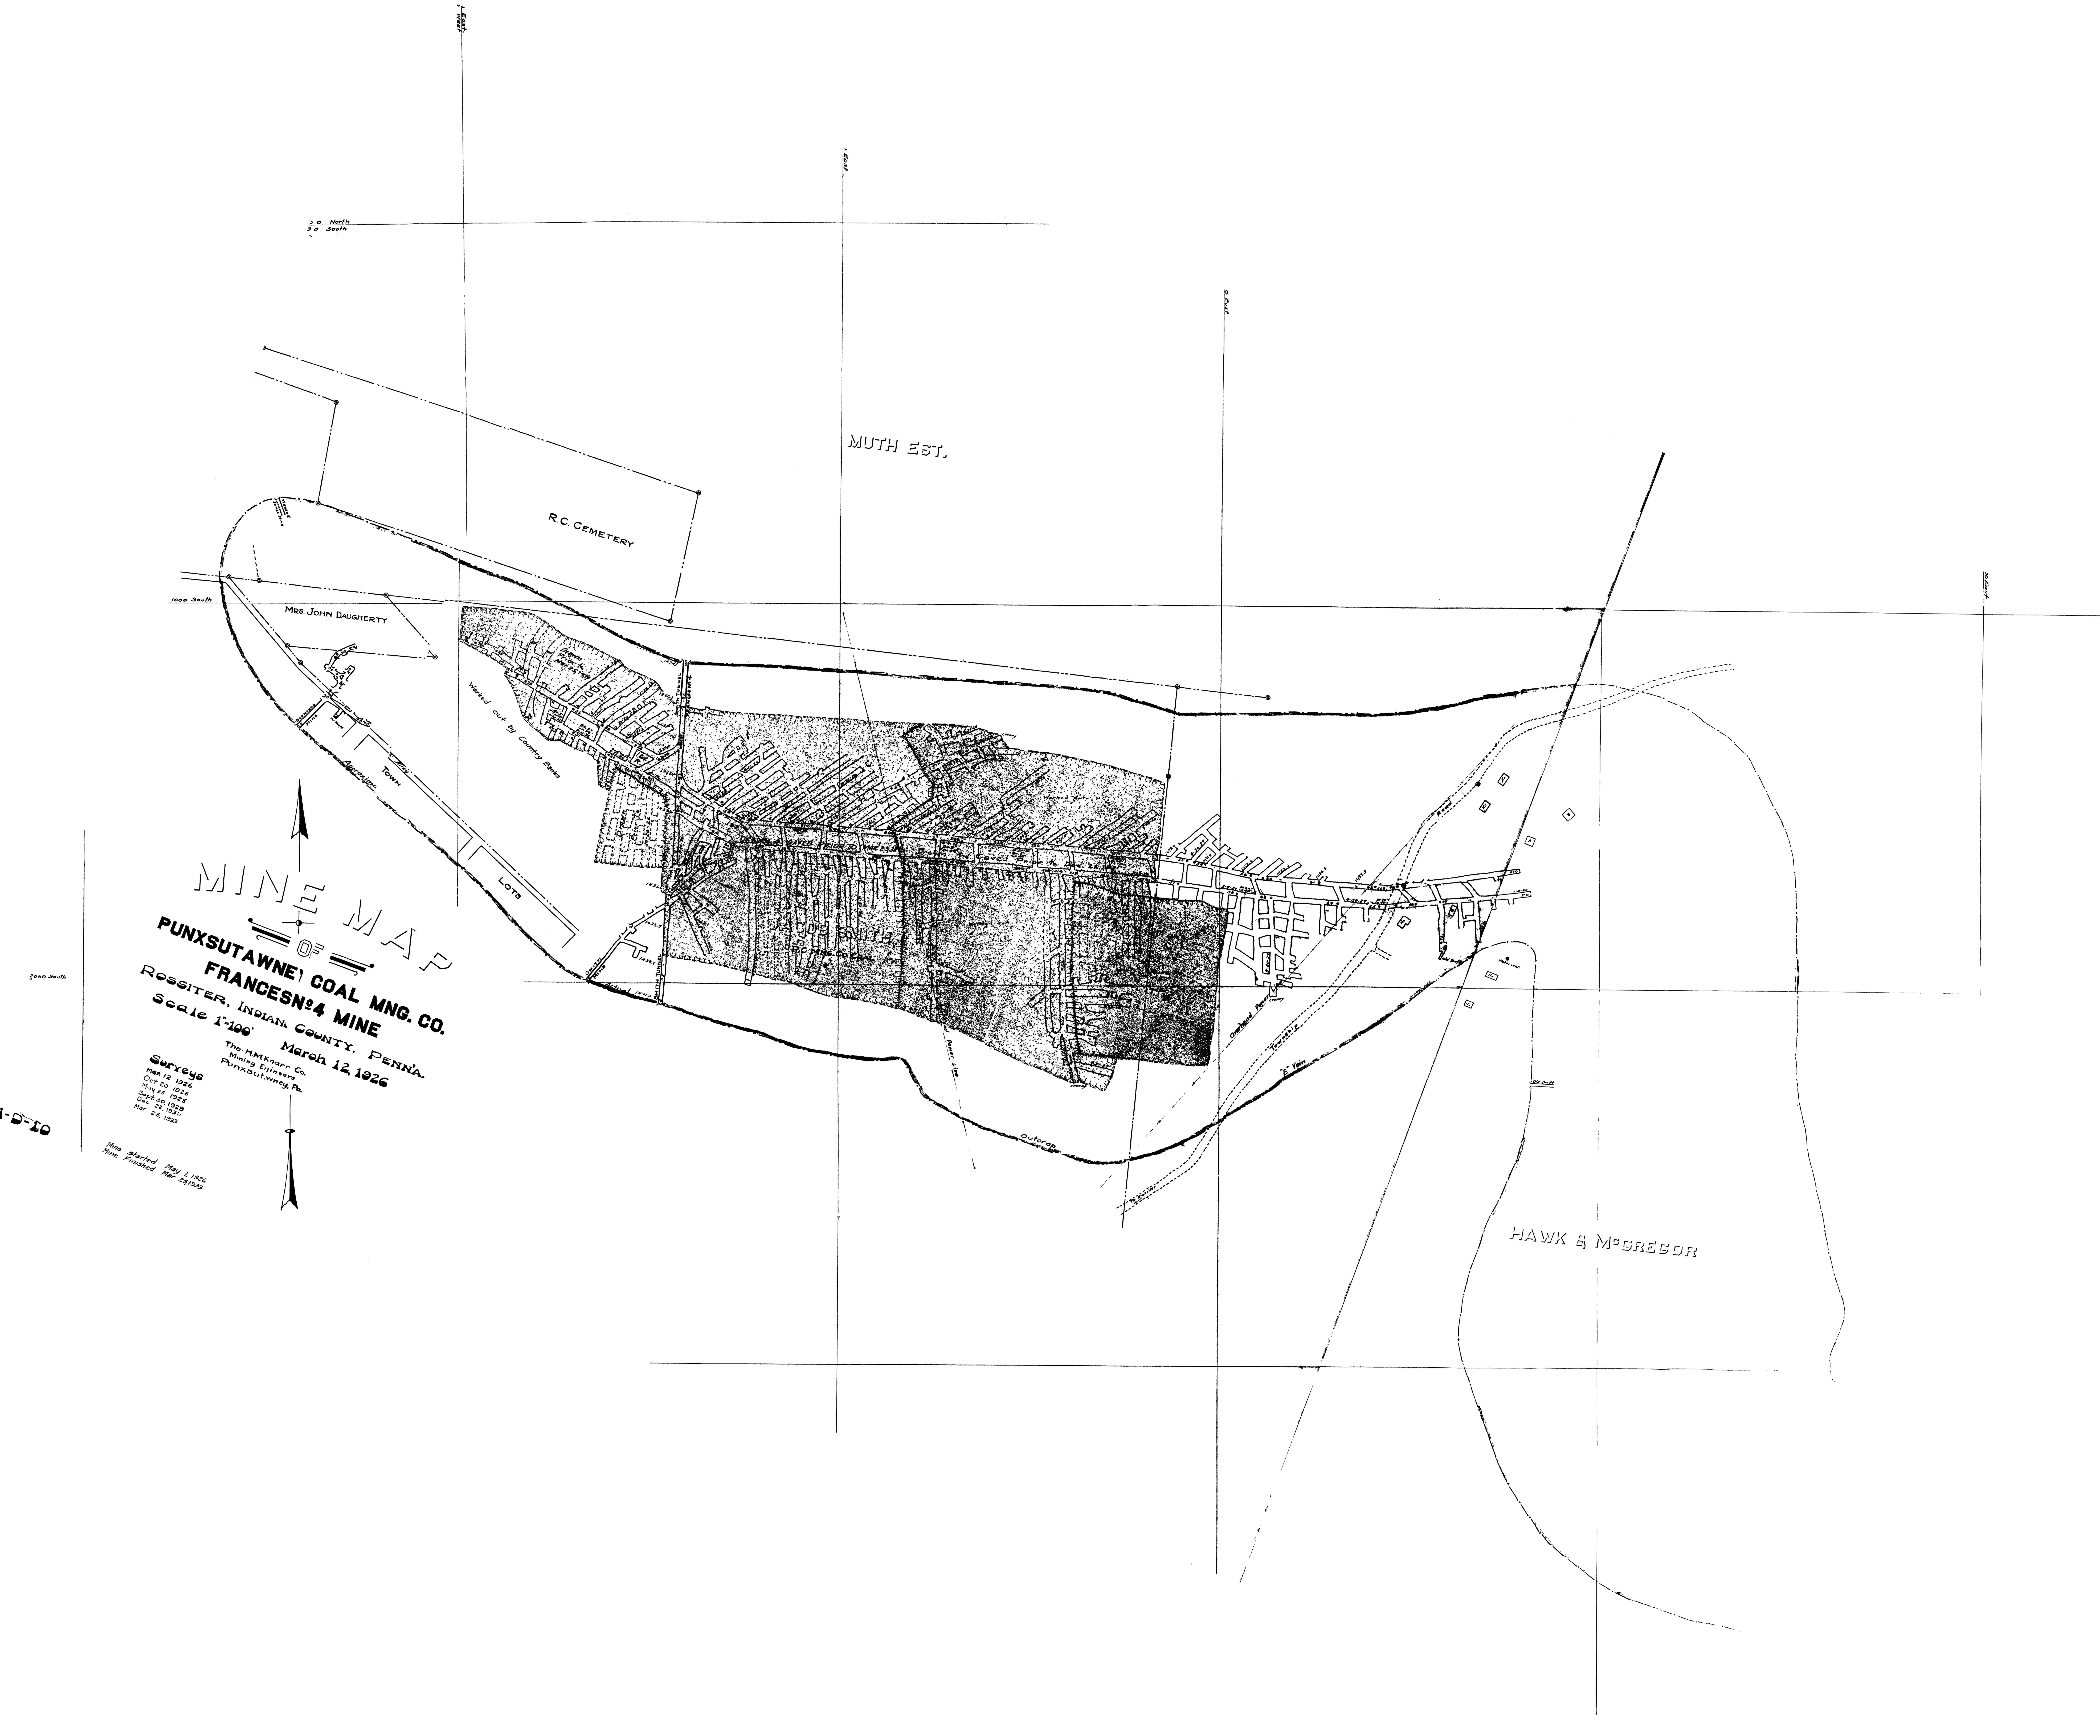

1000 North
2000 South

MUTH EST.

R.C. CEMETERY

MRS. JOHN DAUGHERTY

Walled out by County Route

TOWN

LOTS

MINE MAP

PUNXSUTAWNEY COAL MNG. CO.
FRANCES NO. 4 MINE
ROSSITER, INDIAN COUNTY, PENNA.
Scale 1"=100'

March 12, 1926

Surveys
Mar 12 1926
Oct 20 1926
May 25 1928
Sept 30 1928
Dec 22 1931
Mar 26 1933

The H.M. Knapp Co.
Mining Engineers
Punxsutawney, Pa.

1-D-10

Work started May 1, 1926
Work finished Mar 23, 1933

HAWK & MCGREGOR