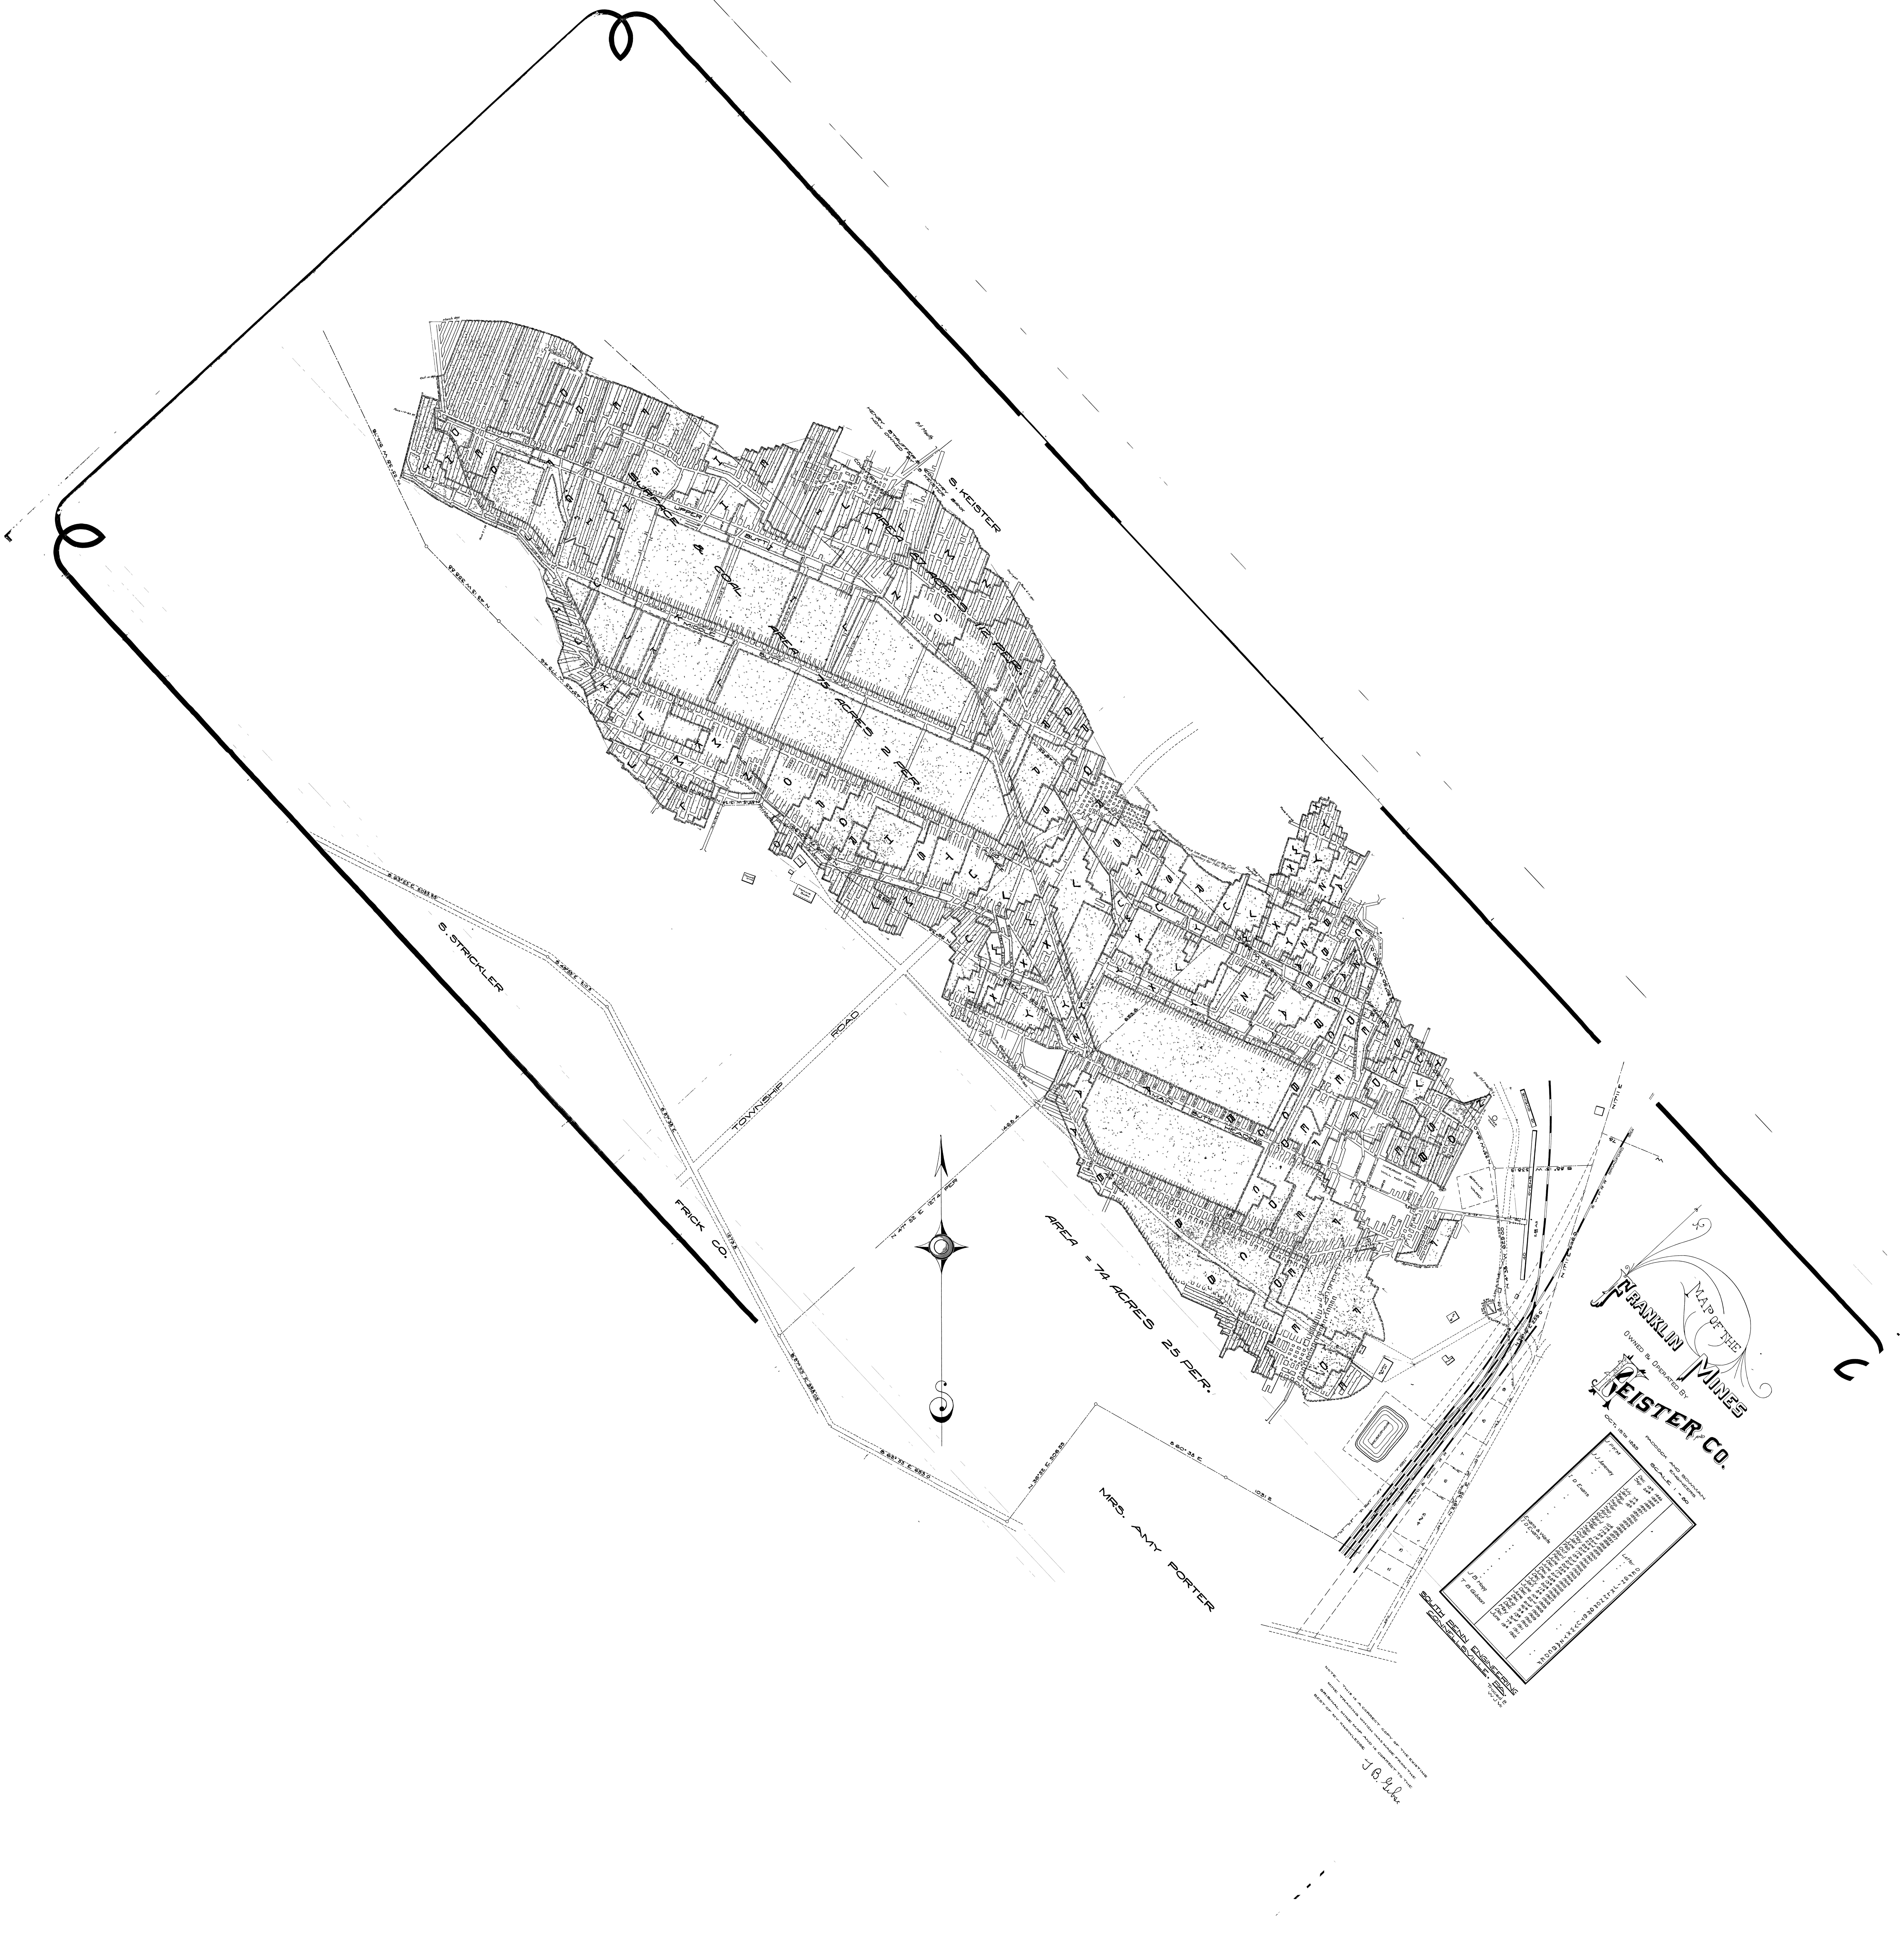
S. KEISTER
HENRY STAUFFER'S COUNTRY BANK NOW OWNED BY S. KEISTER
Pit Mouth
AREA 87 ACRES 12 PER.
SURFACE & COAL AREA 75 ACRES 2 PER.
UPPER BUTT
MIDDLE BUTT
FRAME BARN
FRAME DWG
SHED
S. STRICKLER
FRICK CO.
TOWNSHIP ROAD
AREA = 74 ACRES 25 PER.
MRS. AMY PORTER
RESERVOIR
OVENS
BALTO & OHIO R R
S W P R R BROADFORD BRA
N 17° 11' E 4460
S 88° 15' W
N 29° 35' E
J P K M
J J Janeway
I D Evans
Evans & Waite
I D Evans
J B Hogg
T B Gibson
Dec 13th 1886
Sep 24th 1887
July 7th 1888
Jan 12th 1889
Sep 18th 1890
Mar 1891
Sep 1891
Mar 1892
Sep 1892
April 1893
Oct 1894
April 10th 1896
Oct 17th 1896
Sep 17th 1897
Mar 5th 1897
Sep 1st 1898
Mar 23rd 1898
Oct 23rd 1899
May 29th 1899
Jan 21st 1900
June 21st 1900
Feb 17th 1901
Oct 15th 1901
April 21st 1902
Nov 21st 1902
June 20th 1903
Dec 25th 1903
June 17th 1904
Dec 21st 1904
June 28th 1905
Dec 13th 1905
July 20th 1906
Jan 11th 1906
June 8th 1907
Dec 10th 1908
June 22nd 1908
Dec 21st 1909
Aug 16th 1909
Dec 9th 1910
May 13th 1910
Dec 31st 1911
June 19th 1912
Letter D
E
F
G
H
I
J
K
L
M
N
O
P
Q
R
S
T
U
V
W
X
Y
Z
A
B
C
D
E
F

MAP OF THE

FRANKLIN MINES

OWNED & OPERATED BY

KEISTER AND CO.

OCT. 15TH 1885

PADDOCK AND BOWMAN
ENGINEERS

SCALE 1 = 80

SOUTH PENN ENGINEERING
CONNELLSVILLE, PA.

Traced by
W J V

NOTE — THIS IS A CORRECT COPY OF THE EXISTING MINE TRACING WHICH WAS MADE FROM THE ORIGINAL MINE MAP AND IS CORRECT TO THE BEST OF MY KNOWLEDGE

J. B. Gibson