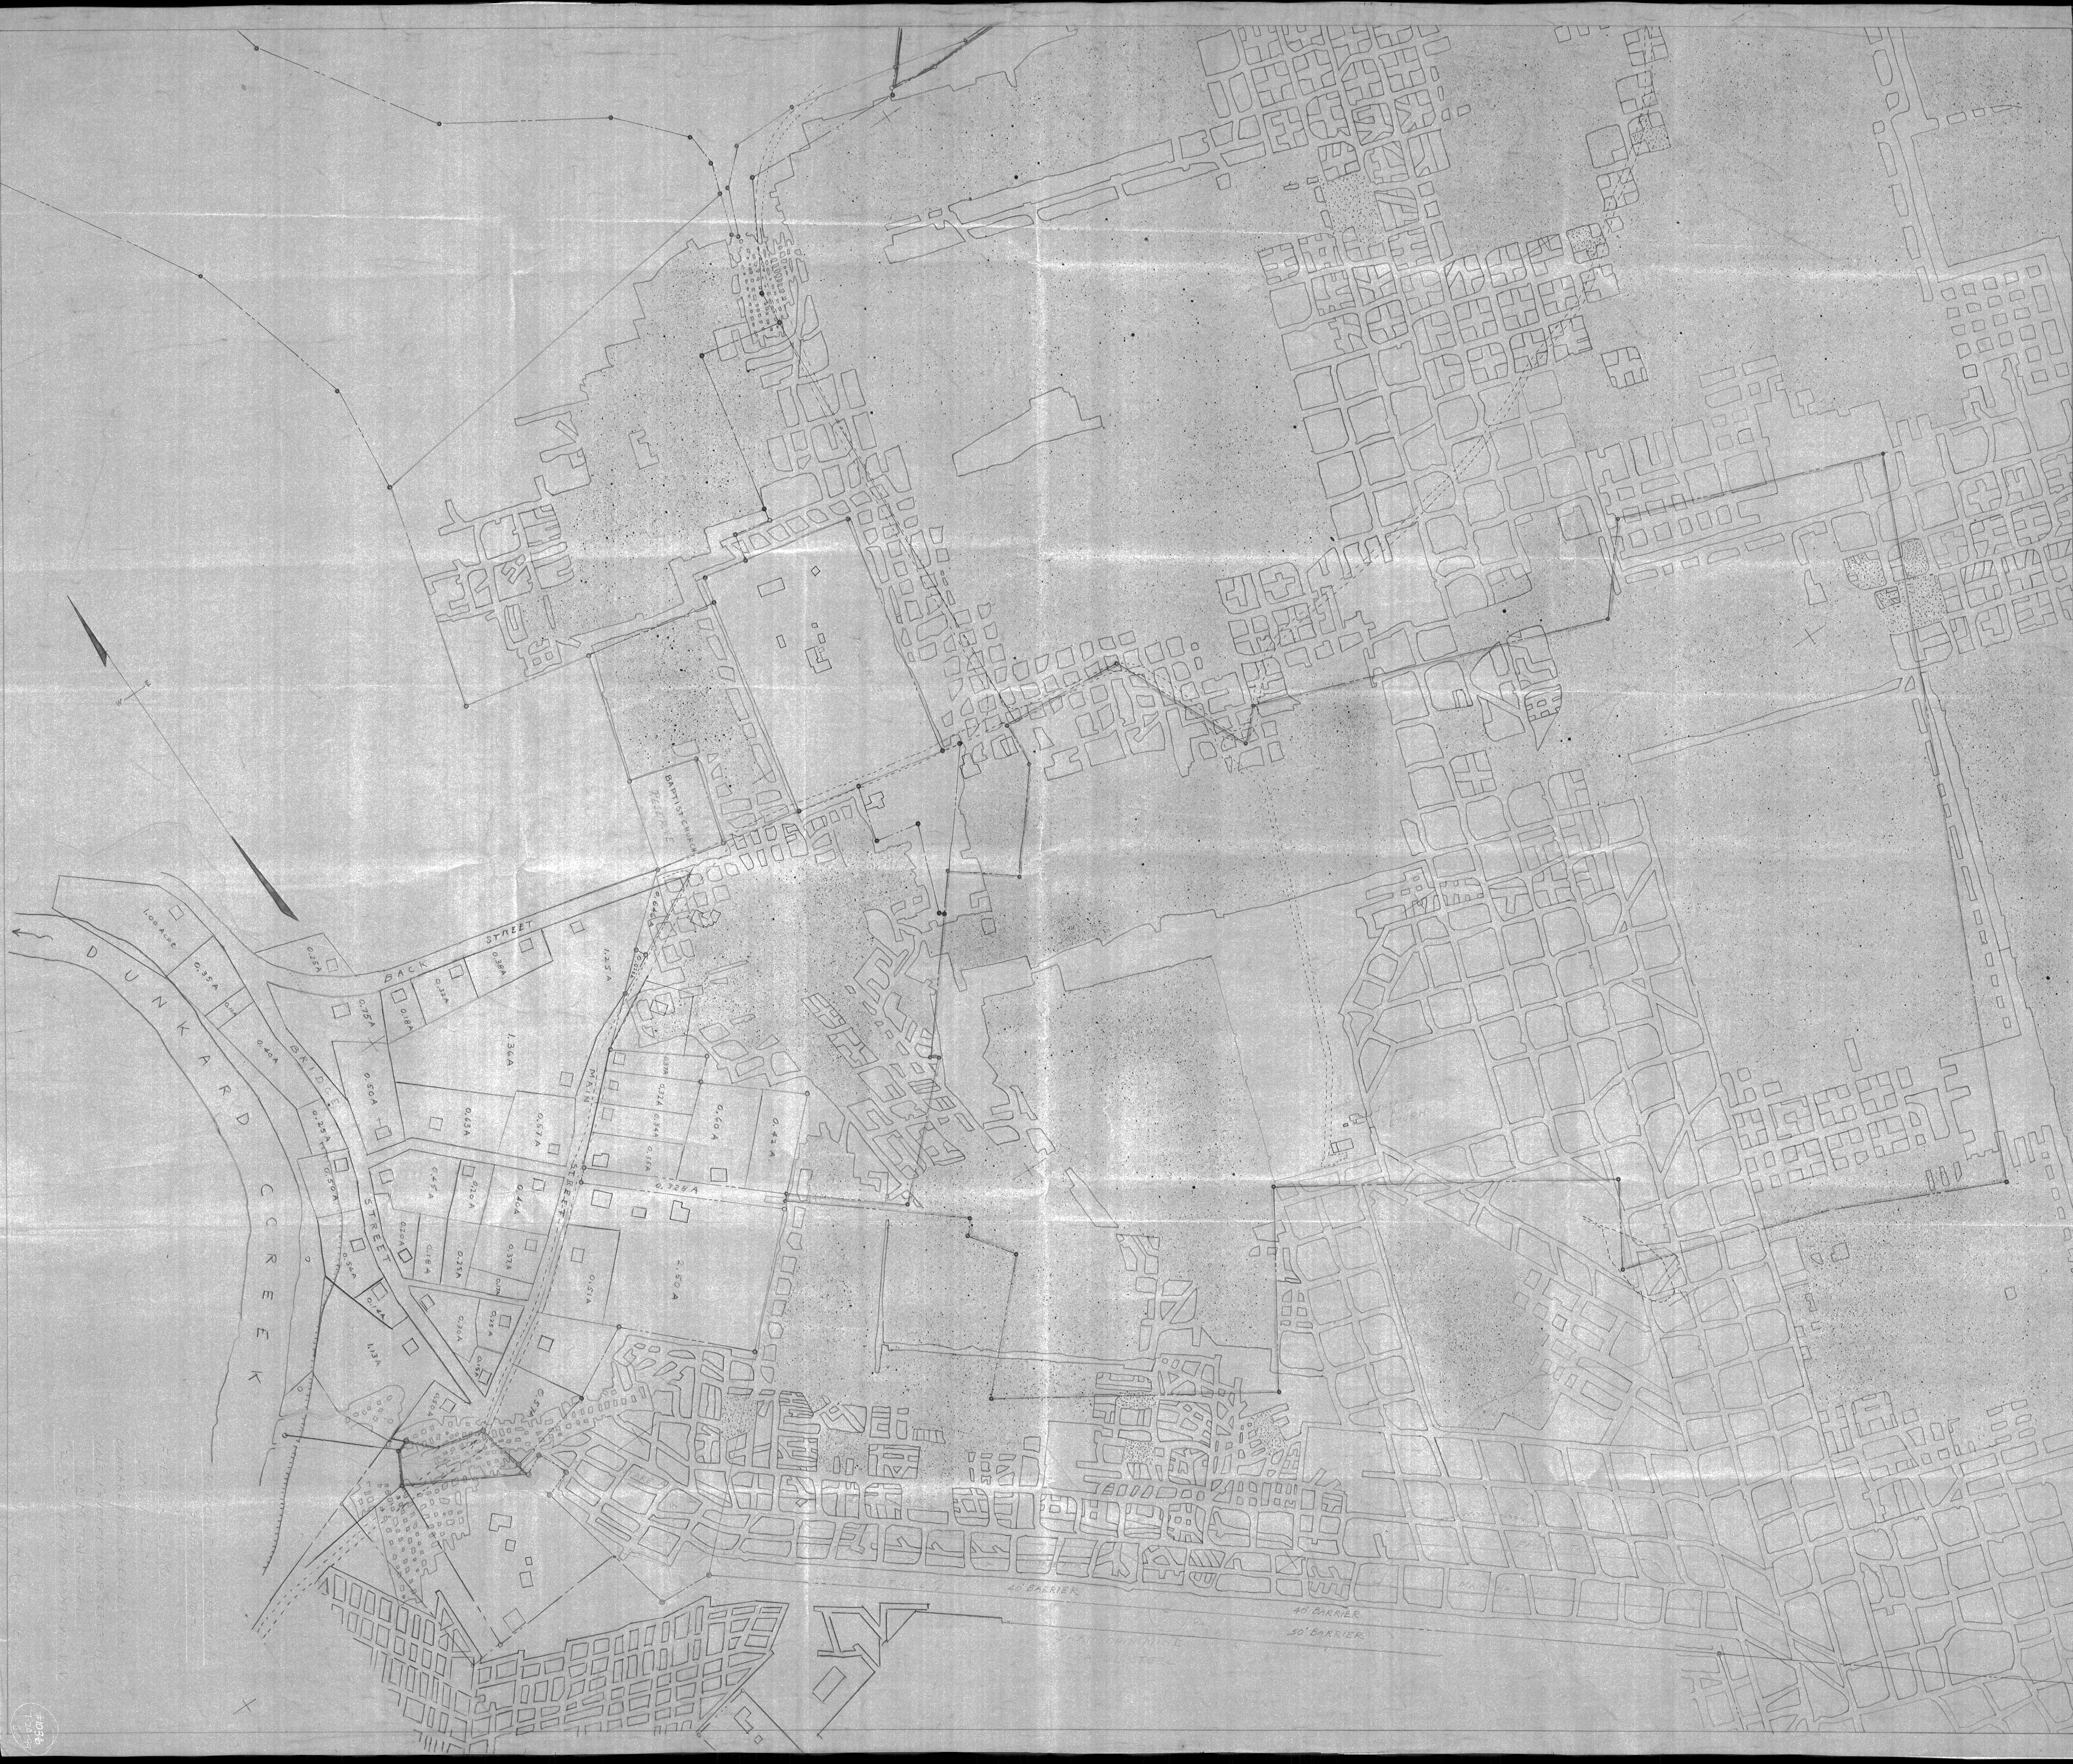
DUNKARD CREEK
BACK STREET
BRIDGE STREET
MAIN STREET
BAPTIST CHURCH
RESERVE
W
E
1.00 ACRE
0.35A
0.10A
0.40A
0.25A
0.75A
0.18A
0.32A
0.38A
1.25A
0.025A
1.36A
0.50A
0.25A
0.50A
0.63A
0.57A
0.37A
0.32A
0.34A
0.35A
0.60A
0.42A
0.328A
0.45A
0.20A
0.40A
0.20A
0.18A
0.25A
0.37A
0.17A
0.51A
2.50A
0.56A
0.14A
1.13A
0.30A
0.25A
0.15A
0.50A
40' BARRIER
40' BARRIER
50' BARRIER

#1036
7-28-99
C.C.