


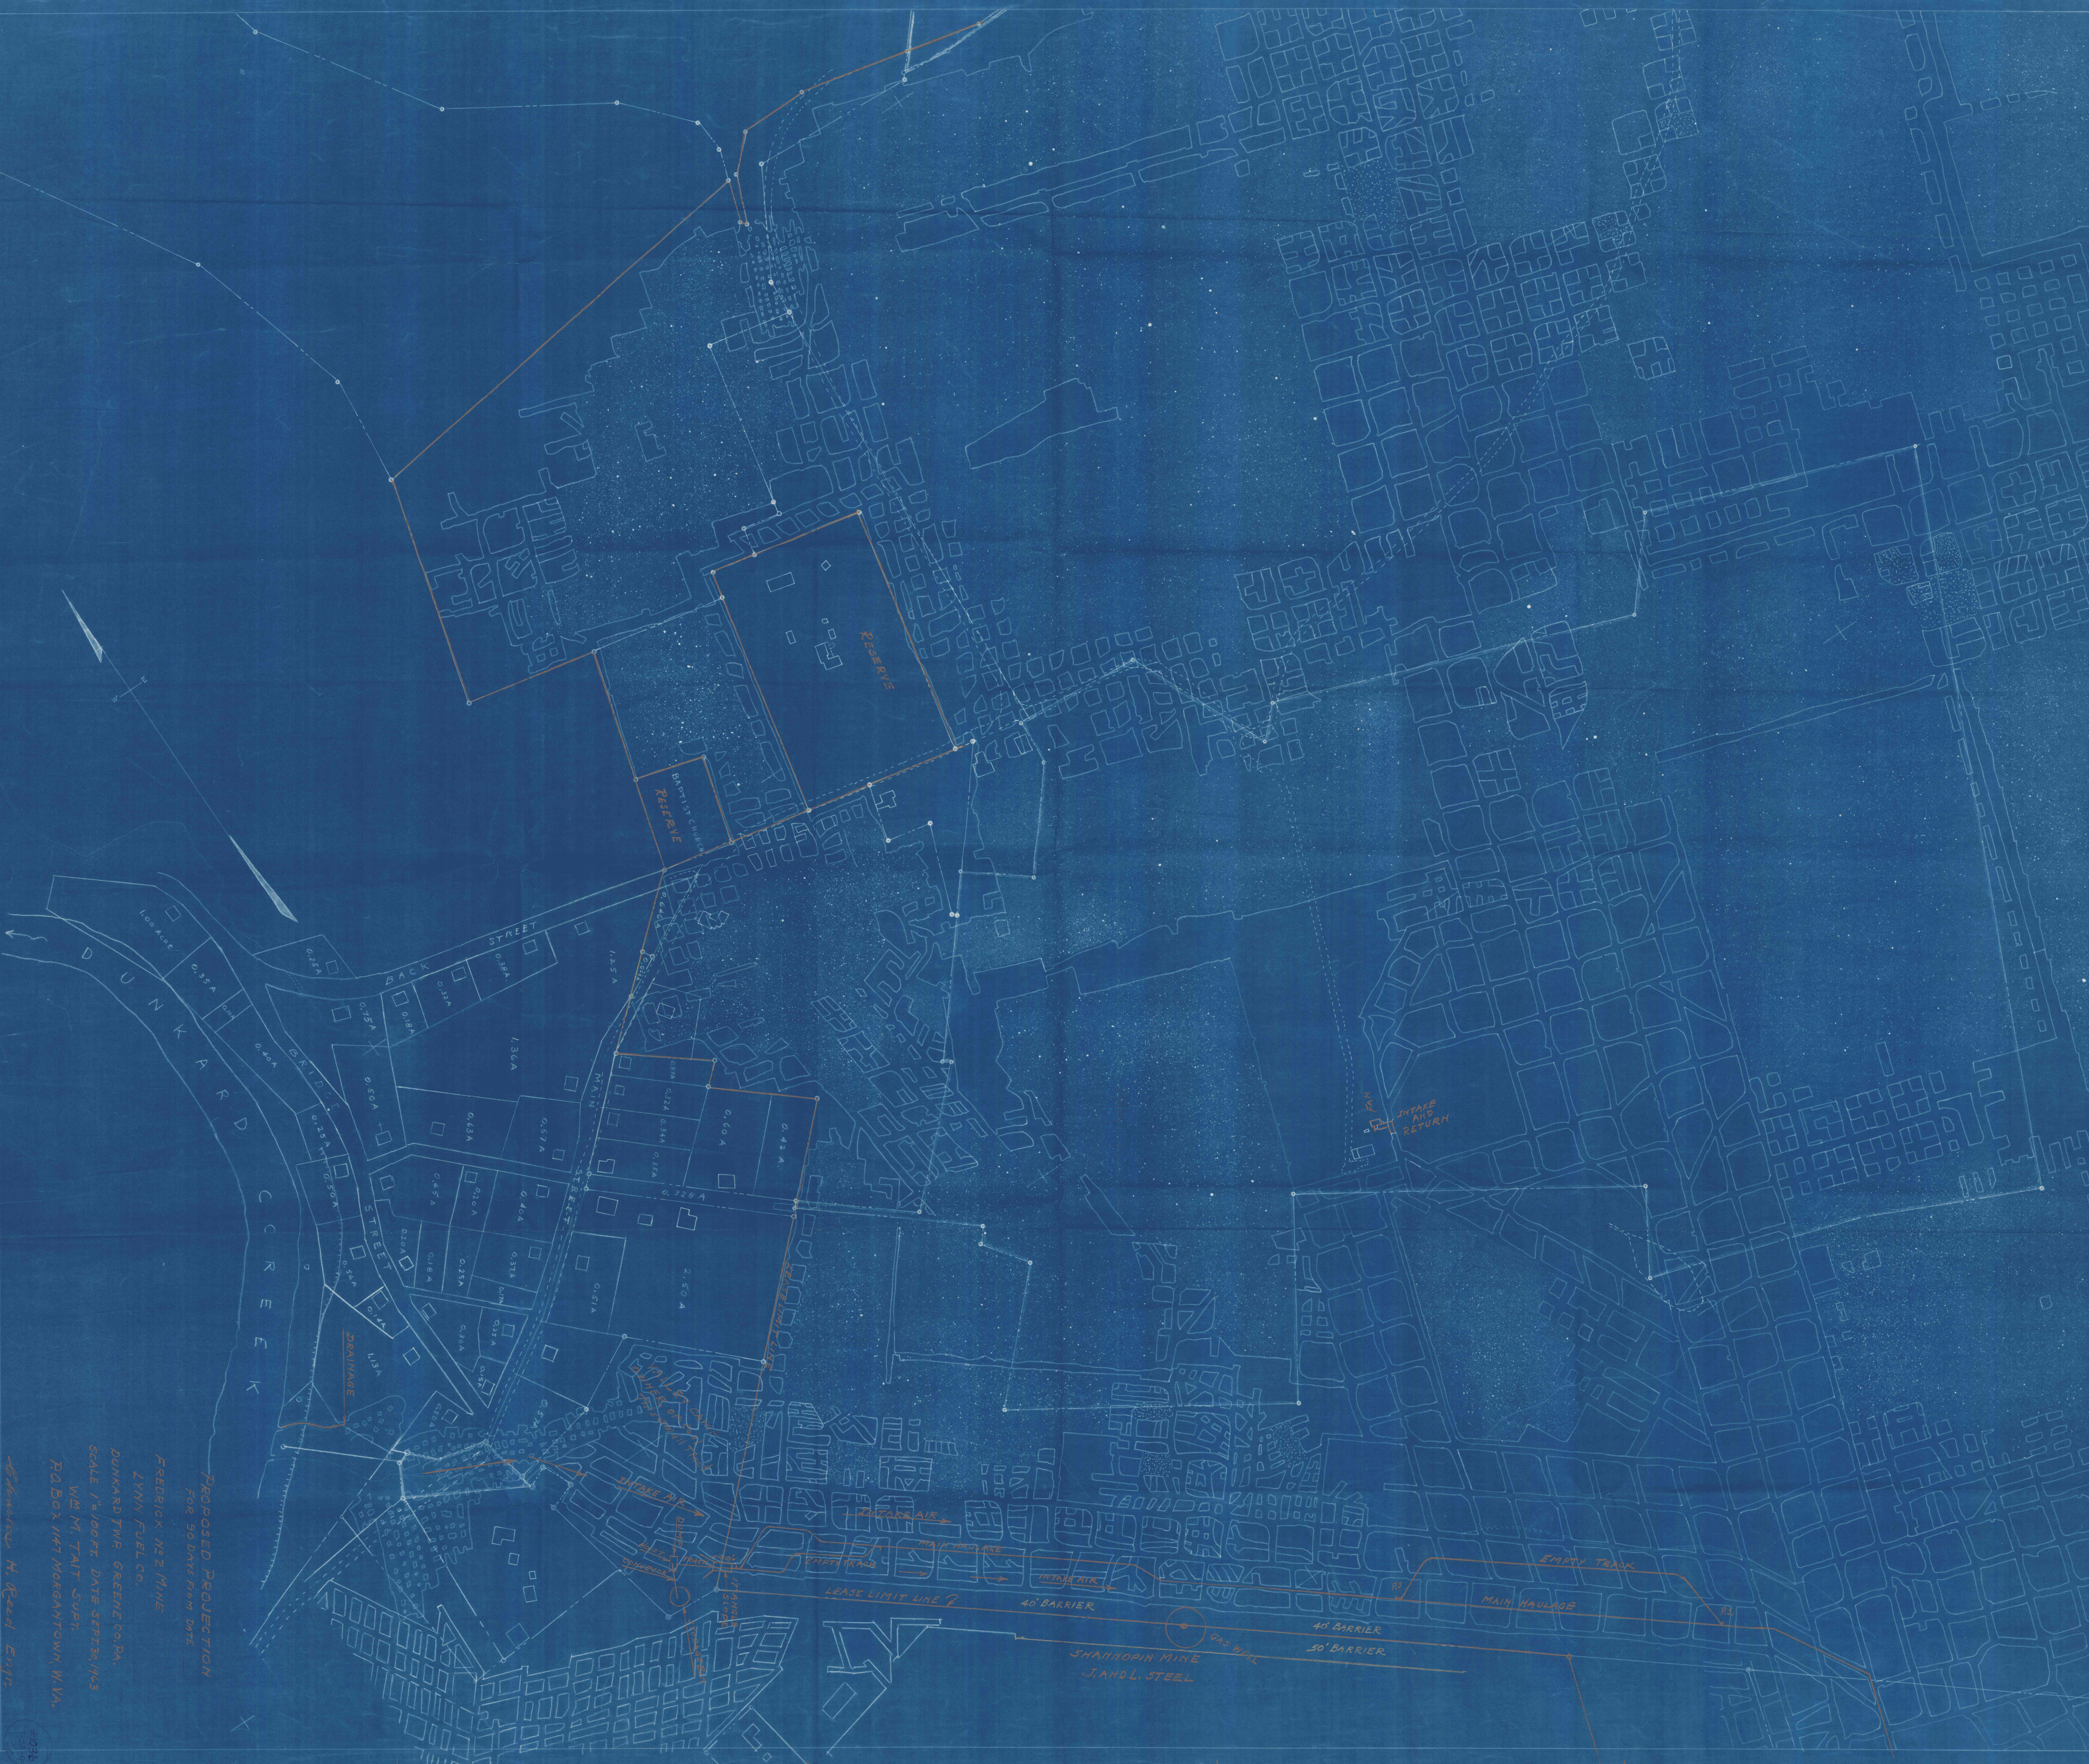

PROPOSED PROJECTION
FOR 30 DAYS FROM DATE
FREDRICK HAZZ MINE
LYNN FUEL CO.
DUNKARD TWP. GREENE CO. PA.
SCALE 1"=400 FT. DATE SEPTEMBER 1943
W. M. TAIT SURV.
P.O. BOX 147 MCGRAW TOWN, W.VA.
Edmund H. Reed Engr.