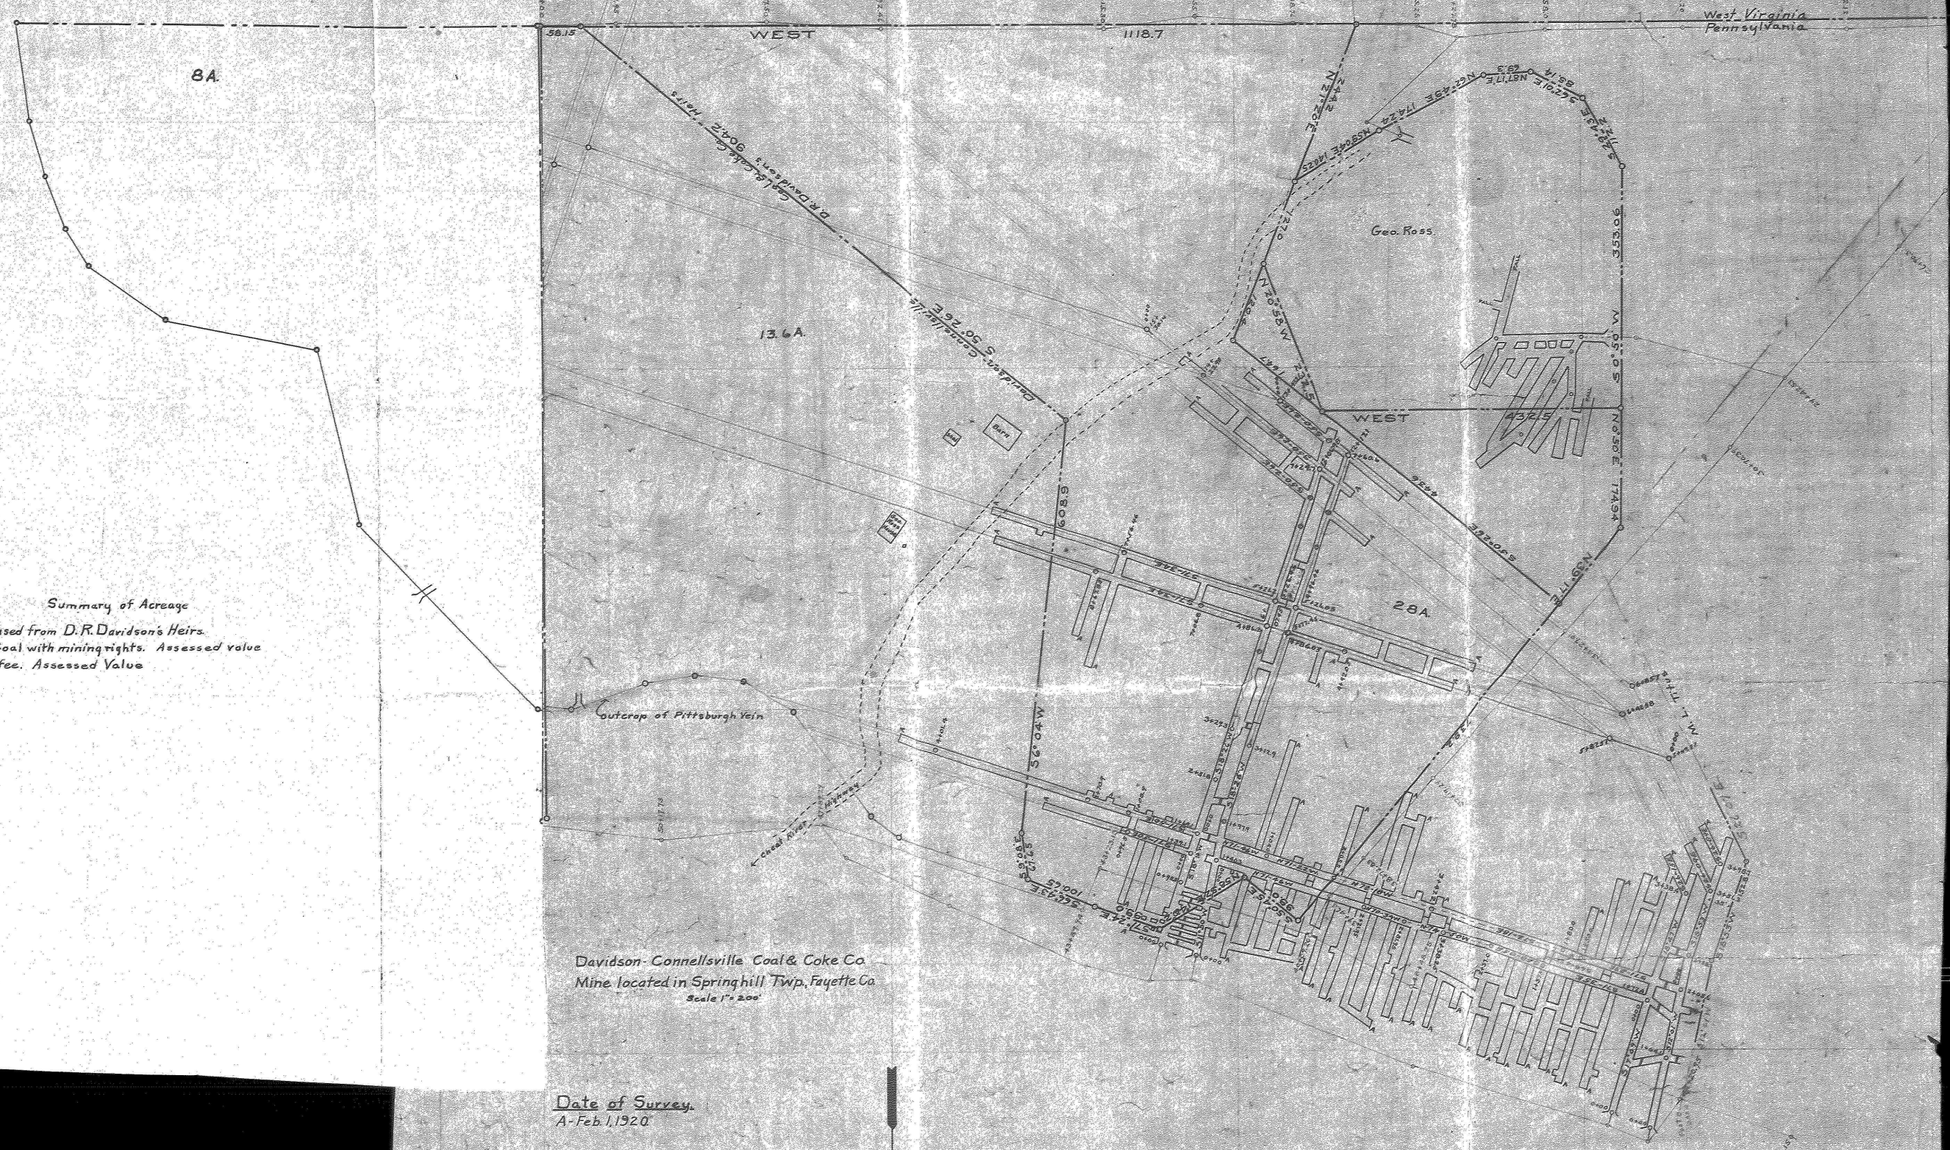

Summary of Acreage

28A. leased from D.R. Davidson's Heirs.
13.6A. - Coal with mining rights. Assessed value
8A. in fee. Assessed Value

Davidson-Connellsville Coal & Coke Co.
Mine located in Springhill Twp, Fayette Co.
Scale 1" = 200'

Date of Survey.
A-Feb. 1, 1920