


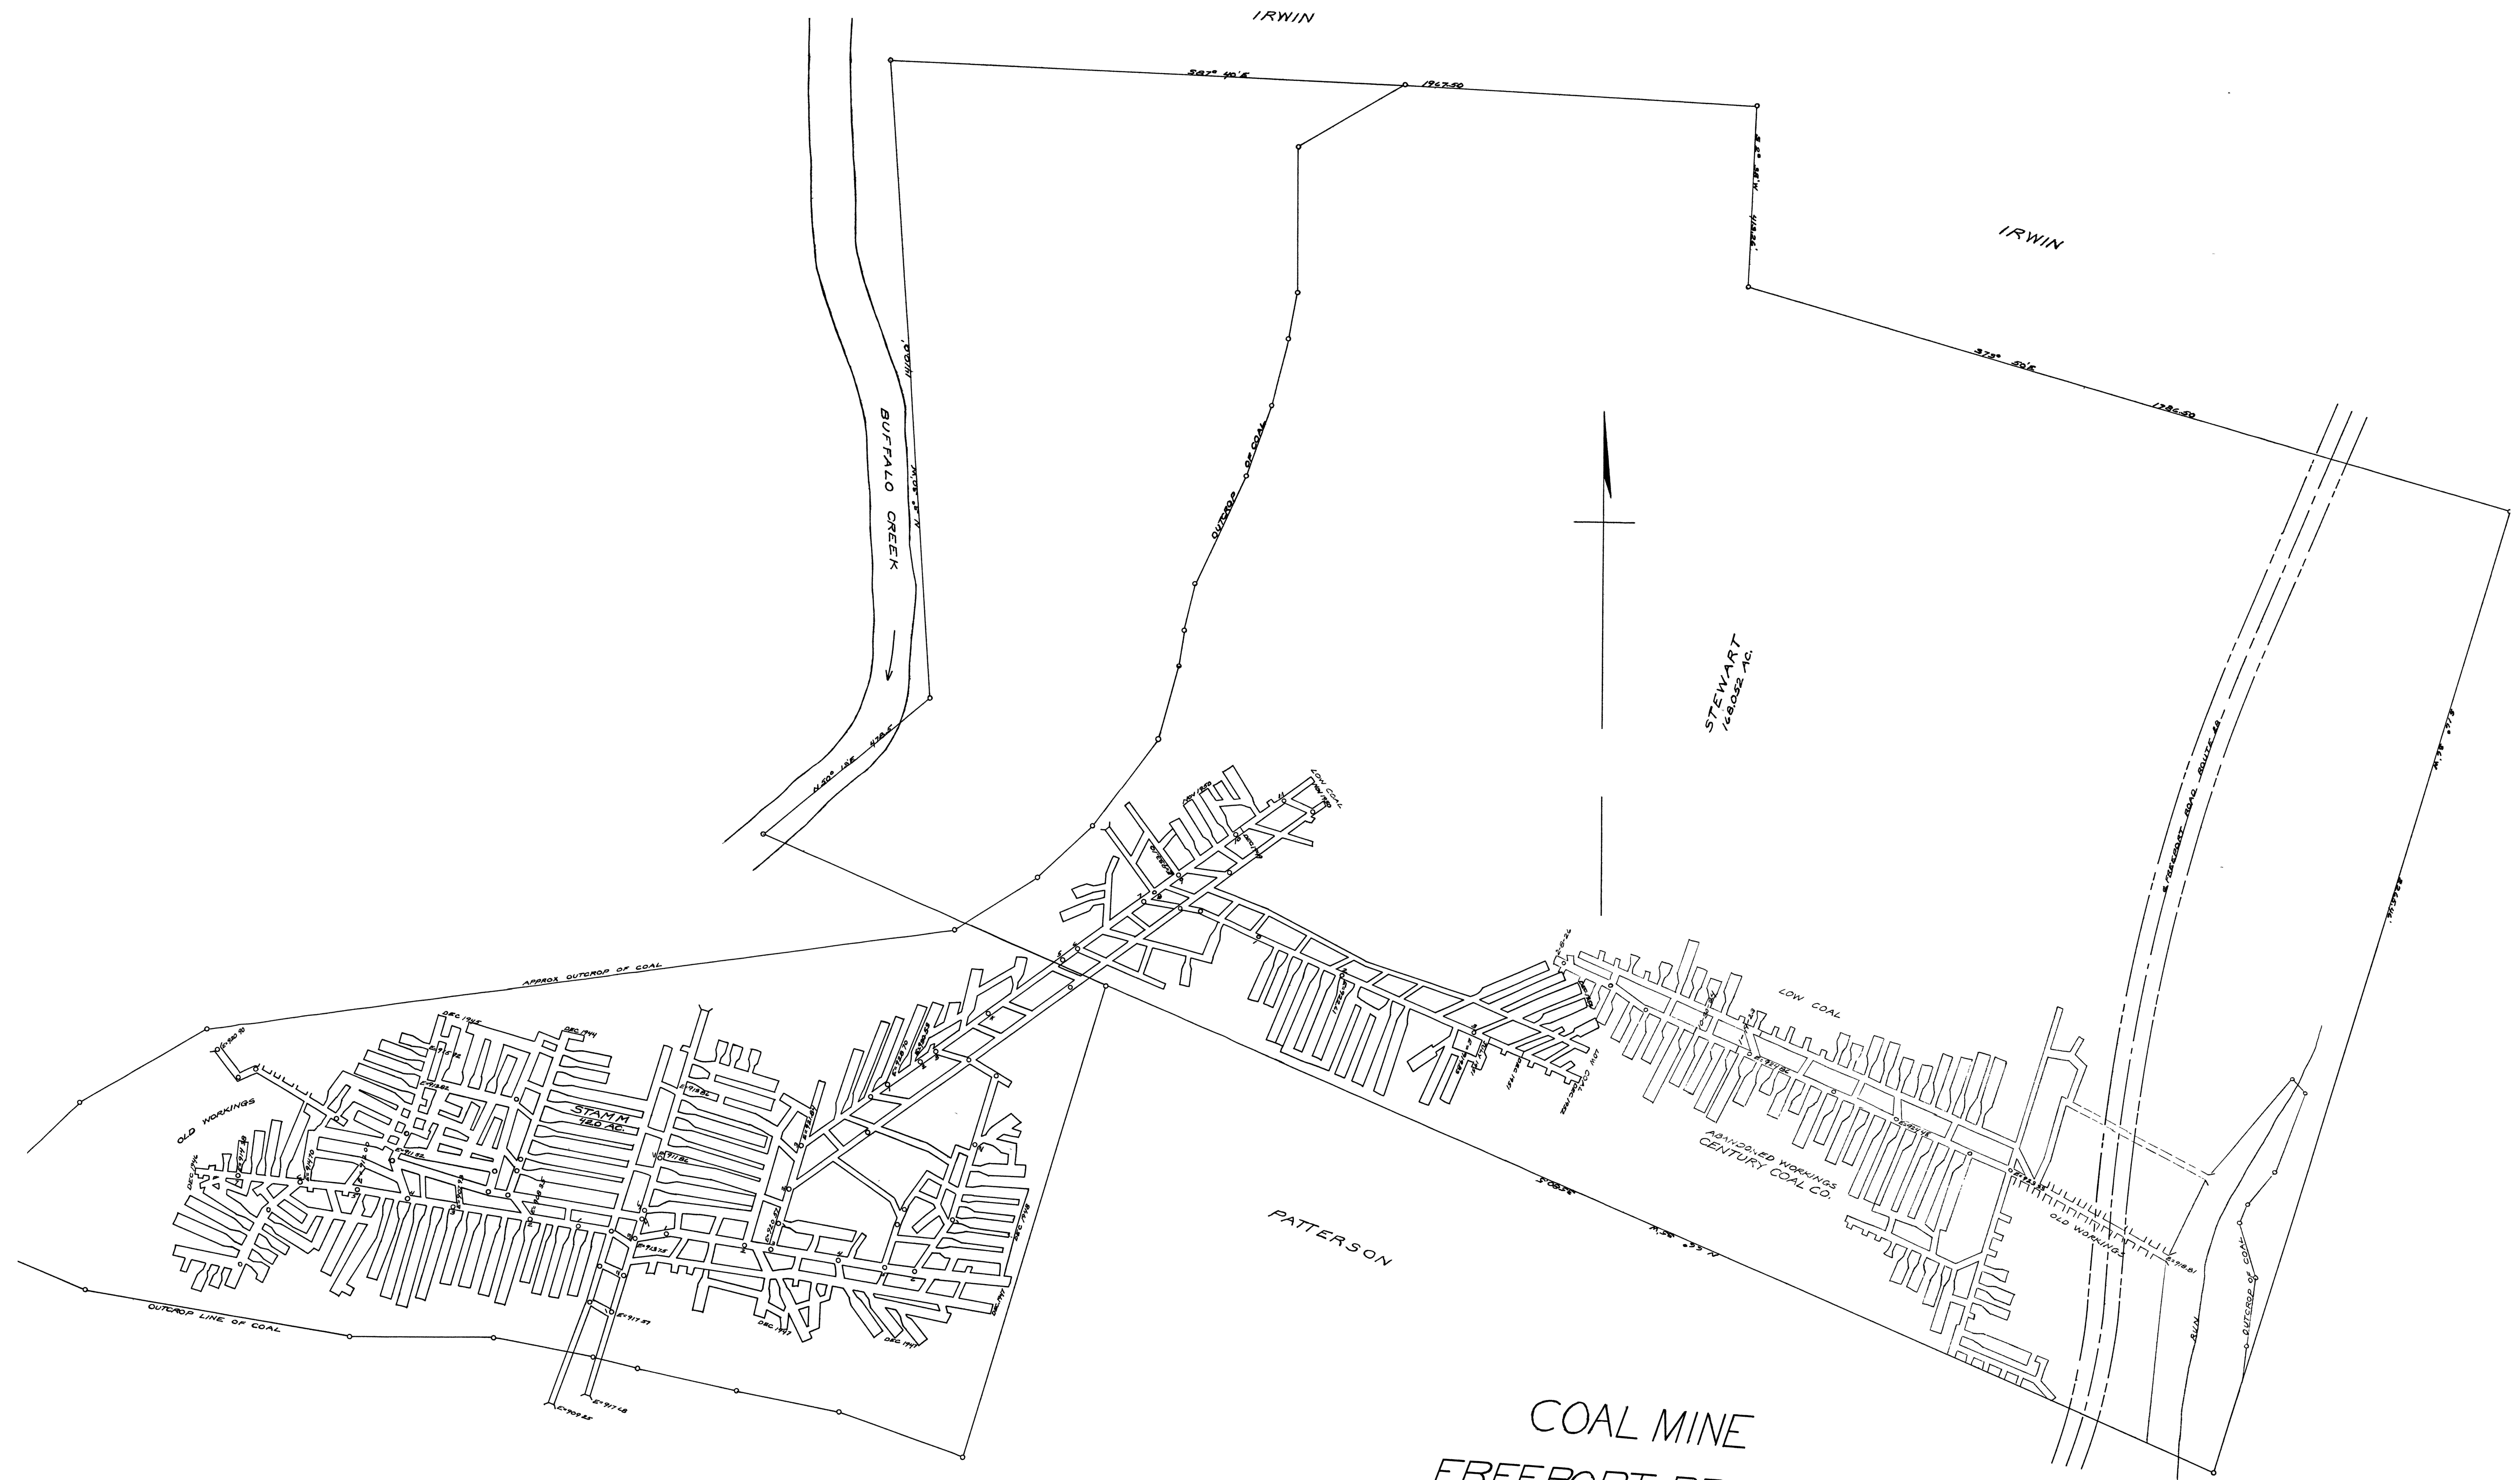

COAL MINE
FREEPORT BRICK CO.
FREEPORT PA.
SCALE 1"=100'
DECEMBER 19, 1953