





FRICANO
COAL CO.


Mine located on
Map by George Gera
Feb. 1967



Mapped, edited, and published by the Geological Survey
Control by USGS and USC&GS
Topography from aerial photographs by multiplex methods
Aerial photographs taken 1952. Field check 1954
Polyconic projection. 1927 North American datum
10,000-foot grid based on Pennsylvania coordinate system,
south zone
Contours in strip mine and mine dump areas
compiled from 1952 photography
All mining features on this map are inactive
unless otherwise indicated
1000-meter Universal Transverse Mercator grid ticks,
zone 17, shown in blue

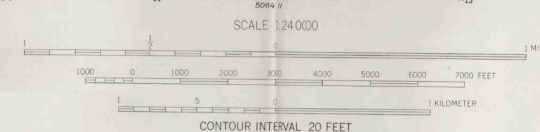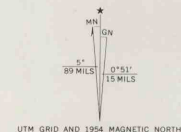

ROAD CLASSIFICATION
Heavy-duty ——— Light-duty ———
Medium-duty ——— Unimproved dirt ———
U.S. Route ——— State Route ———

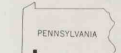

SMITHTON, PA.
NW 1/4 CONNELLSVILLE 15' QUADRANGLE
N4007.5-W7937.5/7.5

1954

AMS 5064 II NW-SERIES V831

THIS MAP COMPLIES WITH NATIONAL MAP ACCURACY STANDARDS
FOR SALE BY U.S. GEOLOGICAL SURVEY, WASHINGTON, D.C. 20242
A FOLDER DESCRIBING TOPOGRAPHIC MAPS AND SYMBOLS IS AVAILABLE ON REQUEST

**SOUTH HUNTINGDON TOWNSHIP
WESTMORELAND COUNTY
PERMIT NUMBER- 279-1
"E"-OR UPPER FREEPORT SEAM**