


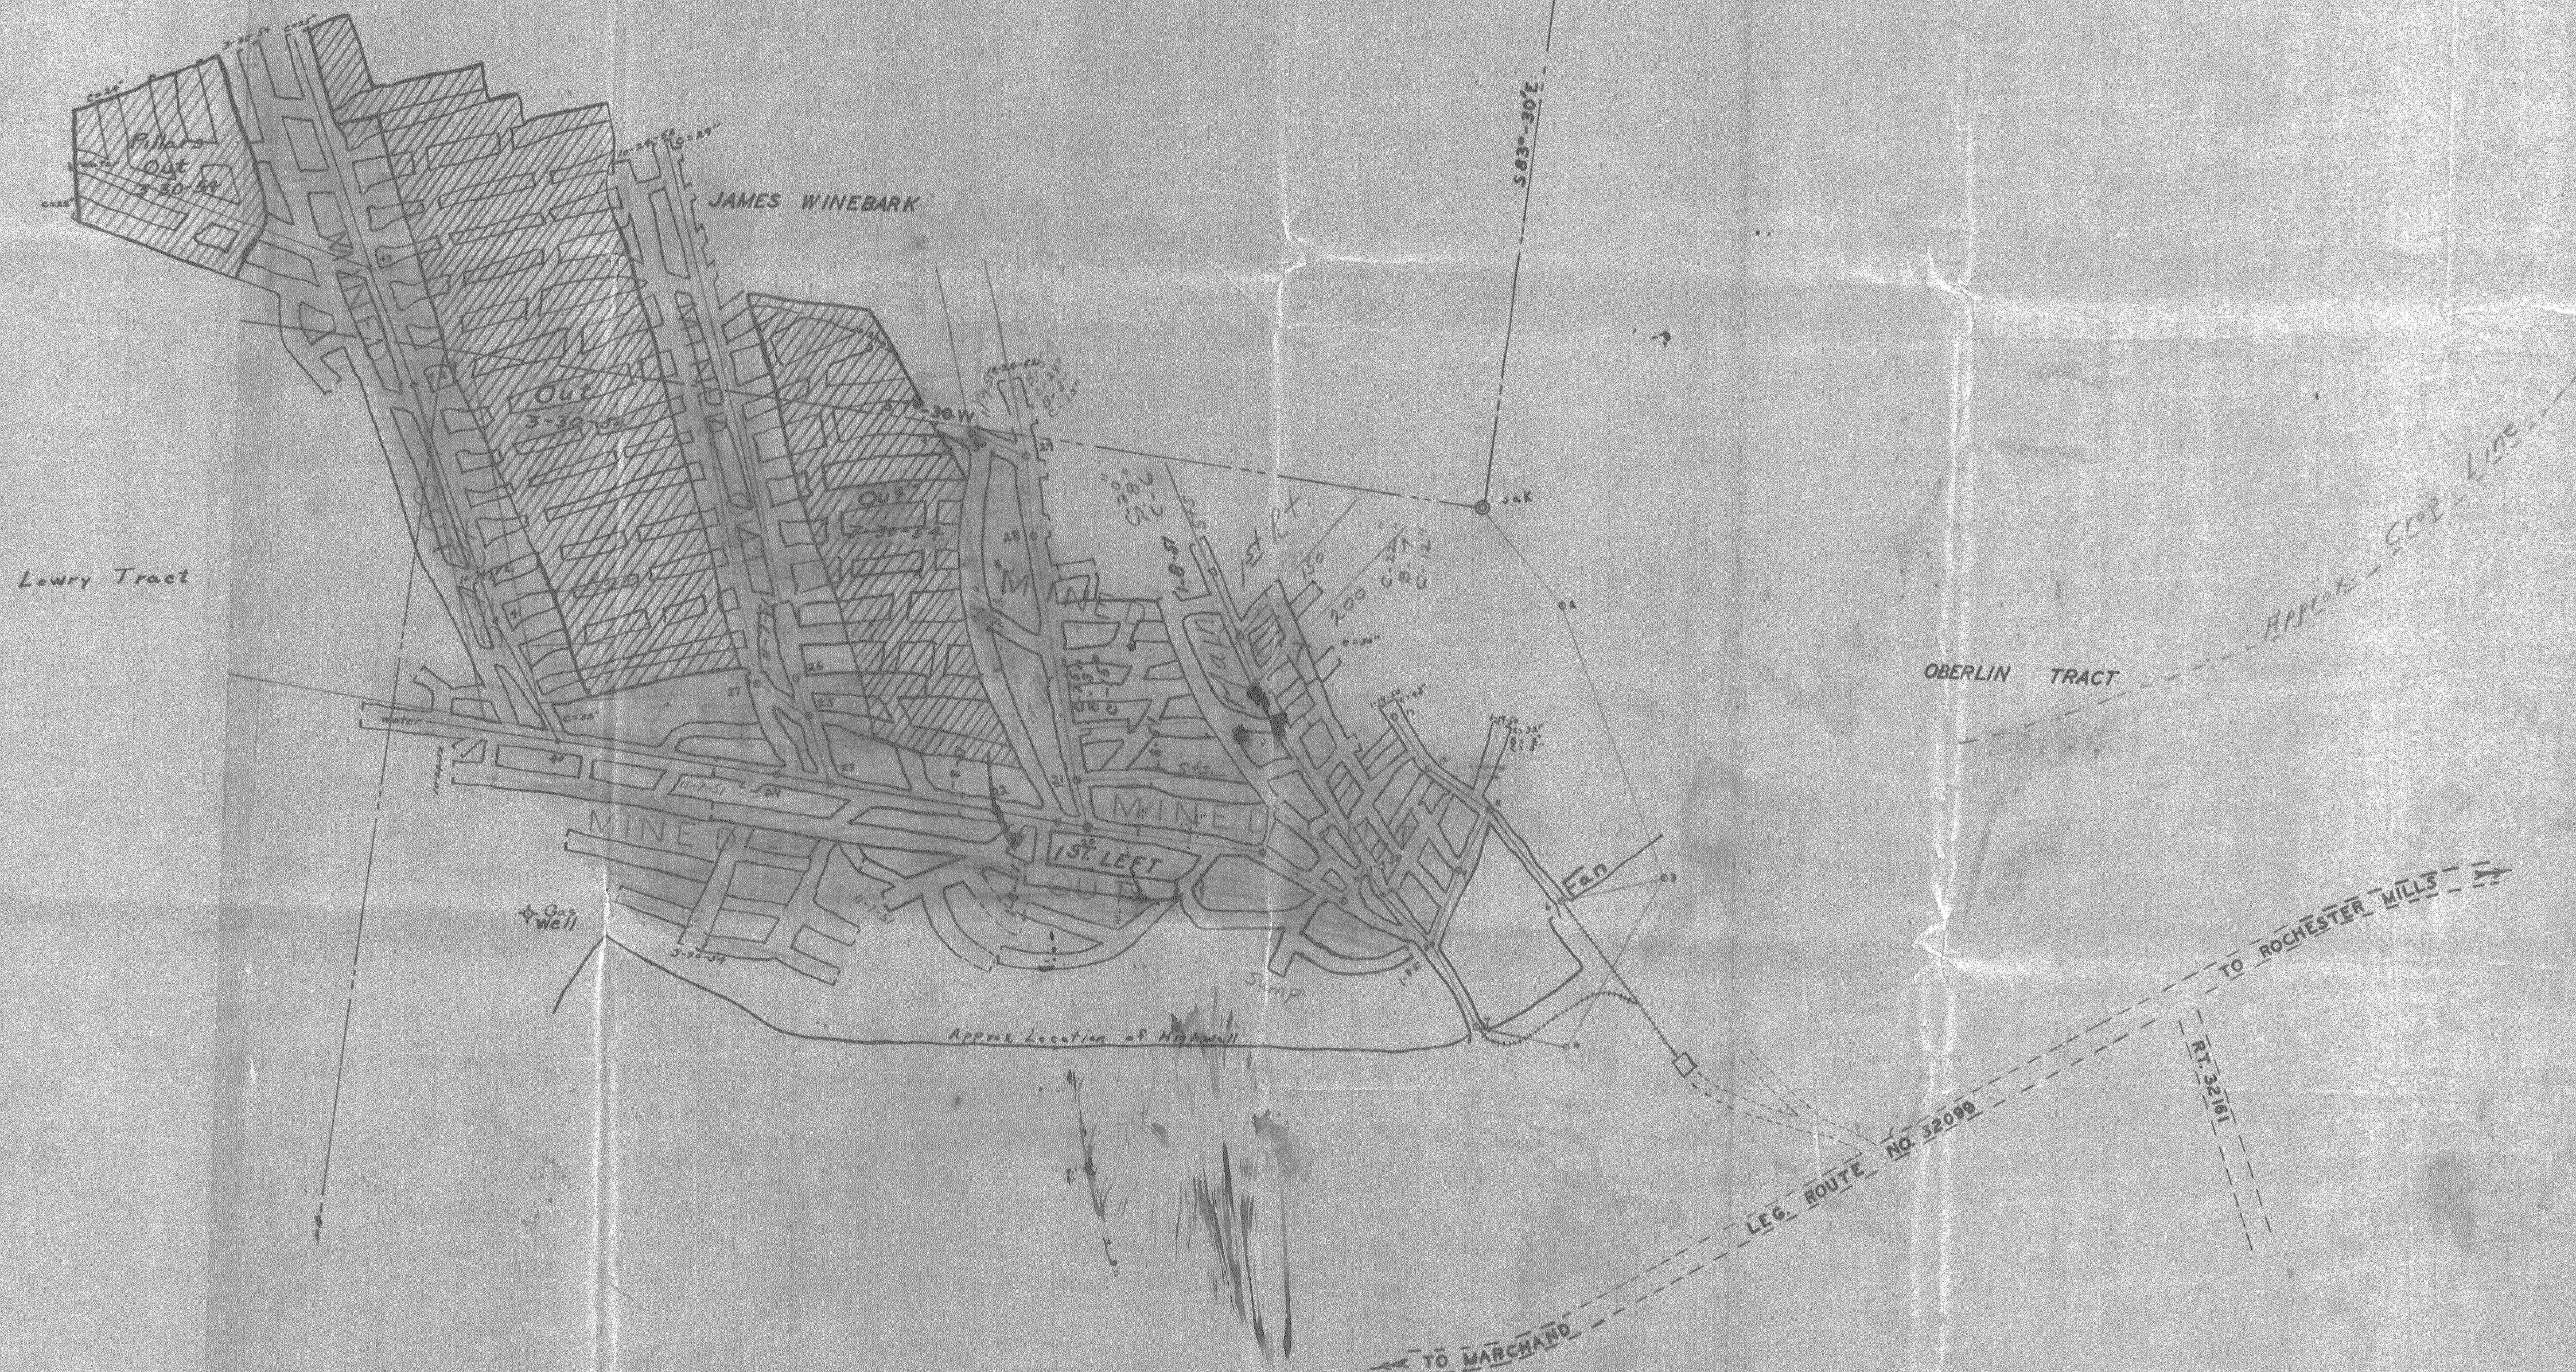

August 31, 1955, I hereby certify that this map
is a true and correct copy of the original map.

Paul L. Rathford
Paul L. Rathford, Reg. Pro. Engr., # 15067

FRIEL NO. 4 MINE

SITUATE CANOE TWP — INDIANA CO., PA.
SCALE 1"=100' JAN. 1950
THOMAS PEALER, REG. PRO. ENGR.
Q. B. Jones - October 1952 - March 30, 1954

Operation ceased June 5, 1955.
Mine permanently abandoned.

F.B. 2071 P. 54 FORMERLY L.V. MARSHALL

#1000
7-20-54
C.C.

R-92