
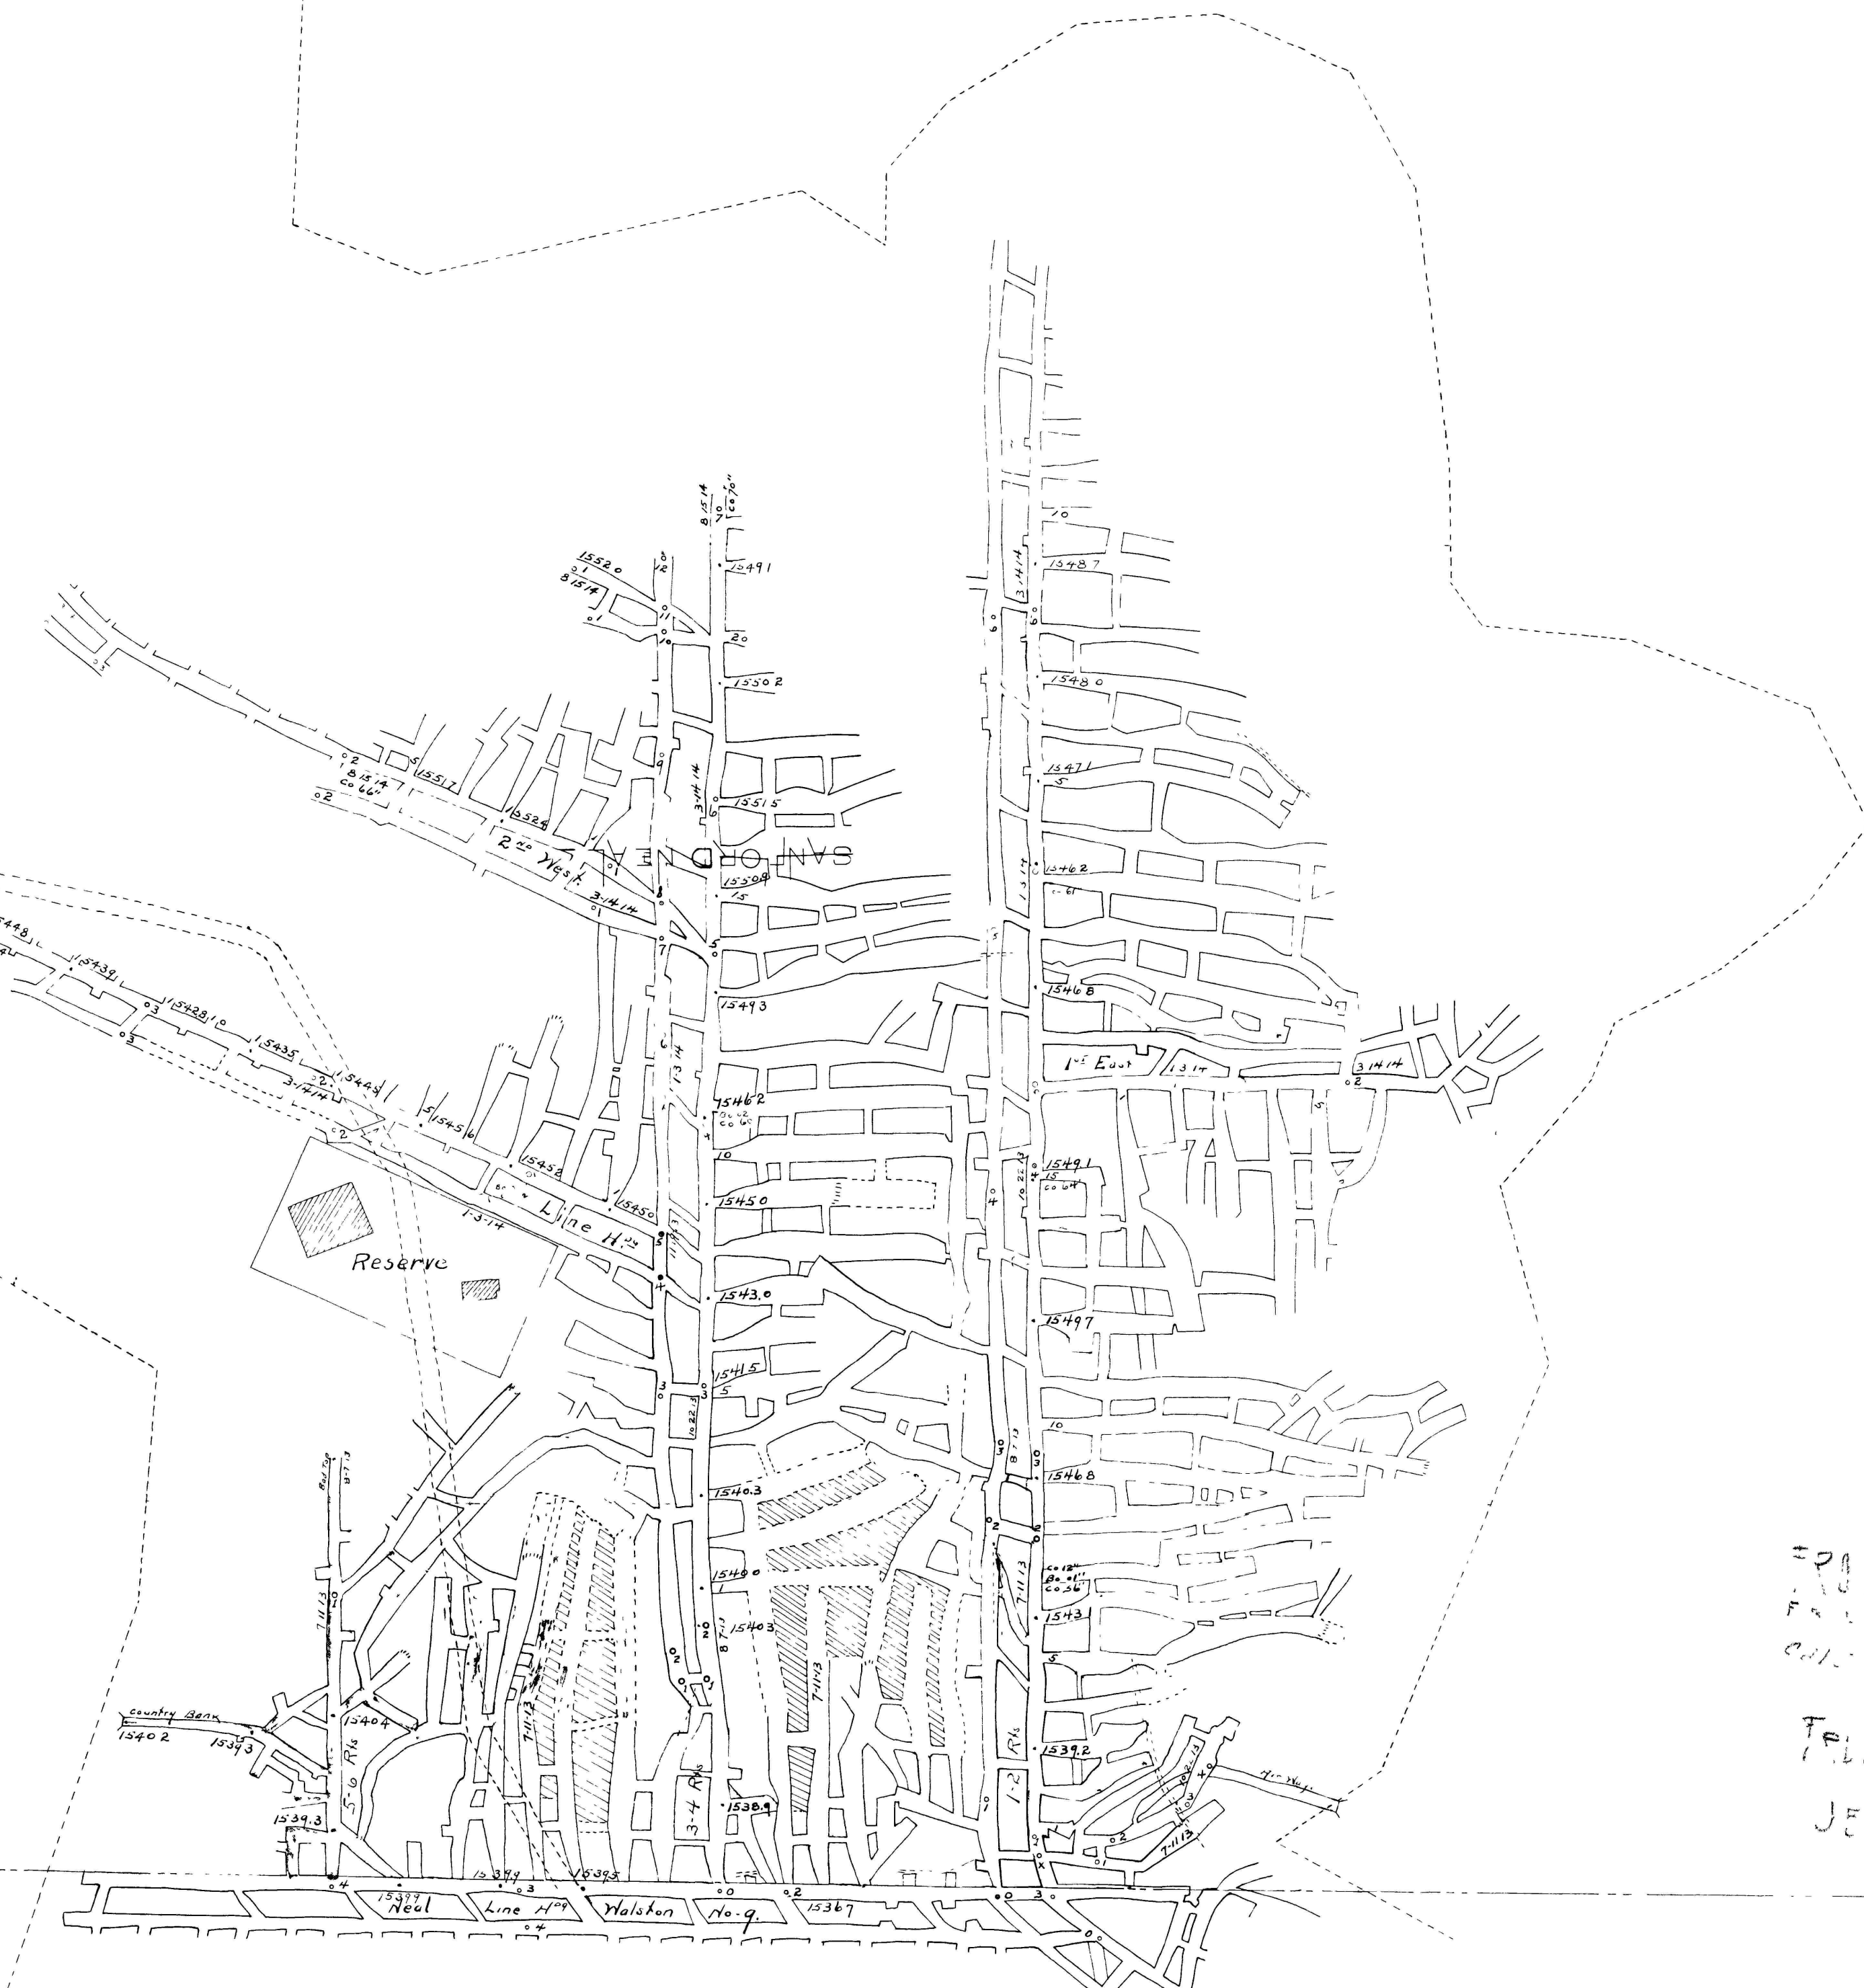


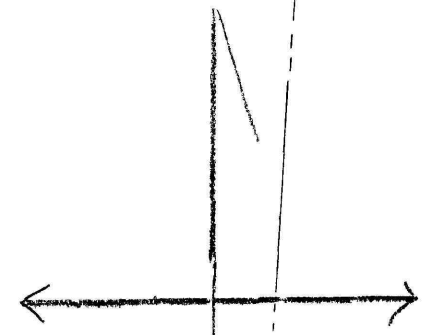

POSTER, MINE  
CAL. 1" = 100'  
TALBURG COAL CO.  
JEFFERSON CO.