

UNITED STATES
DEPARTMENT OF THE INTERIOR
GEOLOGICAL SURVEY

UNITED STATES
DEPARTMENT OF THE ARMY
CORPS OF ENGINEERS
(SOMERSET)


MEYERSDALE QUADRANGLE
PENNSYLVANIA-SOMERSET CO
15 MINUTE SERIES (TOPOGRAPHIC)



FOGLE-WOULLARD
BLACK TOWNSHIP
SOMERSET COUNTY
PERMIT NUMBER-141-1
"A"-OR BROOKVILLE SEAM

EGGLE COAL CO. - A SEAM
ELY & FRENCH Oct 10, 1966

Map by the Army Map Service and the Geological Survey
Published for civil use by the Geological Survey
Control by USGS
Topography by plane table surveys by USGS 1919
Planimetry revised by AMS from aerial photographs taken 1939
Polyconic projection 1927 North American datum
10 000 foot grid based on Pennsylvania coordinate system
south zone
1000 meter Universal Transverse Mercator grid ticks
zone 17 shown in blue

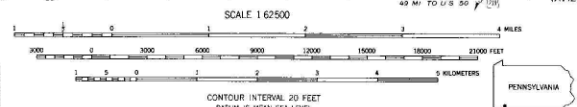

ROAD CLASSIFICATION
Heavy duty ——— Light duty ———
Medium duty ——— Unimproved dirt ———
U.S. Route ——— State Route ———

MEYERSDALE PA
13945-132015