


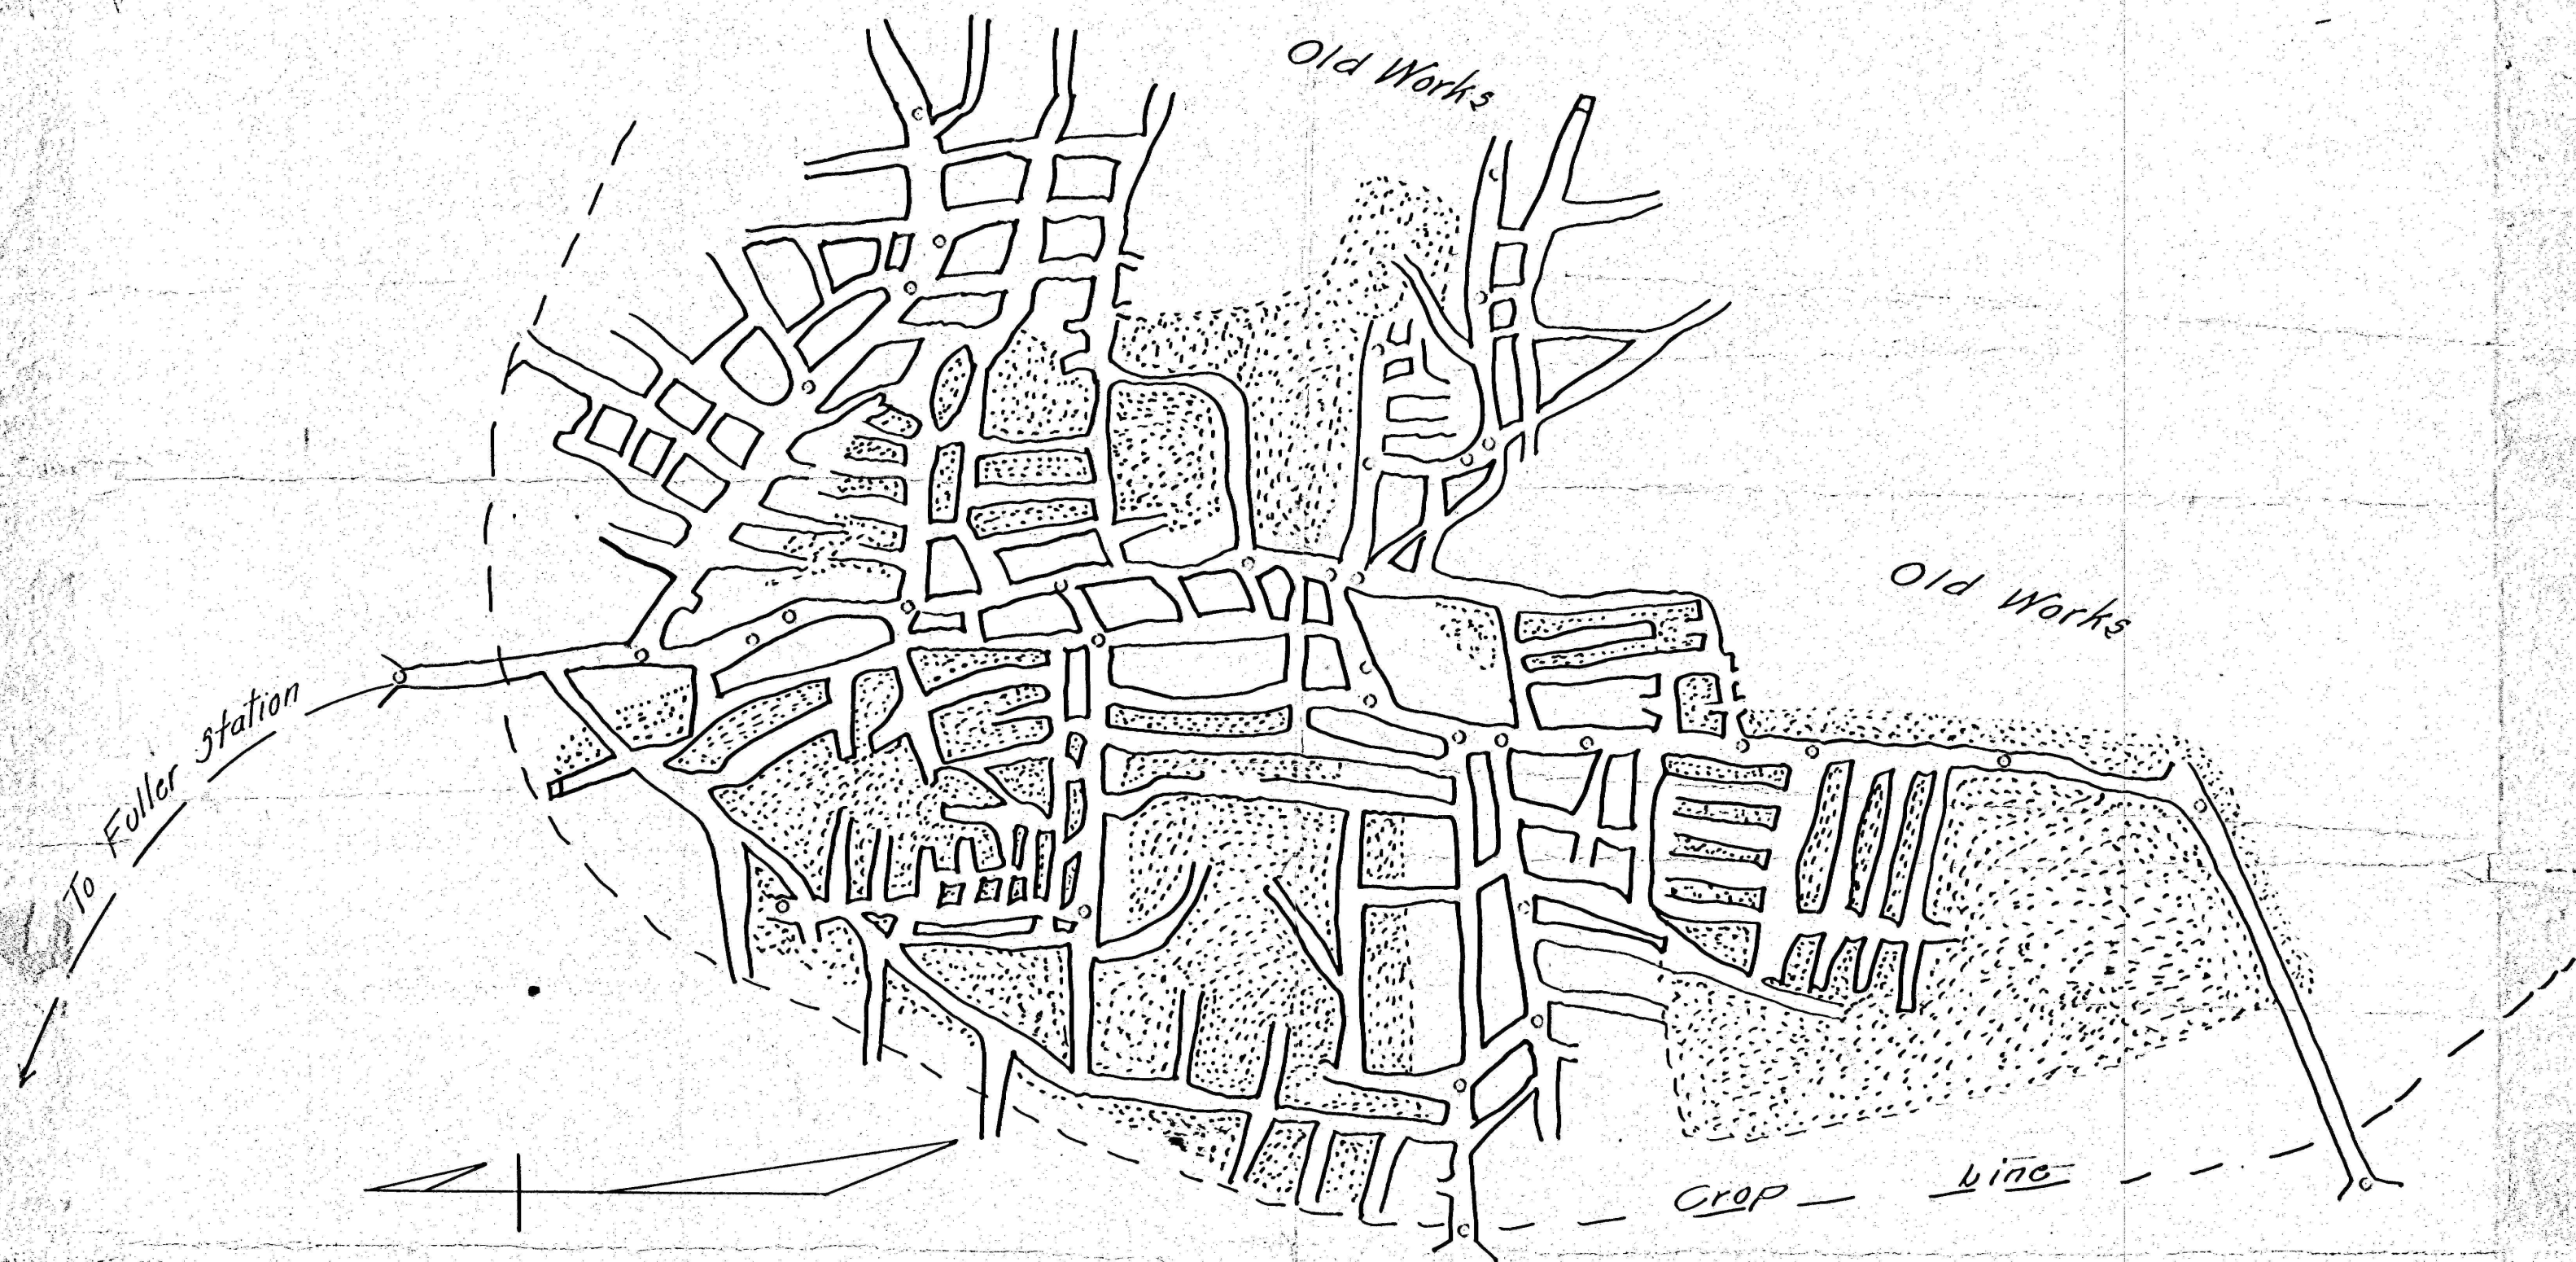

I hereby certify that this tracing is a
true and correct copy of the Original
Map of the Fuller Mine #2, Knox Twp.
Jeff. Co. Pa.

January 1929 Fred D. Hays C.E.

Stewart Coal Company
Fuller Mine #2

Knox Township Jeff. Co. Pa.

Jan 1929

Scale 1"=100'