


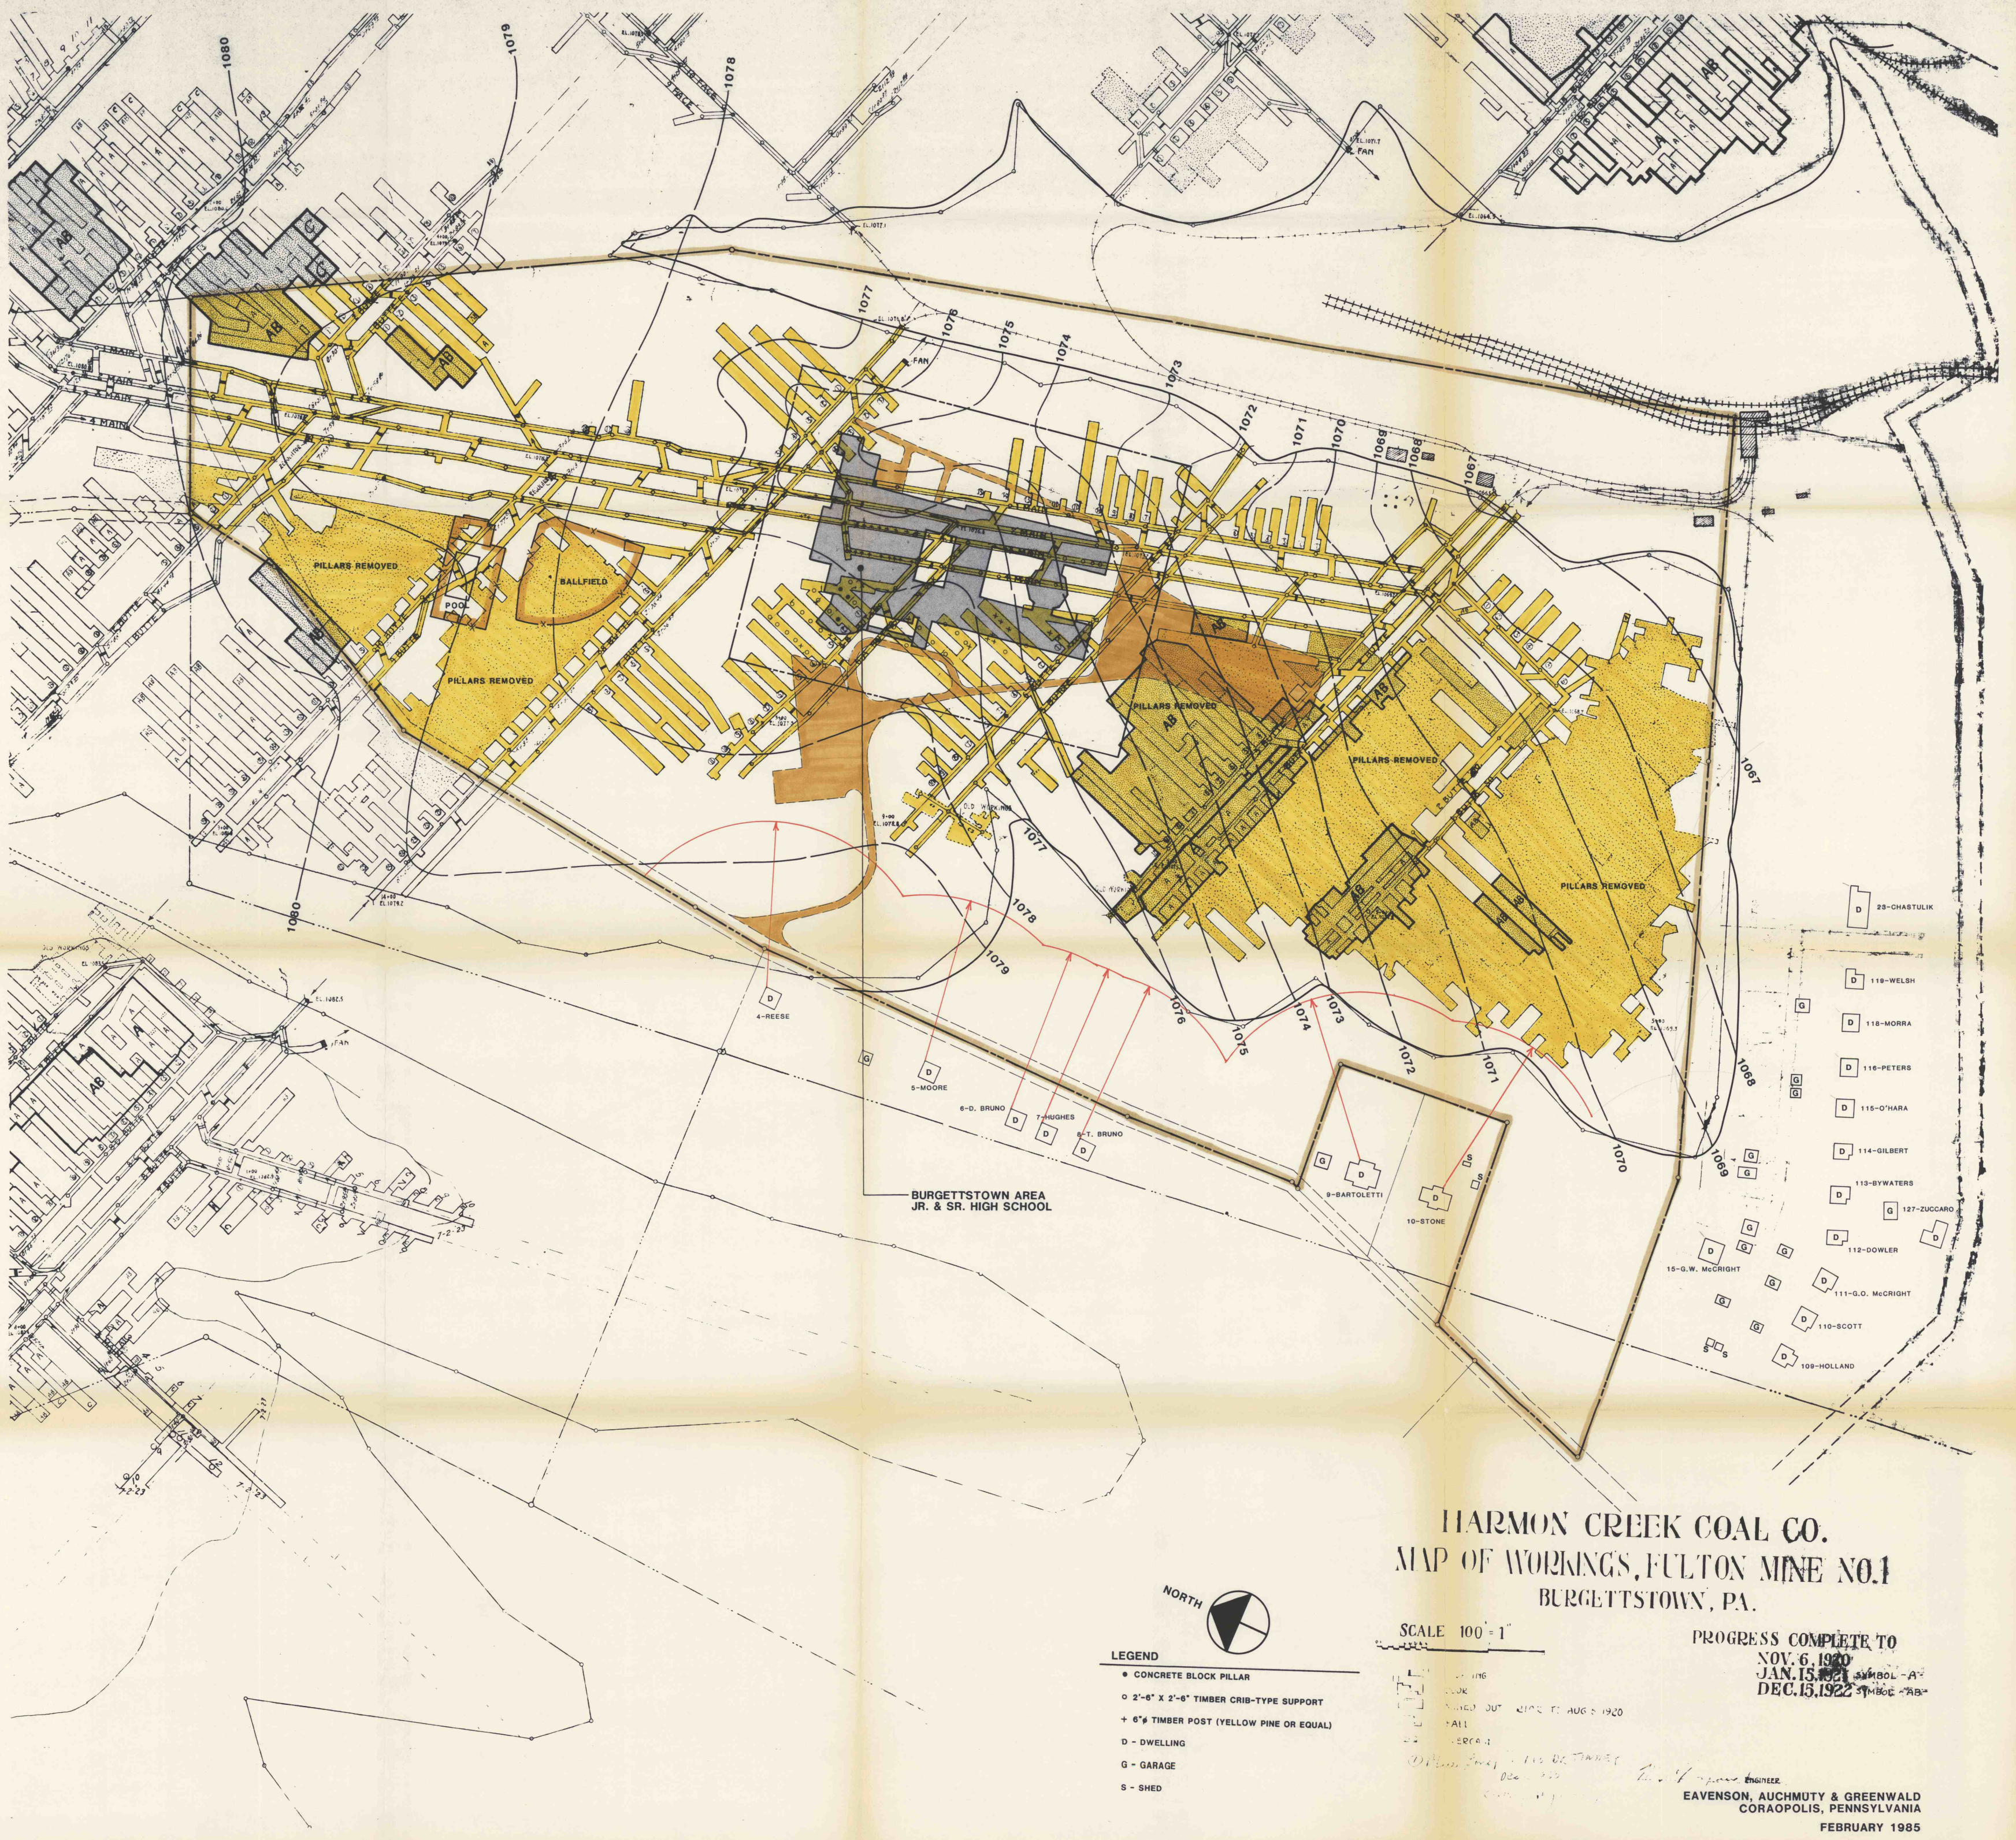

HARMON CREEK COAL CO.
MAP OF WORKINGS, FULTON MINE NO. 1
BURGETTSTOWN, PA.

LEGEND

- CONCRETE BLOCK PILLAR
- 2'-6" X 2'-6" TIMBER CRIB-TYPE SUPPORT
- + 6" TIMBER POST (YELLOW PINE OR EQUAL)
- D - DWELLING
- G - GARAGE
- S - SHED

SCALE 100' = 1"

PROGRESS COMPLETE TO
NOV. 6, 1920
JAN. 15, 1921
DEC. 15, 1922

EAVENSON, AUCHMUTY & GREENWALD
CORAOPLIS, PENNSYLVANIA
FEBRUARY 1985