


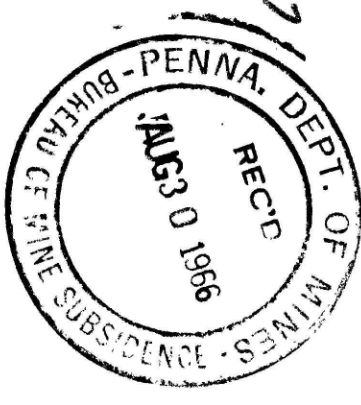

— Area Worked July-1966
— Area Tenent Top Coal Taken 1967



S. S. Loucks