
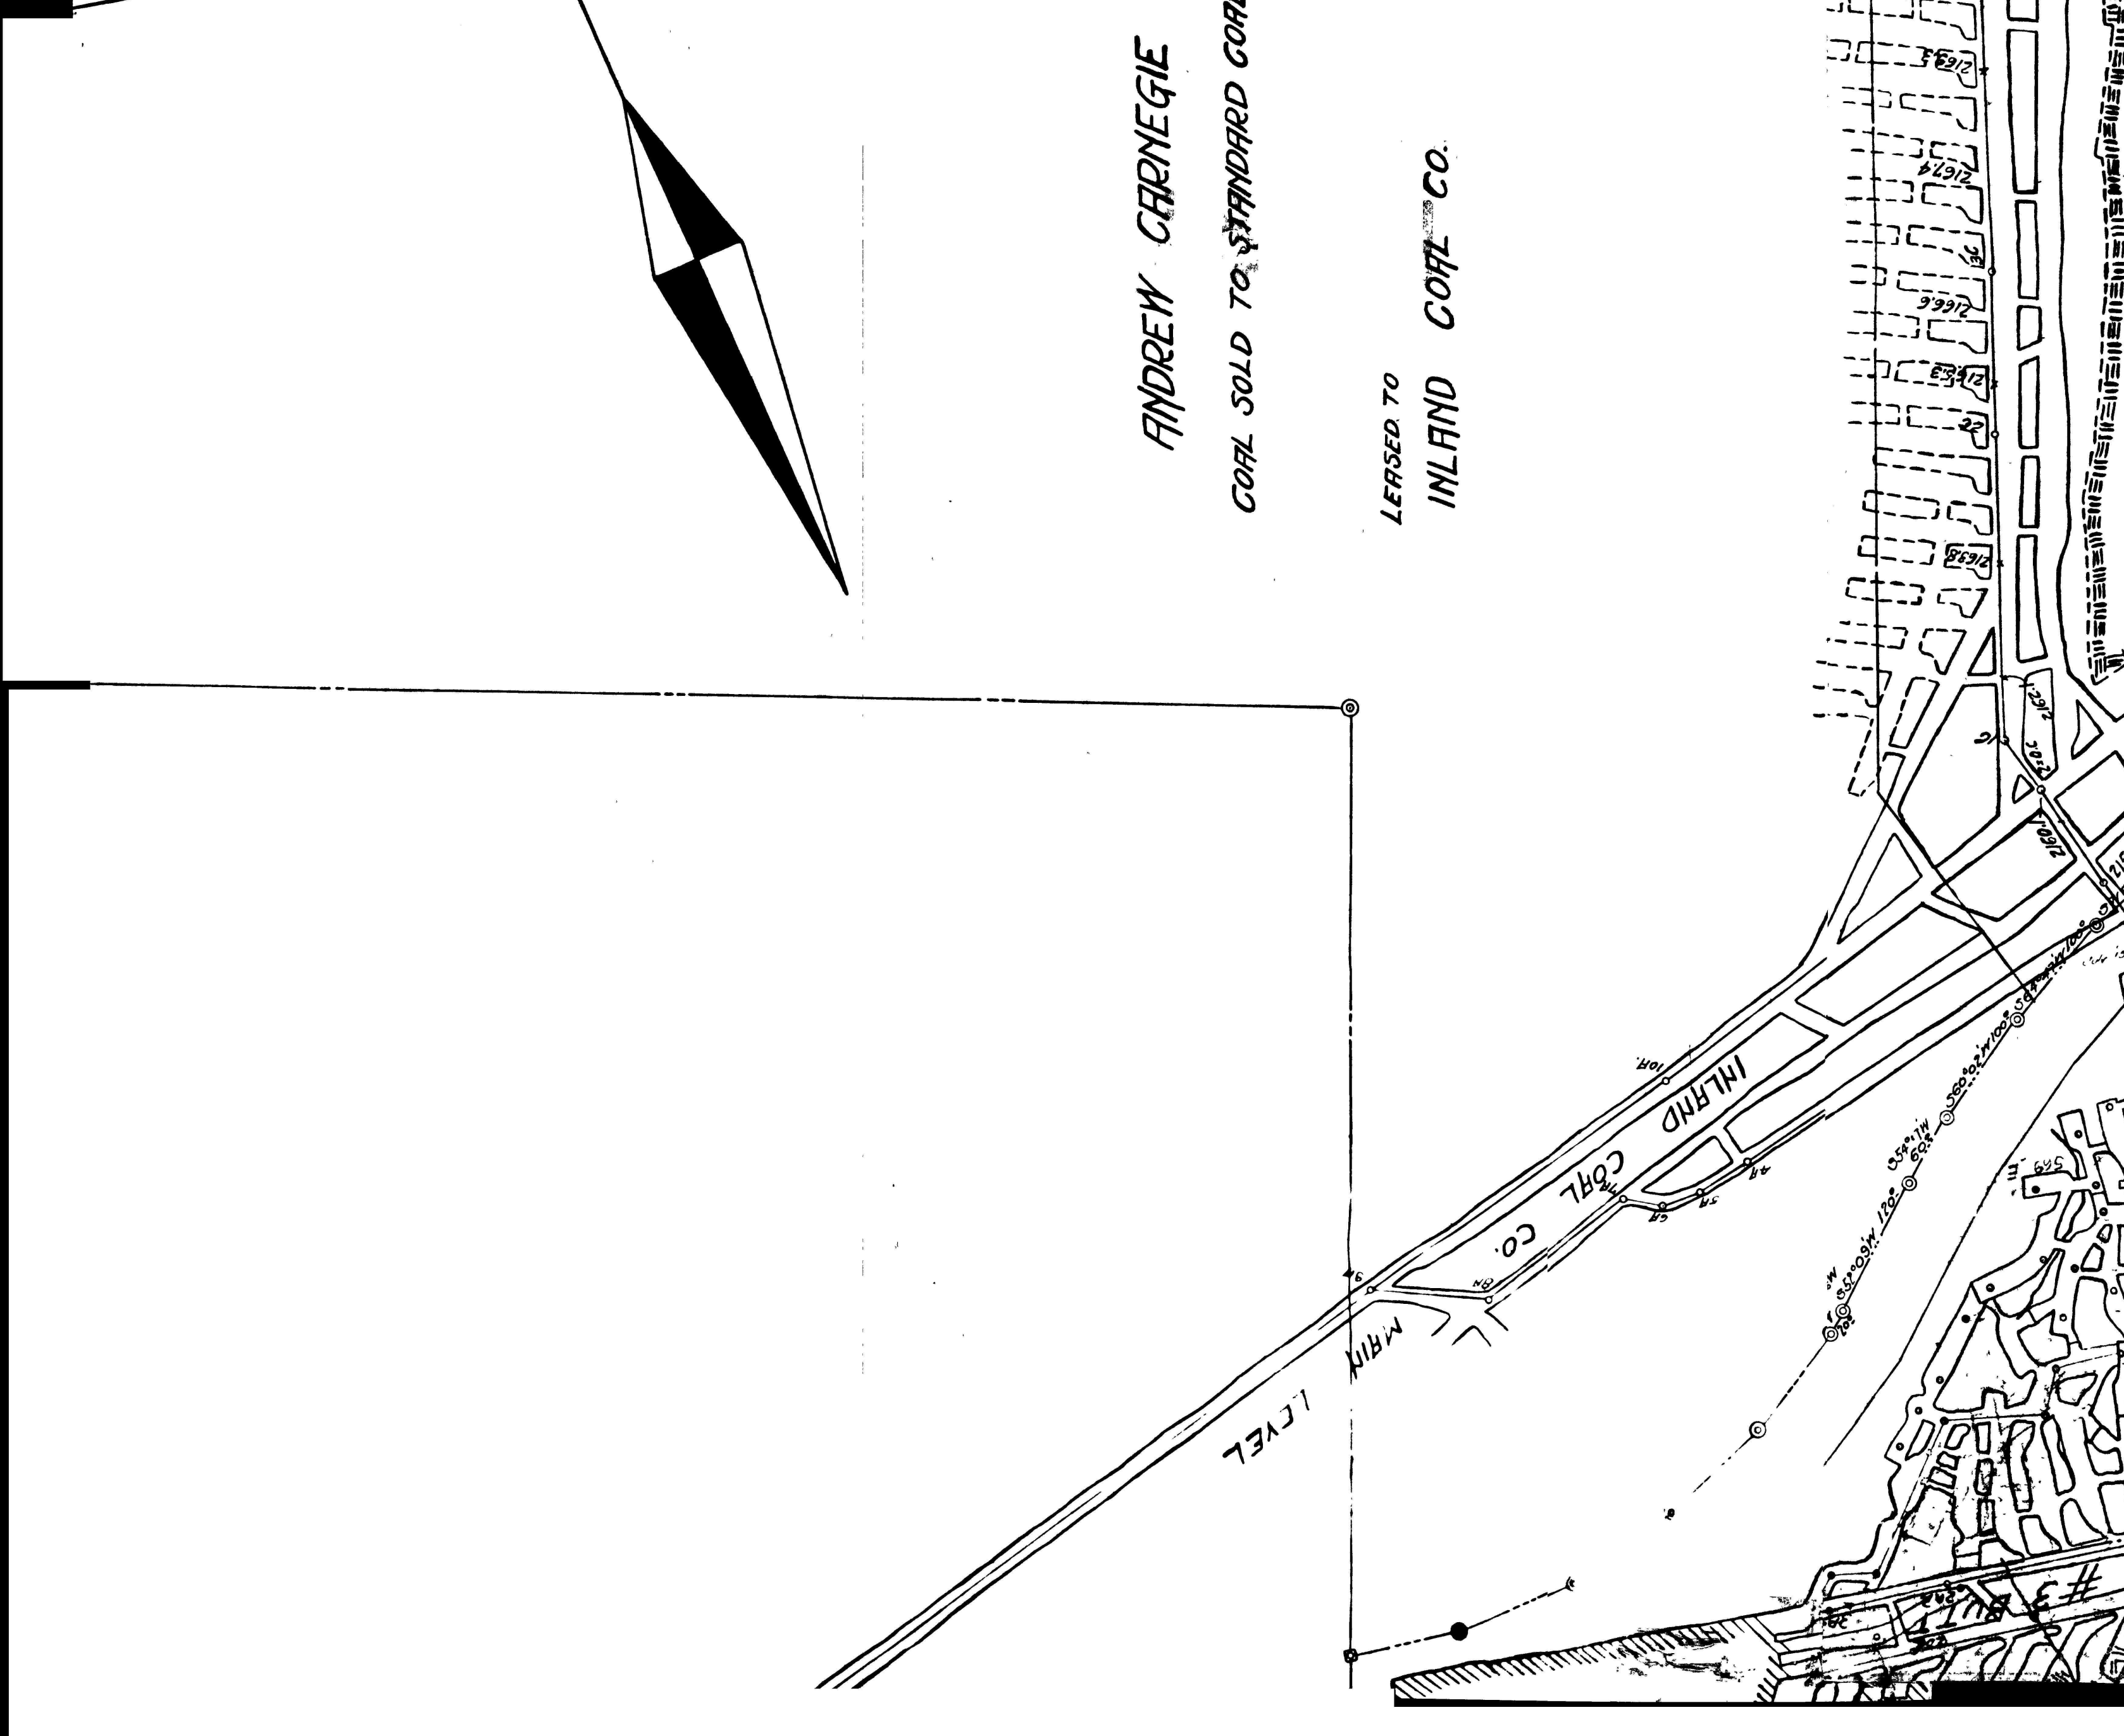


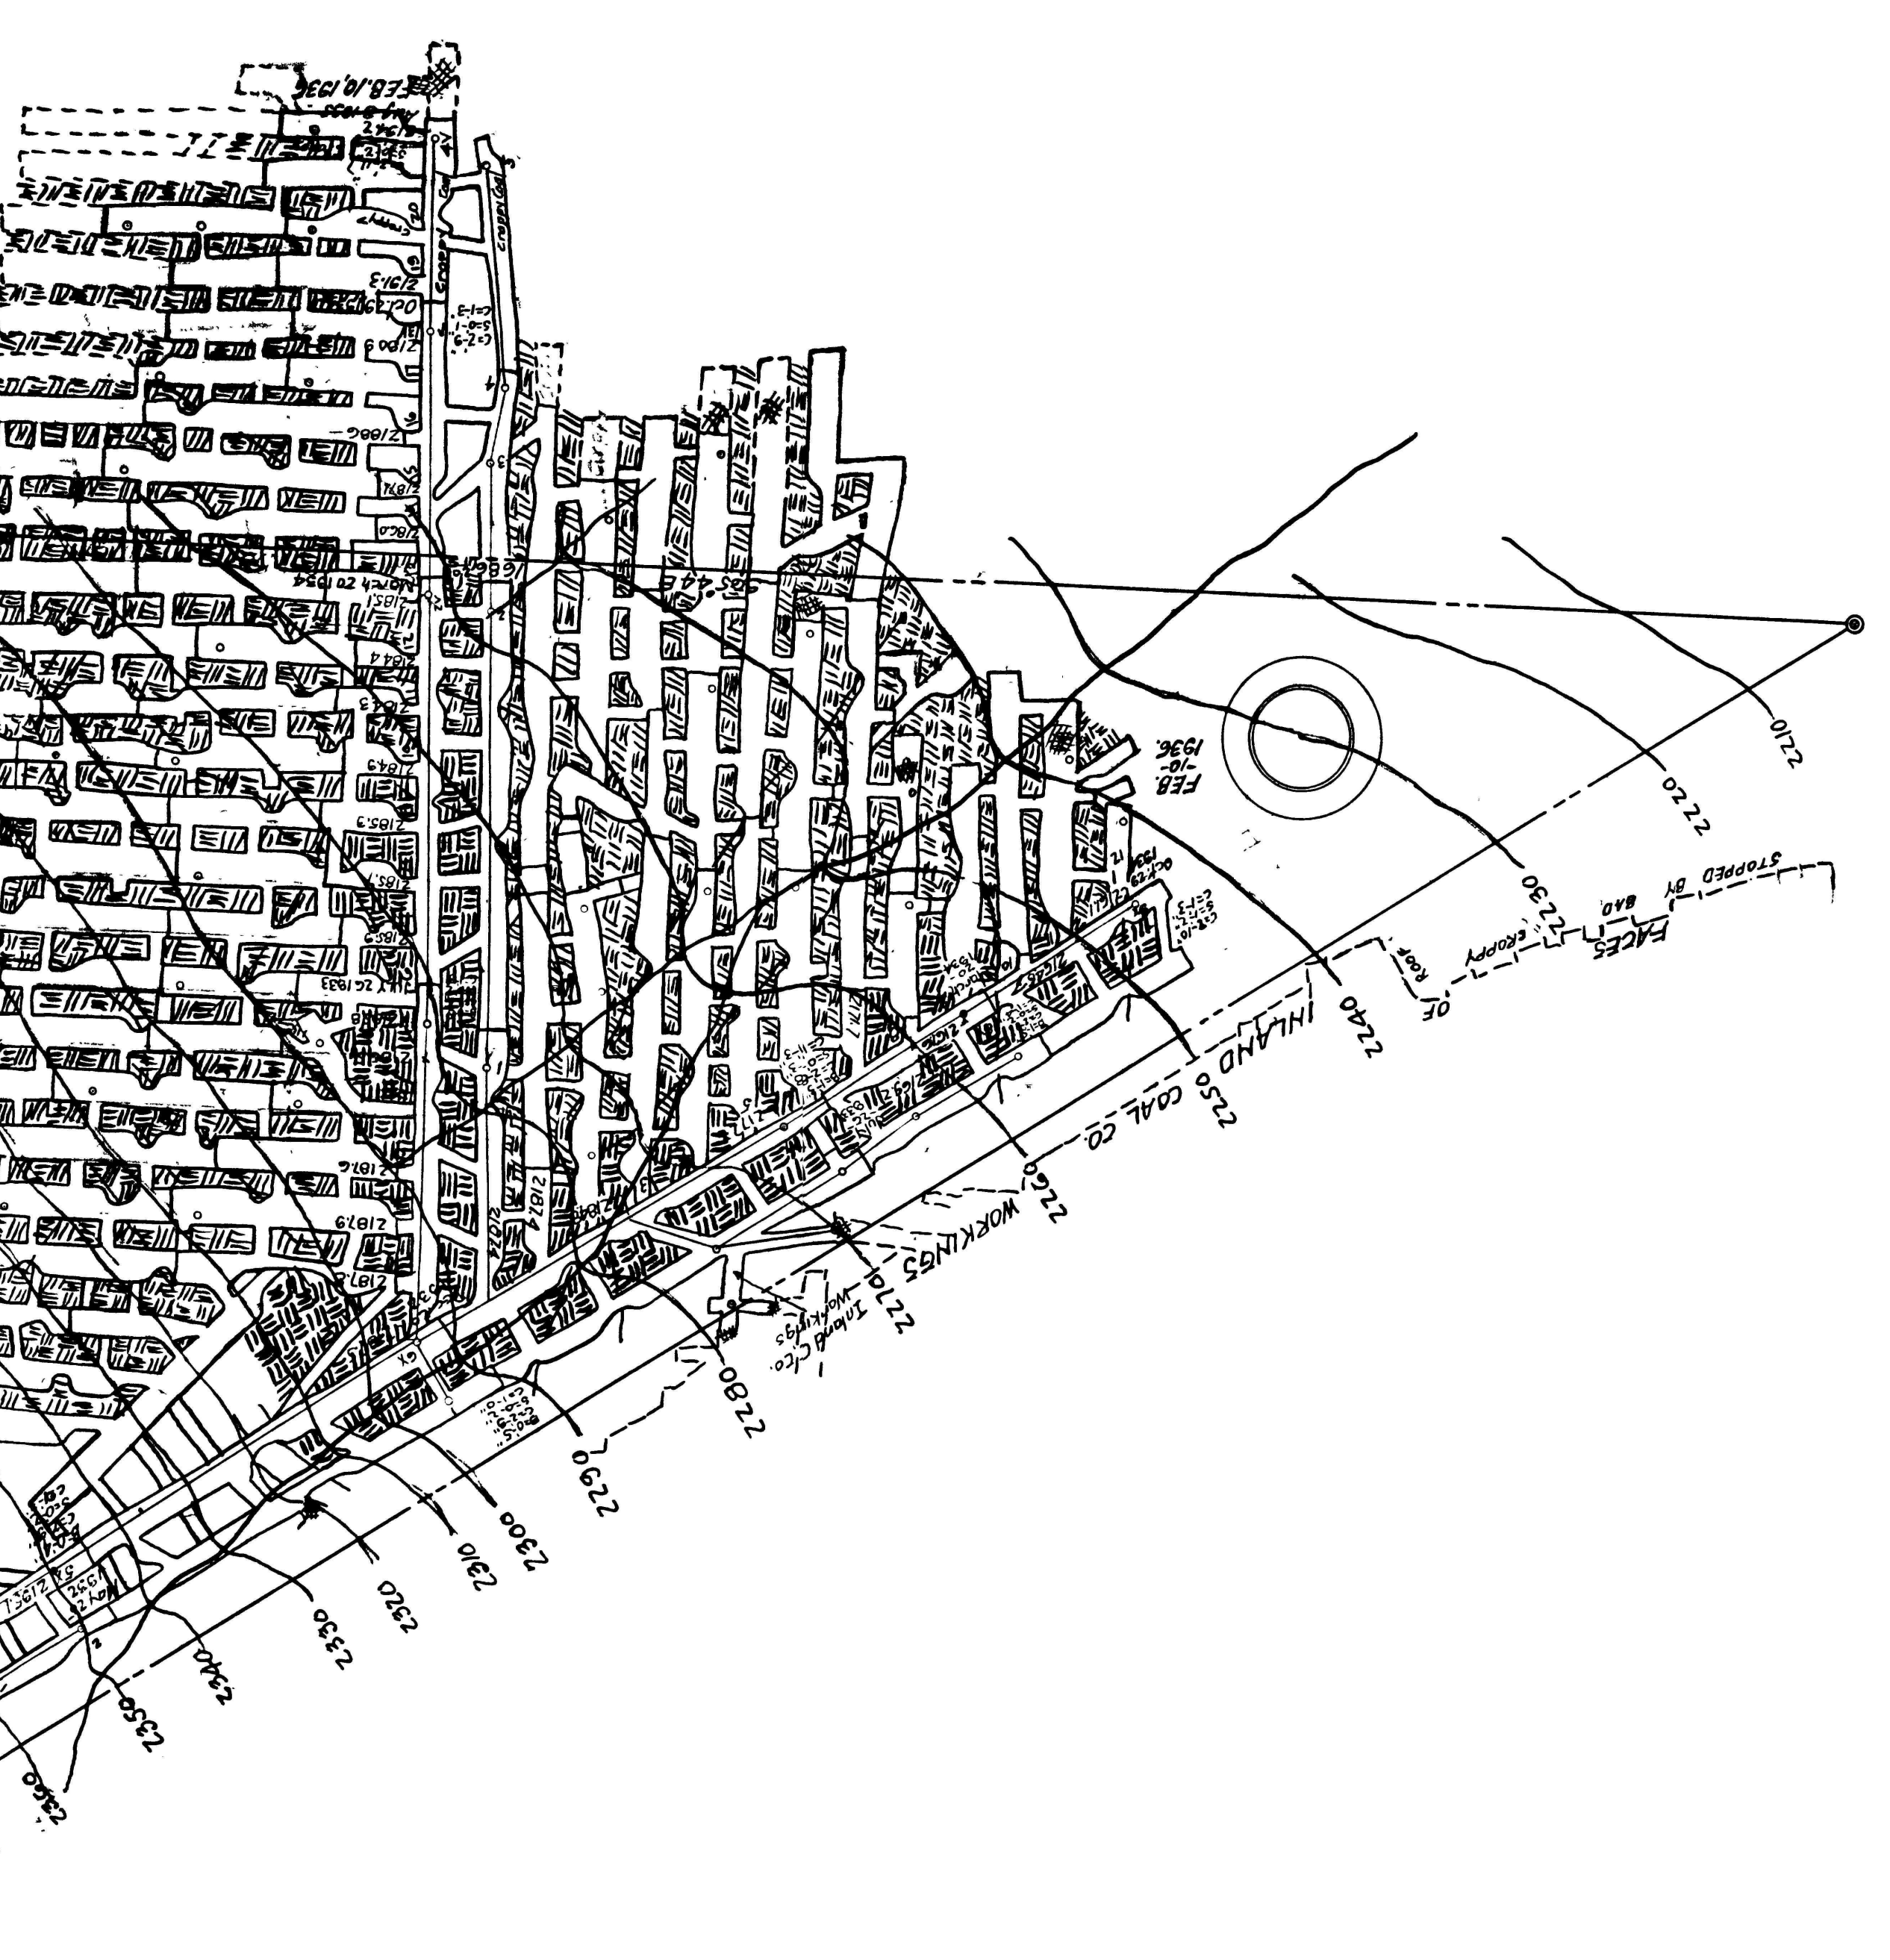

ANDREW CARNEGIE
COAL SOLD TO STANDARD COAL CO.

LEASED TO
INLAND COAL CO.

MINED OUT