


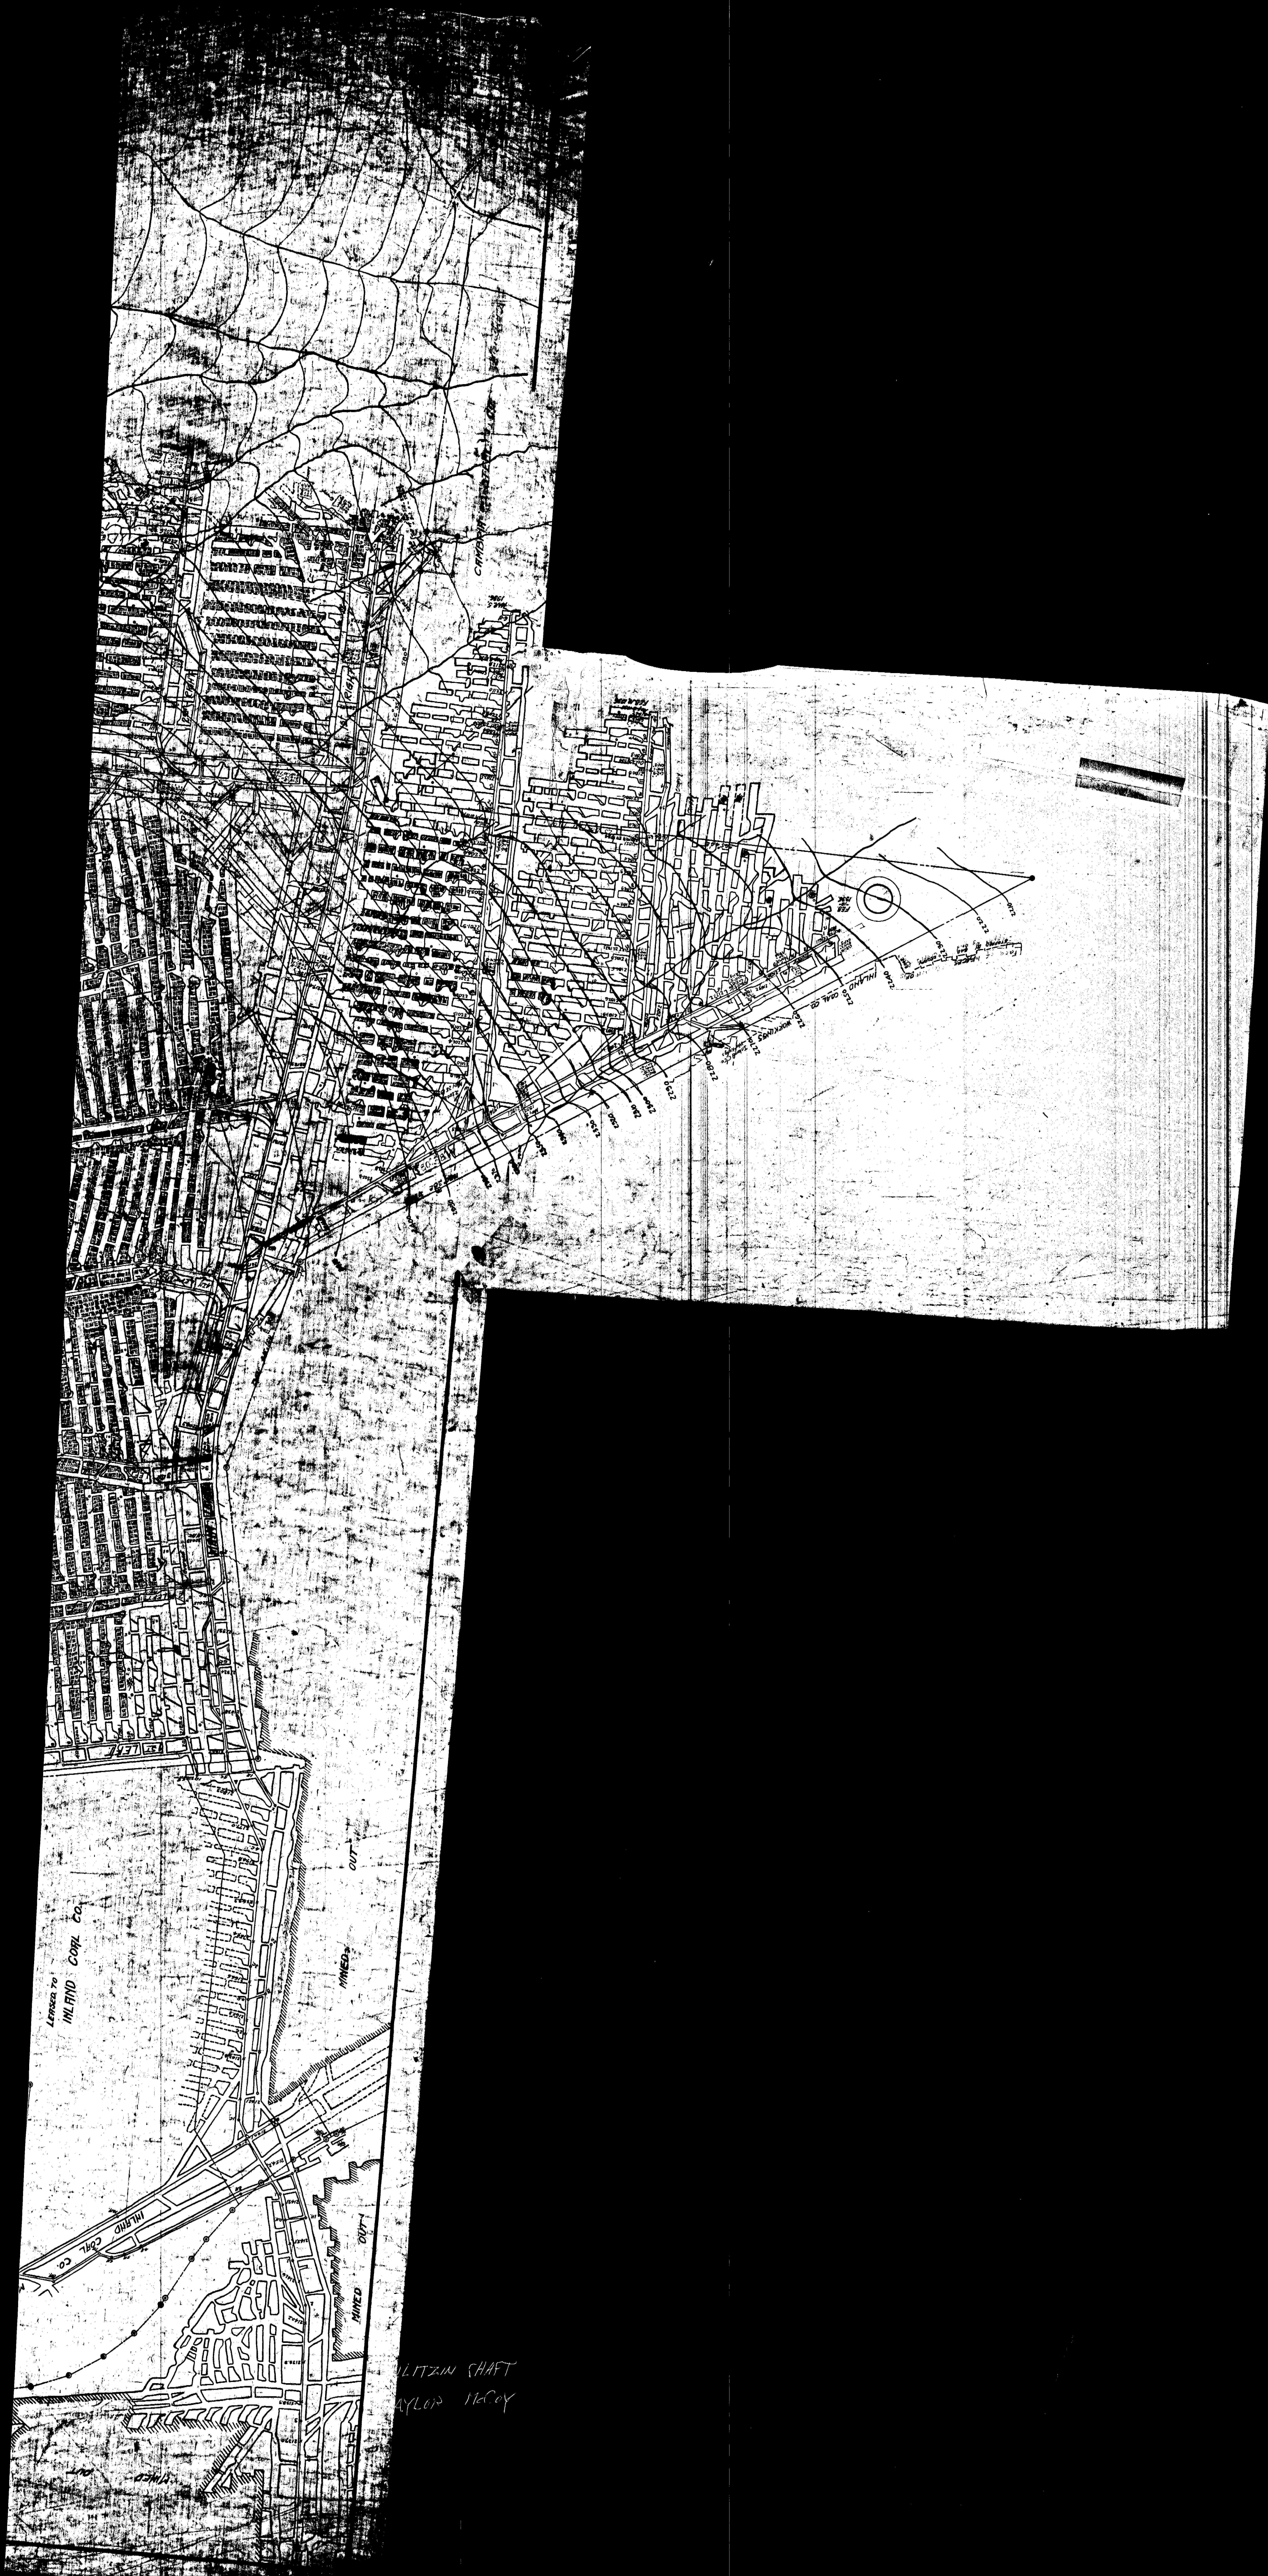


LITZIN SHAF
AYLER MCCOY