


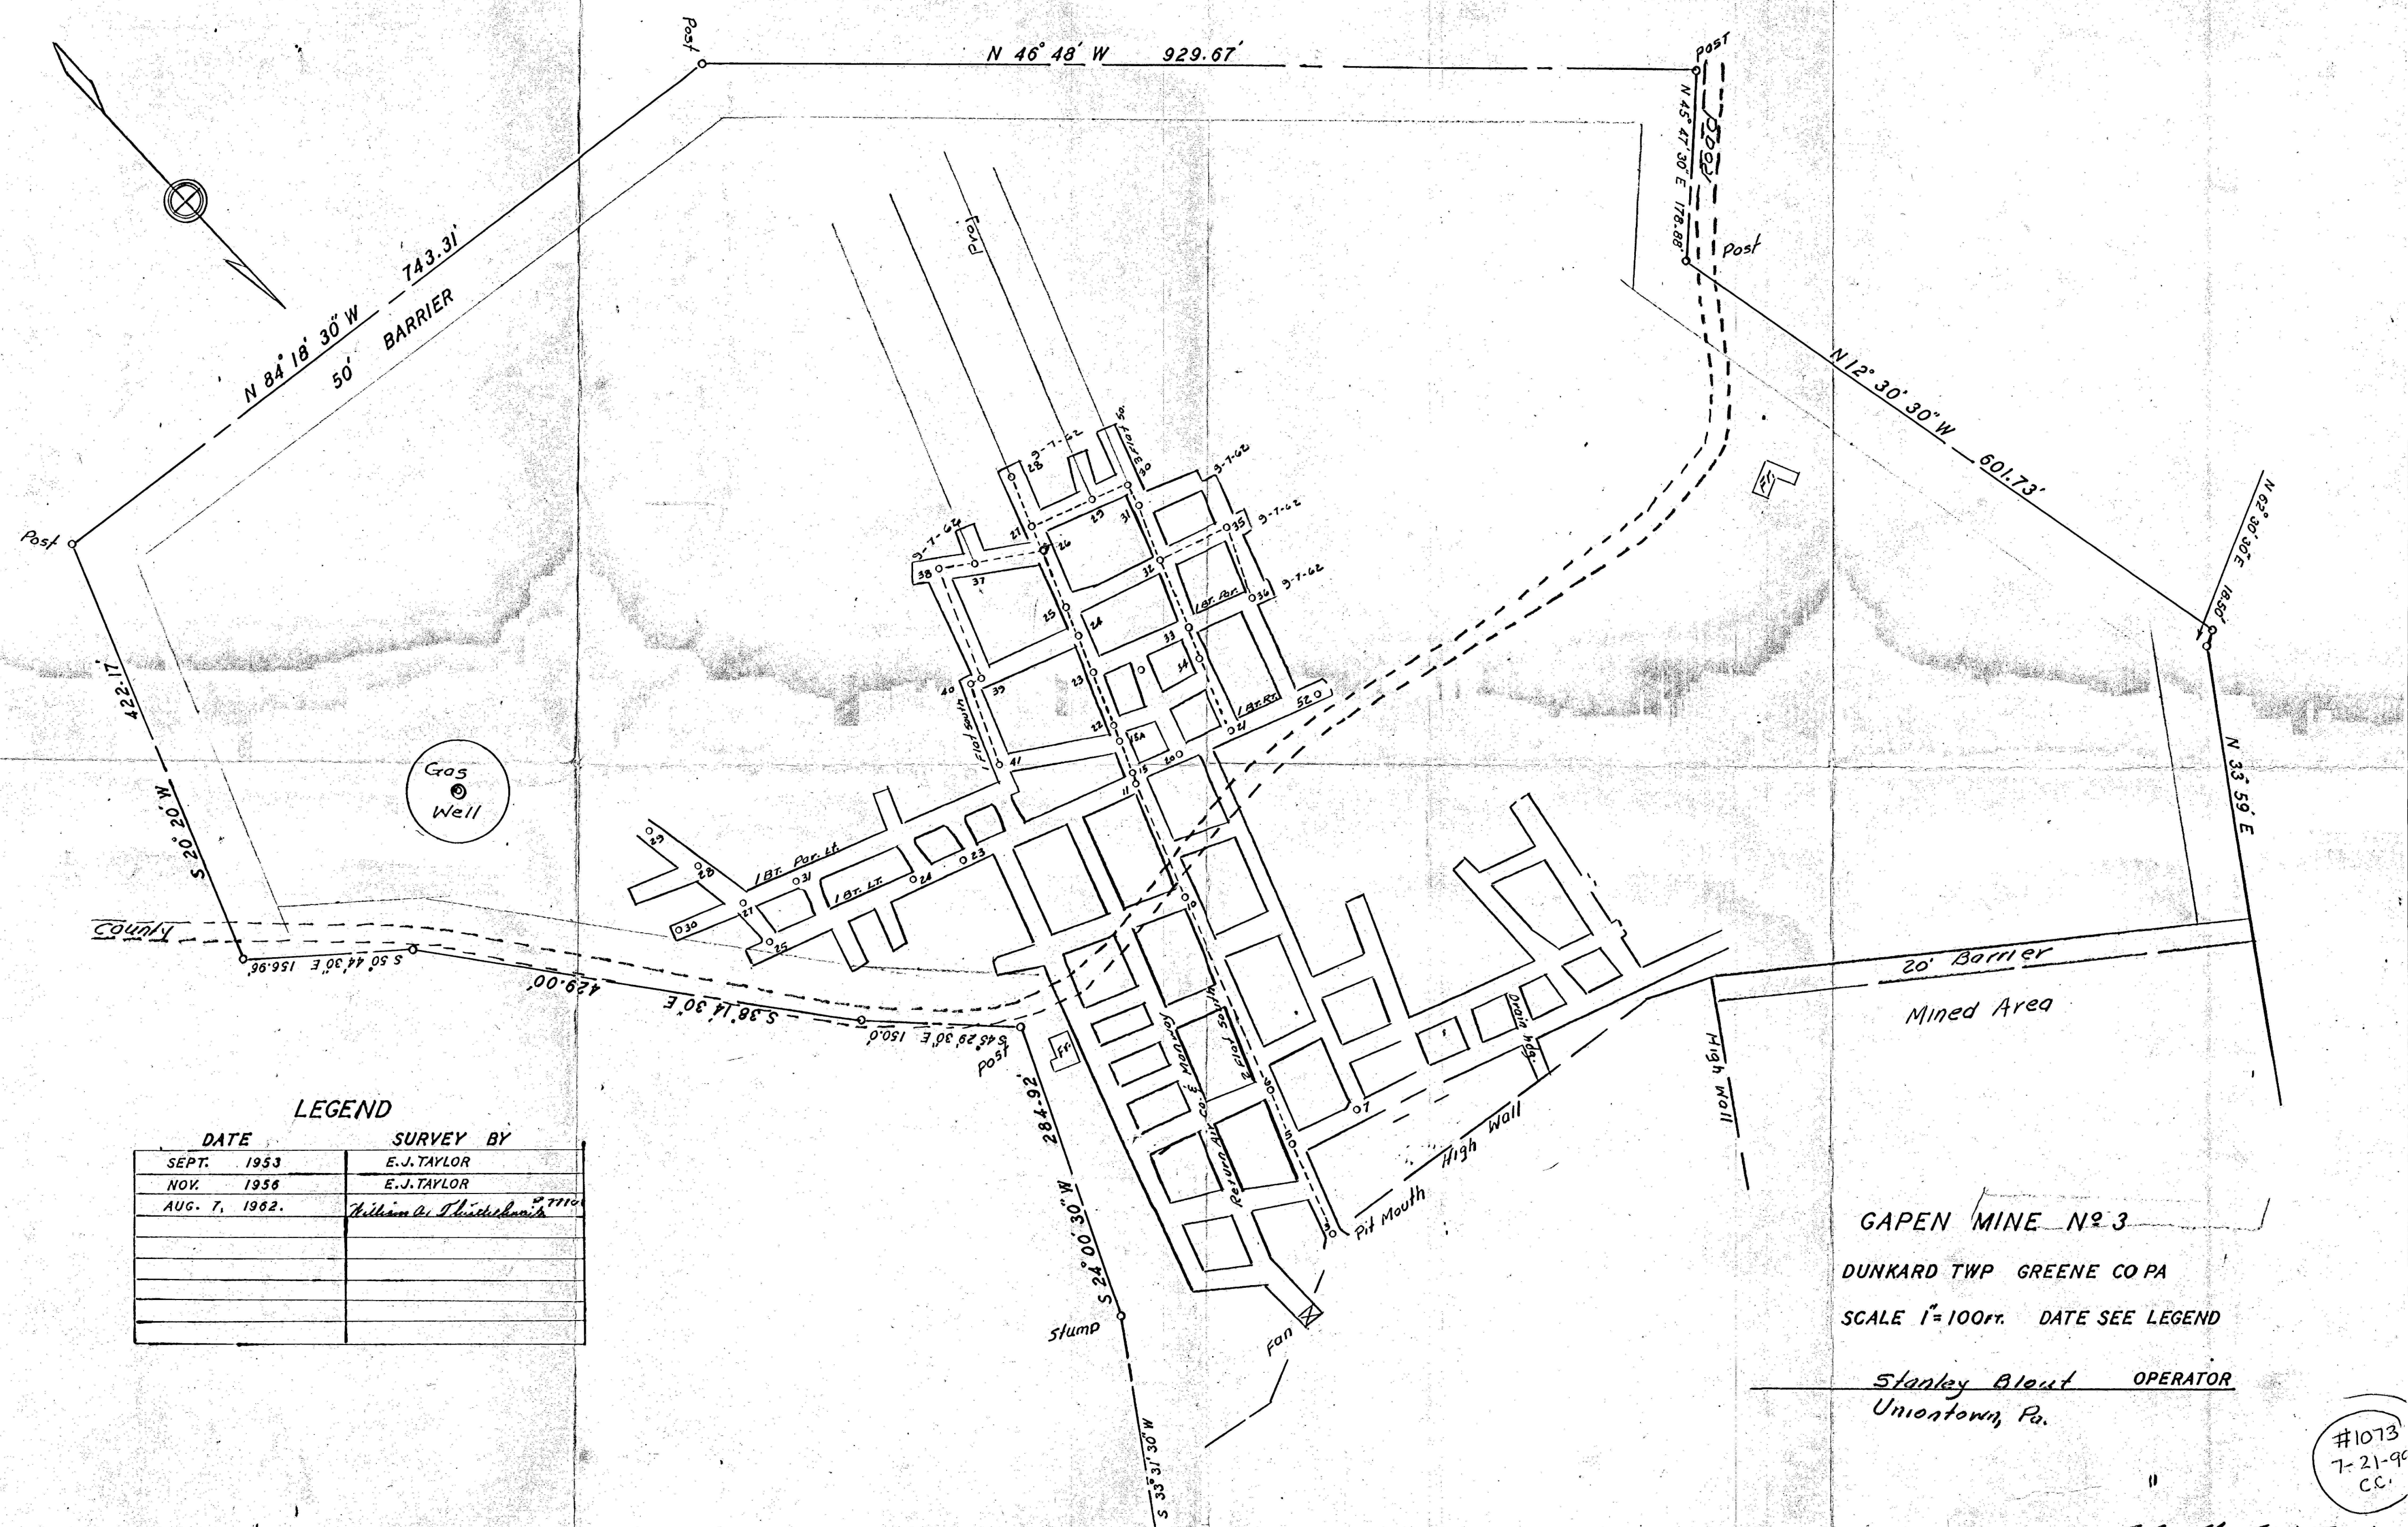

LEGEND

DATE	SURVEY BY
SEPT. 1953	E.J. TAYLOR
NOV. 1956	E.J. TAYLOR
AUG. 7, 1962.	William A. Thierman

GAPEN MINE No. 3

DUNKARD TWP GREENE CO PA

SCALE 1"=100ft. DATE SEE LEGEND

Stanley Blout OPERATOR
Uniontown, Pa.

#1073
7-21-96
CC.

Ref. Charles H. Reed
Bobtown, Pa.