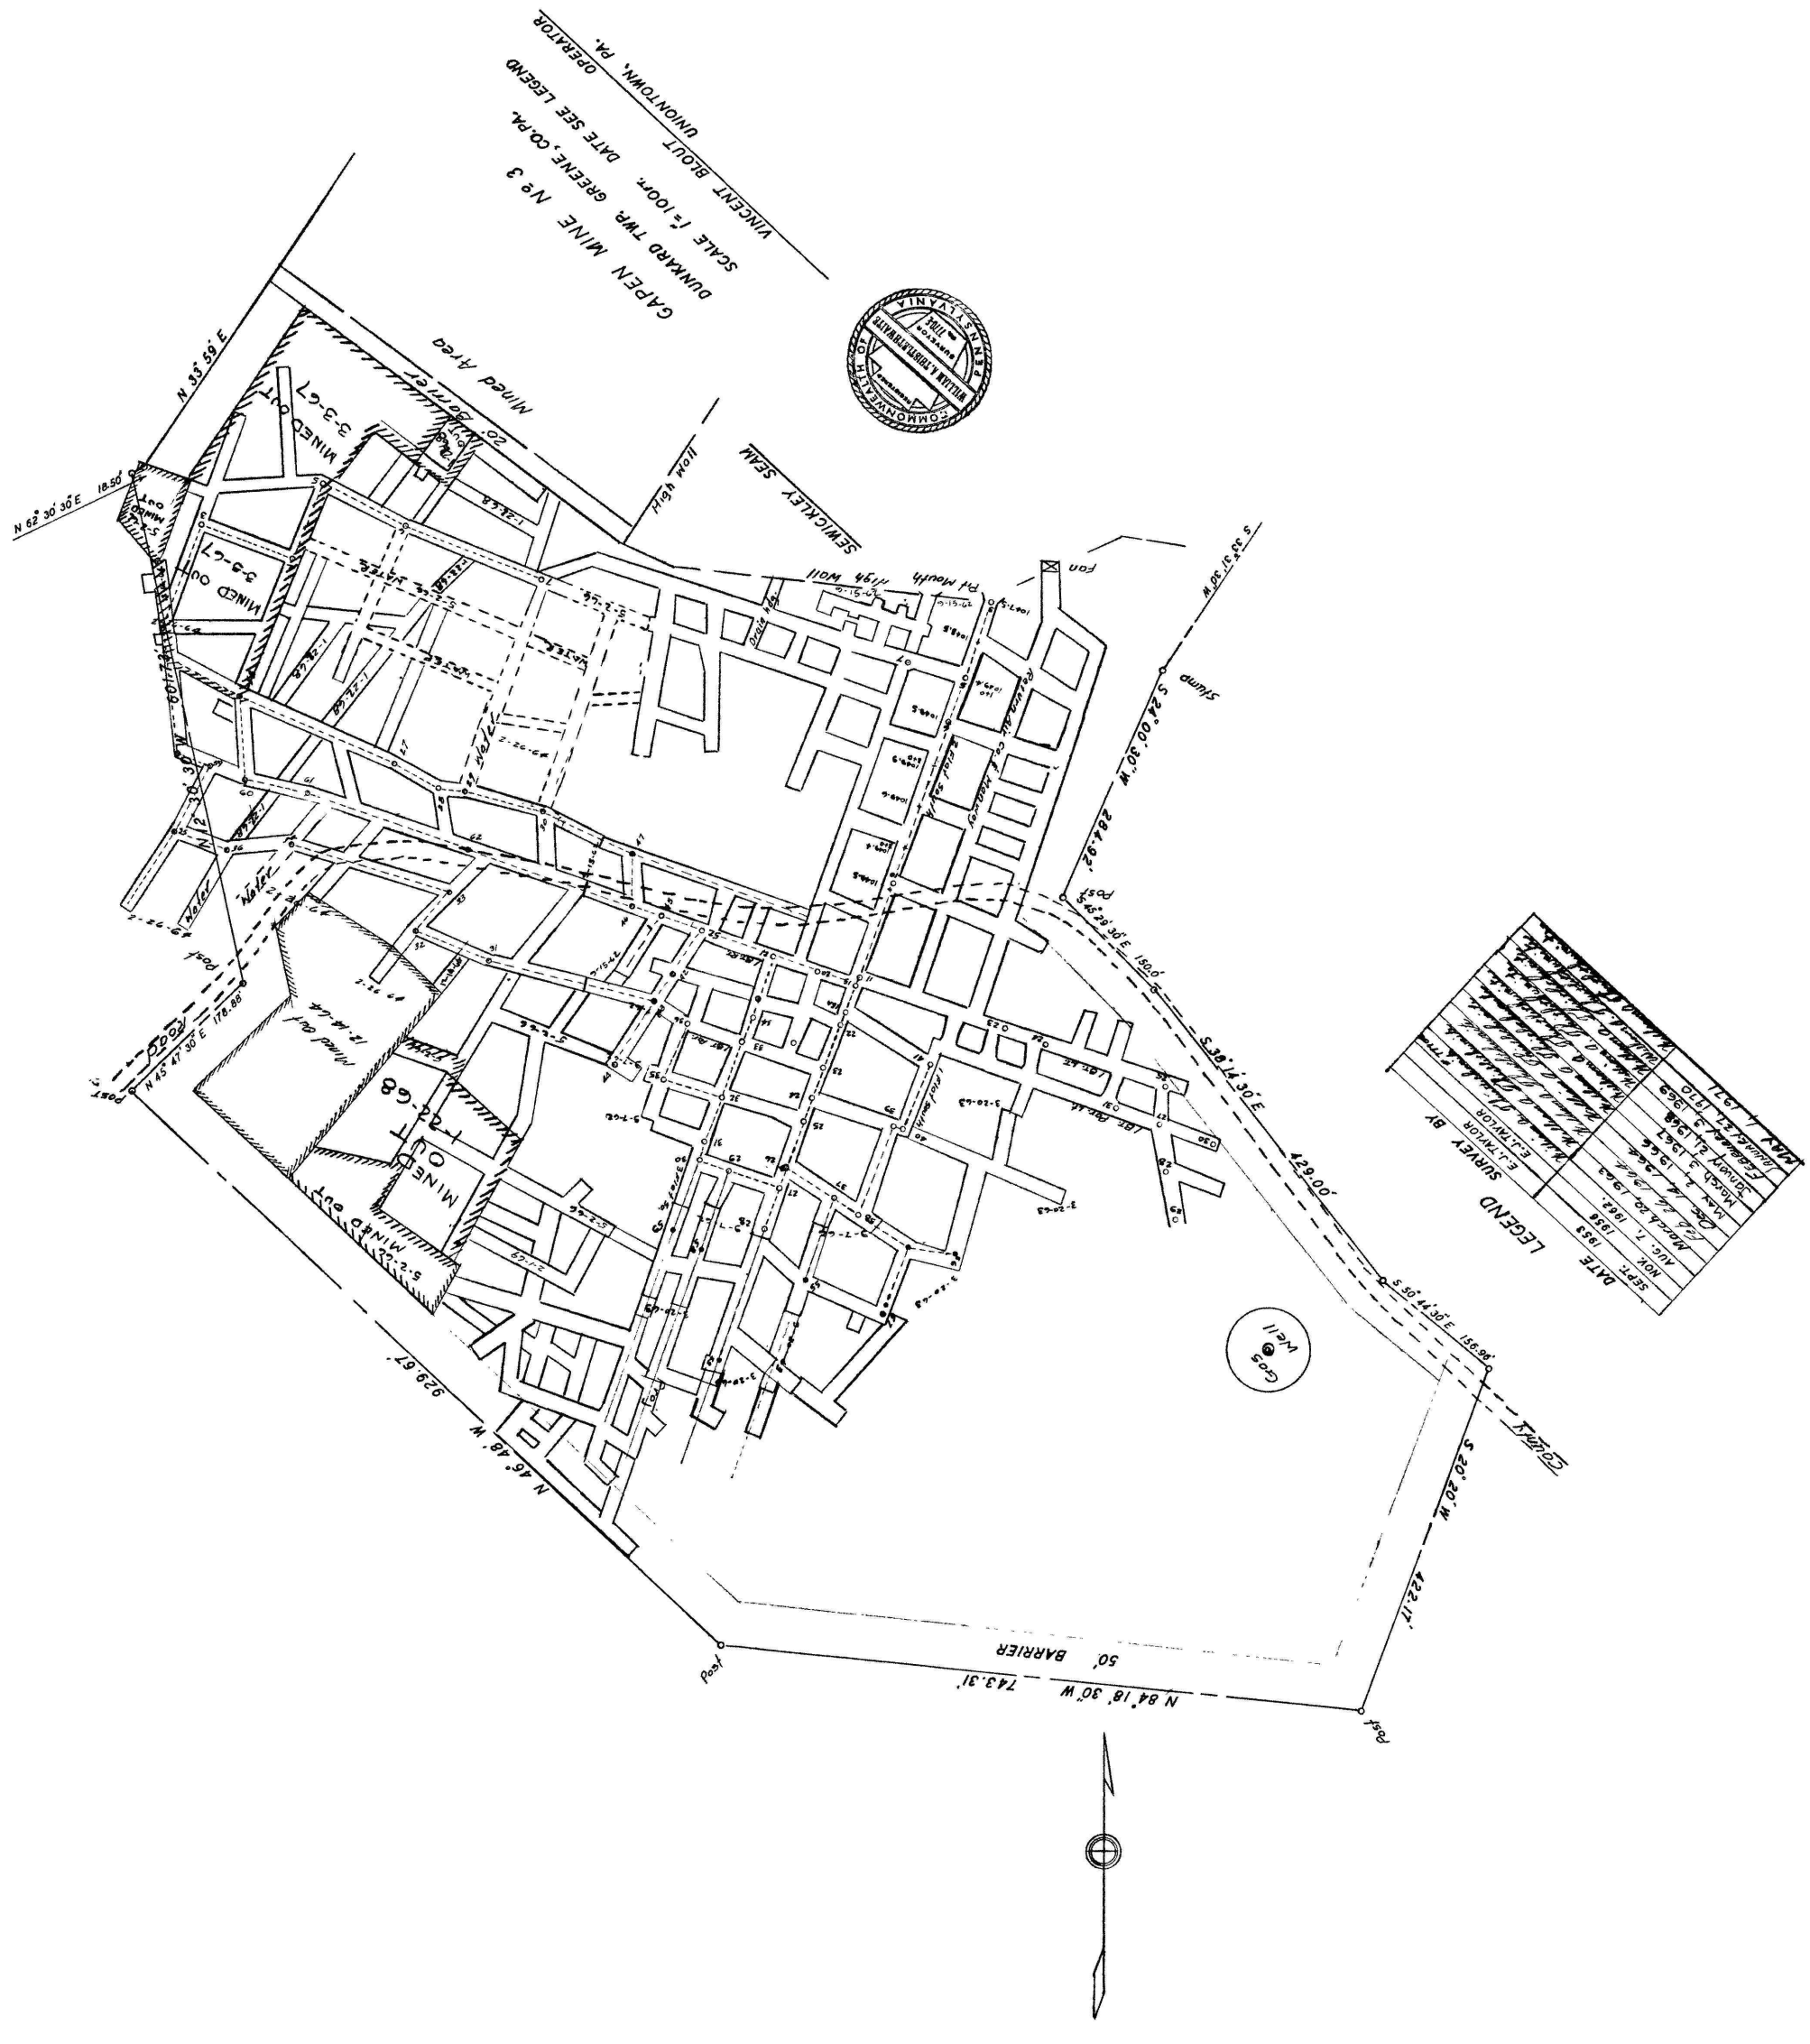
GAPEN MINE Nº 3
DUNKARD TWP. GREENE CO. PA.
SCALE 1"=100'. DATE SEE LEGEND
VINCENT BLOUT OPERATOR
UNIONTOWN, PA.
COMMONWEALTH OF PENNSYLVANIA
SEWICKLEY SEAM
Mined Area
20' Barrier
N 33° 59' E
N 62° 30' 30" E 18.50'
MINED OUT
3-3-67
MINED OUT
3-3-67
Water
Water
Water
Water
Post
N 45° 47' 30" E 178.88'
Mined out
12-14-66
MINED OUT
12-6-68
MINED OUT
5-2-66
Post
N 46° 18' W 929.67'
N 84° 18' 30" W 743.31'
50' BARRIER
Post
S 20° 20' W 422.17'
S 59° 14' 30" E 156.96'
Gas Well
S 59° 14' 30" E 429.00'
S 29° 29' 30" E 150.0'
Post
Post
S 24° 00' 30" W 284.92'
Stump
S 33° 31' 30" W
Pit Mouth
Fan
Post
Post
Post