



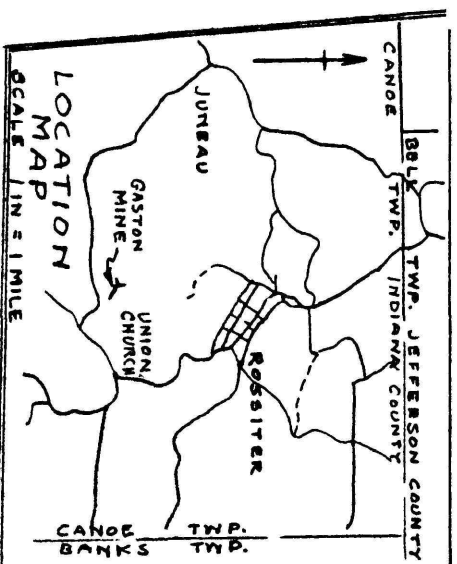

RACHEL BISHOP

CLARK SMITH

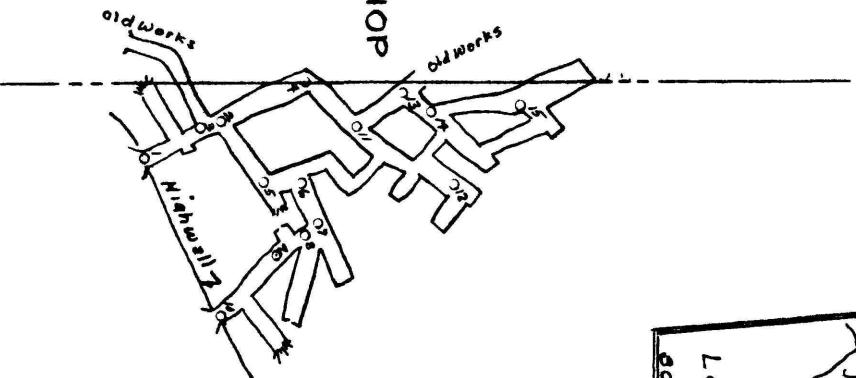

MINE MAP

GLENN GASTON

COAL MINE

12th District

Canoe Township, Indiana County, Pa.

Scale 1"=100' NOV. 3, 1958

Walter J. Zimmerman Surveyor Engineer Pottsville, Pa.