



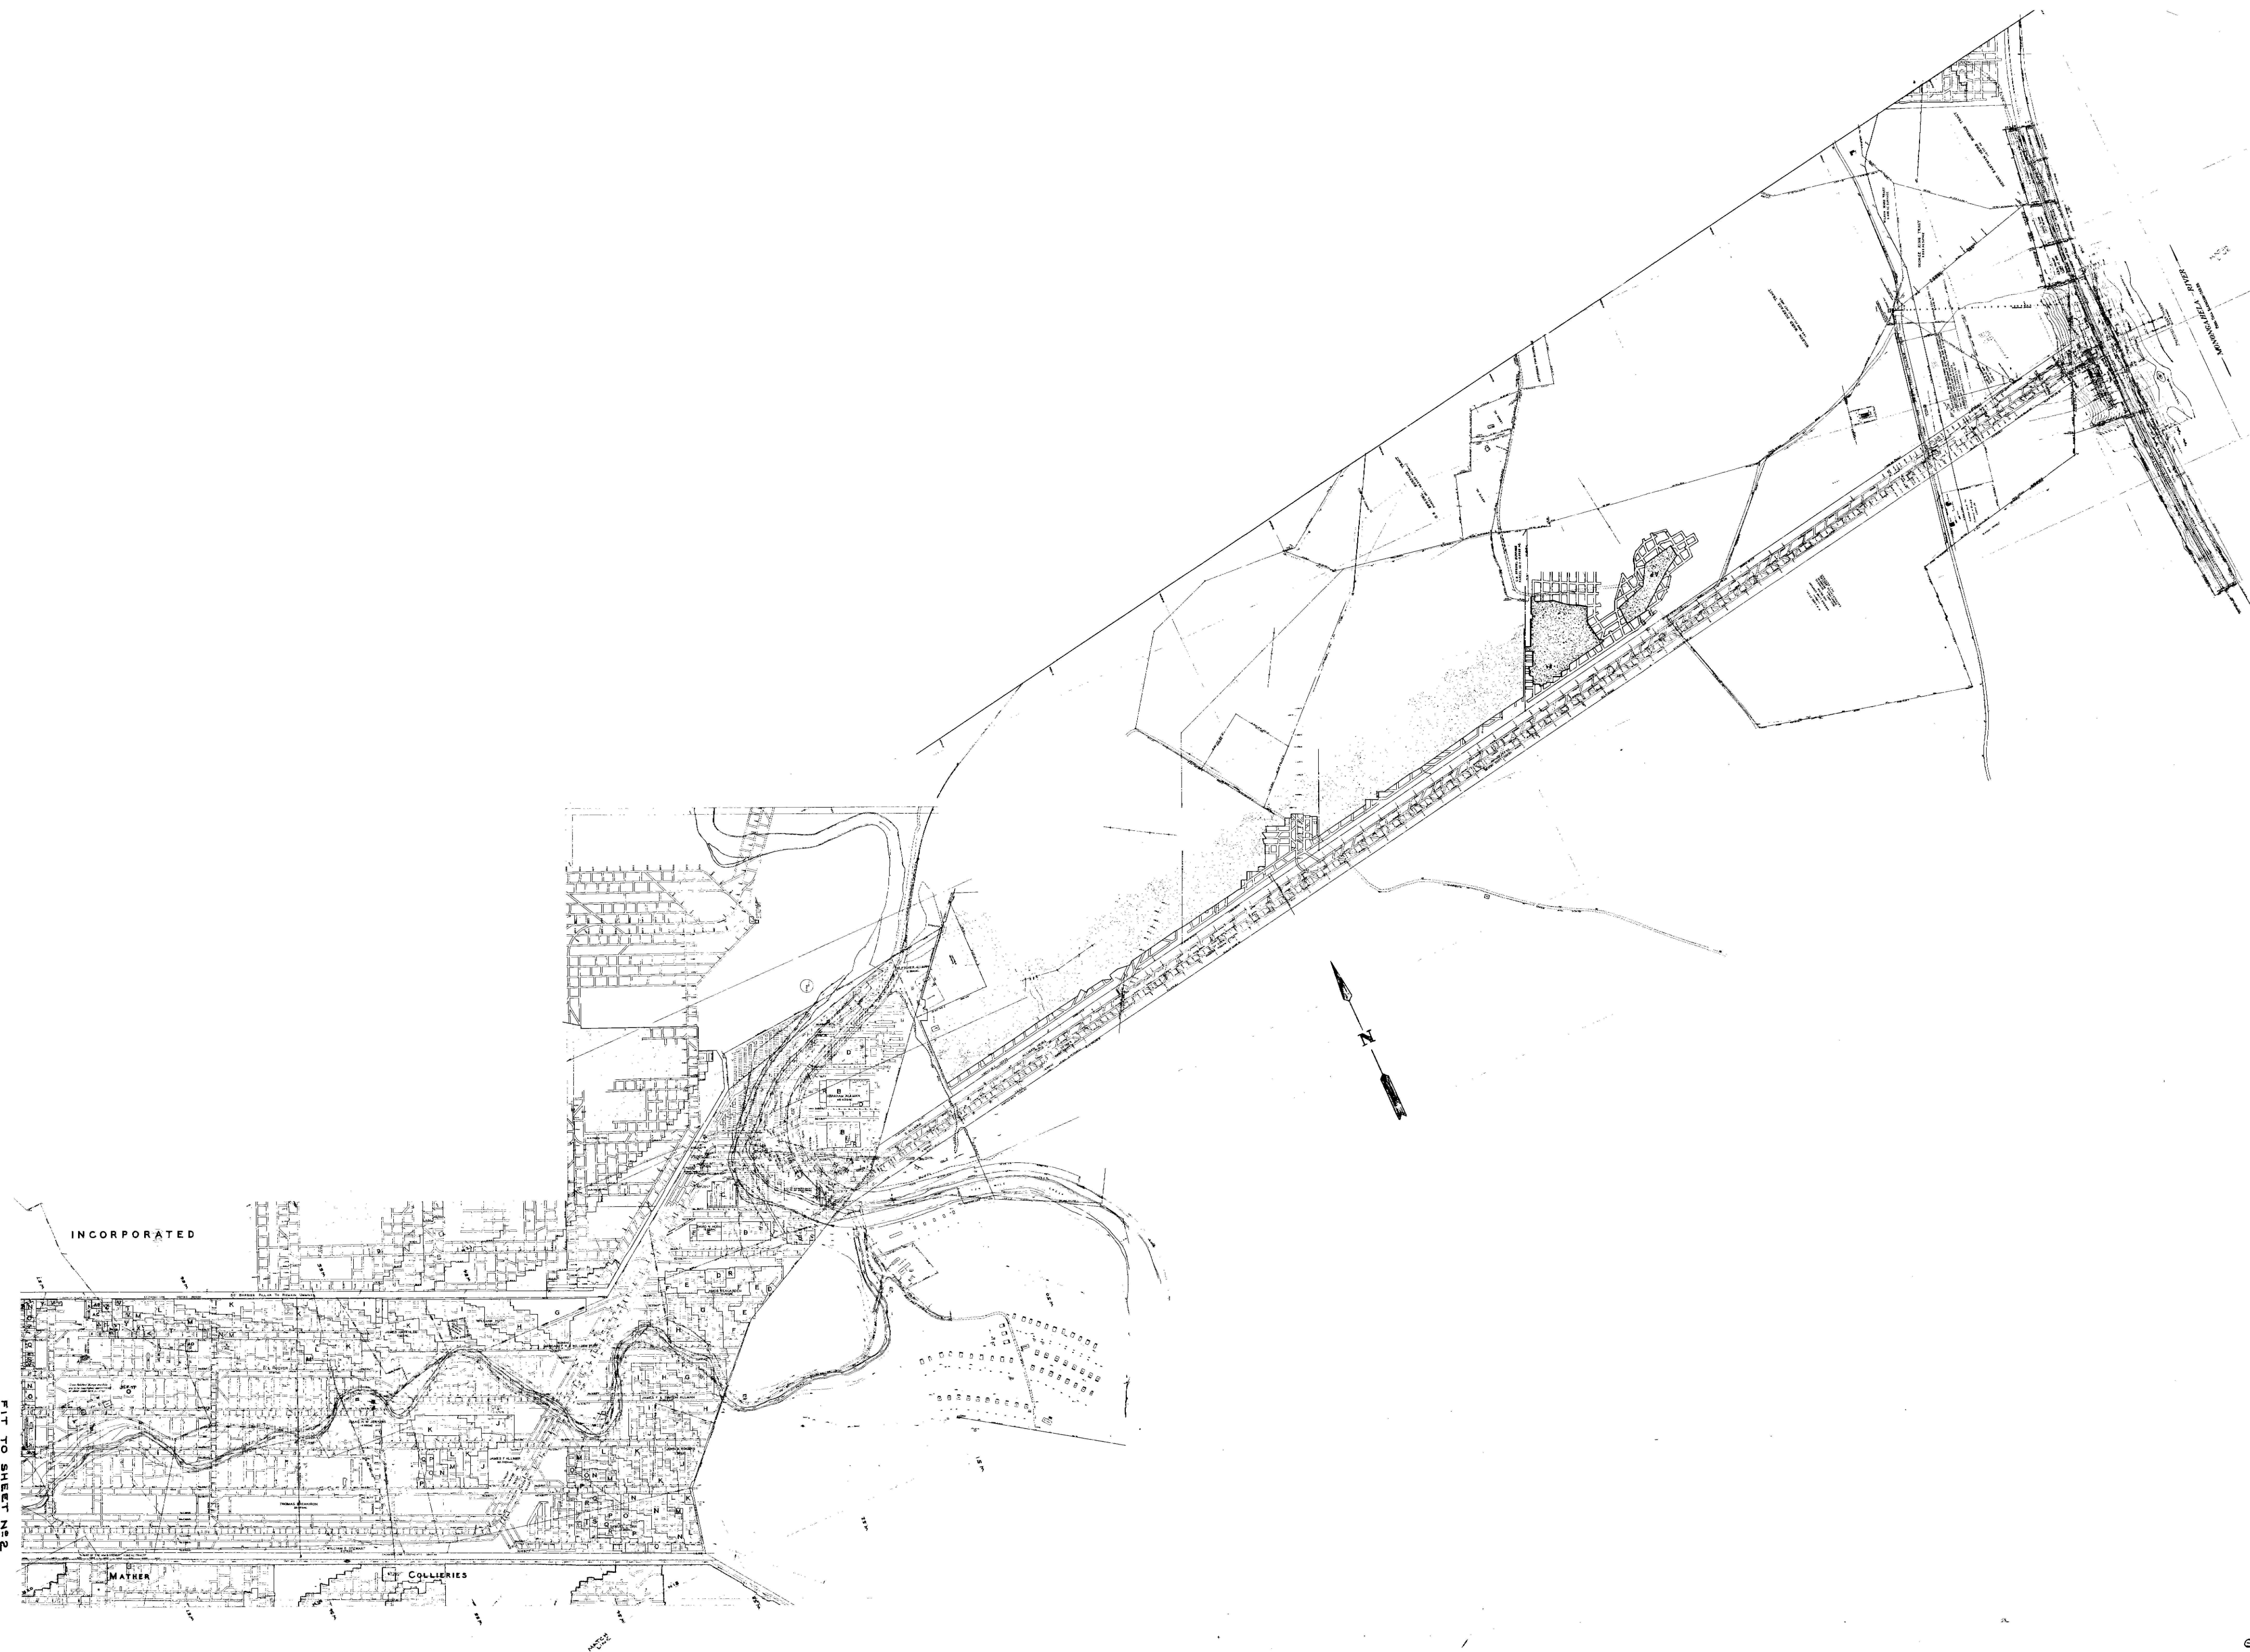

RECEIVED
JUL 31 1990
Dept. of Environmental Resources
McKurray District Office

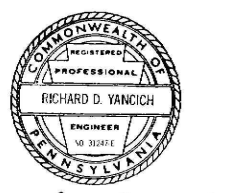

Richard D. Yancich
7-23-90

GATEWAY COAL COMPANY
GATEWAY MINE
1"=800'
FINAL MAP 7-31-90
SHEET No 1